




NOTES

1. CO-ORDINATES ARE IN TERMS OF NEW ZEALAND TRANSVERSE MERCATOR 2000 PROJECTION (NZTM2000).
2. HEIGHTS ARE IN TERMS OF NEW ZEALAND VERTICAL DATUM 2016 (NZVD2016).
3. AS-BUILT DATA CARRIED OUT BY MAUGERS CONTRACTING LTD AND SUPPLIED TO INOVO PROJECTS LTD.
4. ALL STORMWATER LATERALS ARE DN100 uPVC SN8.
5. PROPOSED BOUNDARIES ARE SUBJECT TO FINAL SURVEY.
6. EXISTING BOUNDARIES SOURCED FROM LINZ DATA SERVICE AND IS TO BE USED IN ACCORDANCE WITH THE INTERNATIONAL CREATIVE COMMONS LICENCE 4.0.
7. ALL DIMENSIONS ARE IN METRES UNLESS STATED.

LEGEND

- SITE BOUNDARIES
- STORMWATER MAIN
- STORMWATER LATERAL
- STREET LIGHT

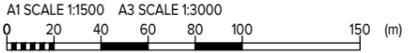

Rev#	Description	Drawn	Date
0	FOR AS-BUILT	IAMcC	28.08.25



Level 1, 93 Manchester St, Christchurch 8022
 Ph. 03 377 3290
 Level 1, Shed 19, Princess Wharf, Auckland 1010
 Ph. 09 600 1099
 www.inovo.nz

Scale A1
1:1,500
Scale A3
1:3,000
DO NOT SCALE FROM DRAWING


Drawn
AMcC
Approved
TMcL
Date
28.08.25



Project
**EARLSBROOK
RESIDENTIAL SUBDIVISION
STAGE 1**


Drawing Title
**STORMWATER AS-BUILT
STAGE 1
SHEET 1**

Status
**AS-BUILT
AUG 2025**
Drawing No.
15721-S1-AB-4000 Rev
0

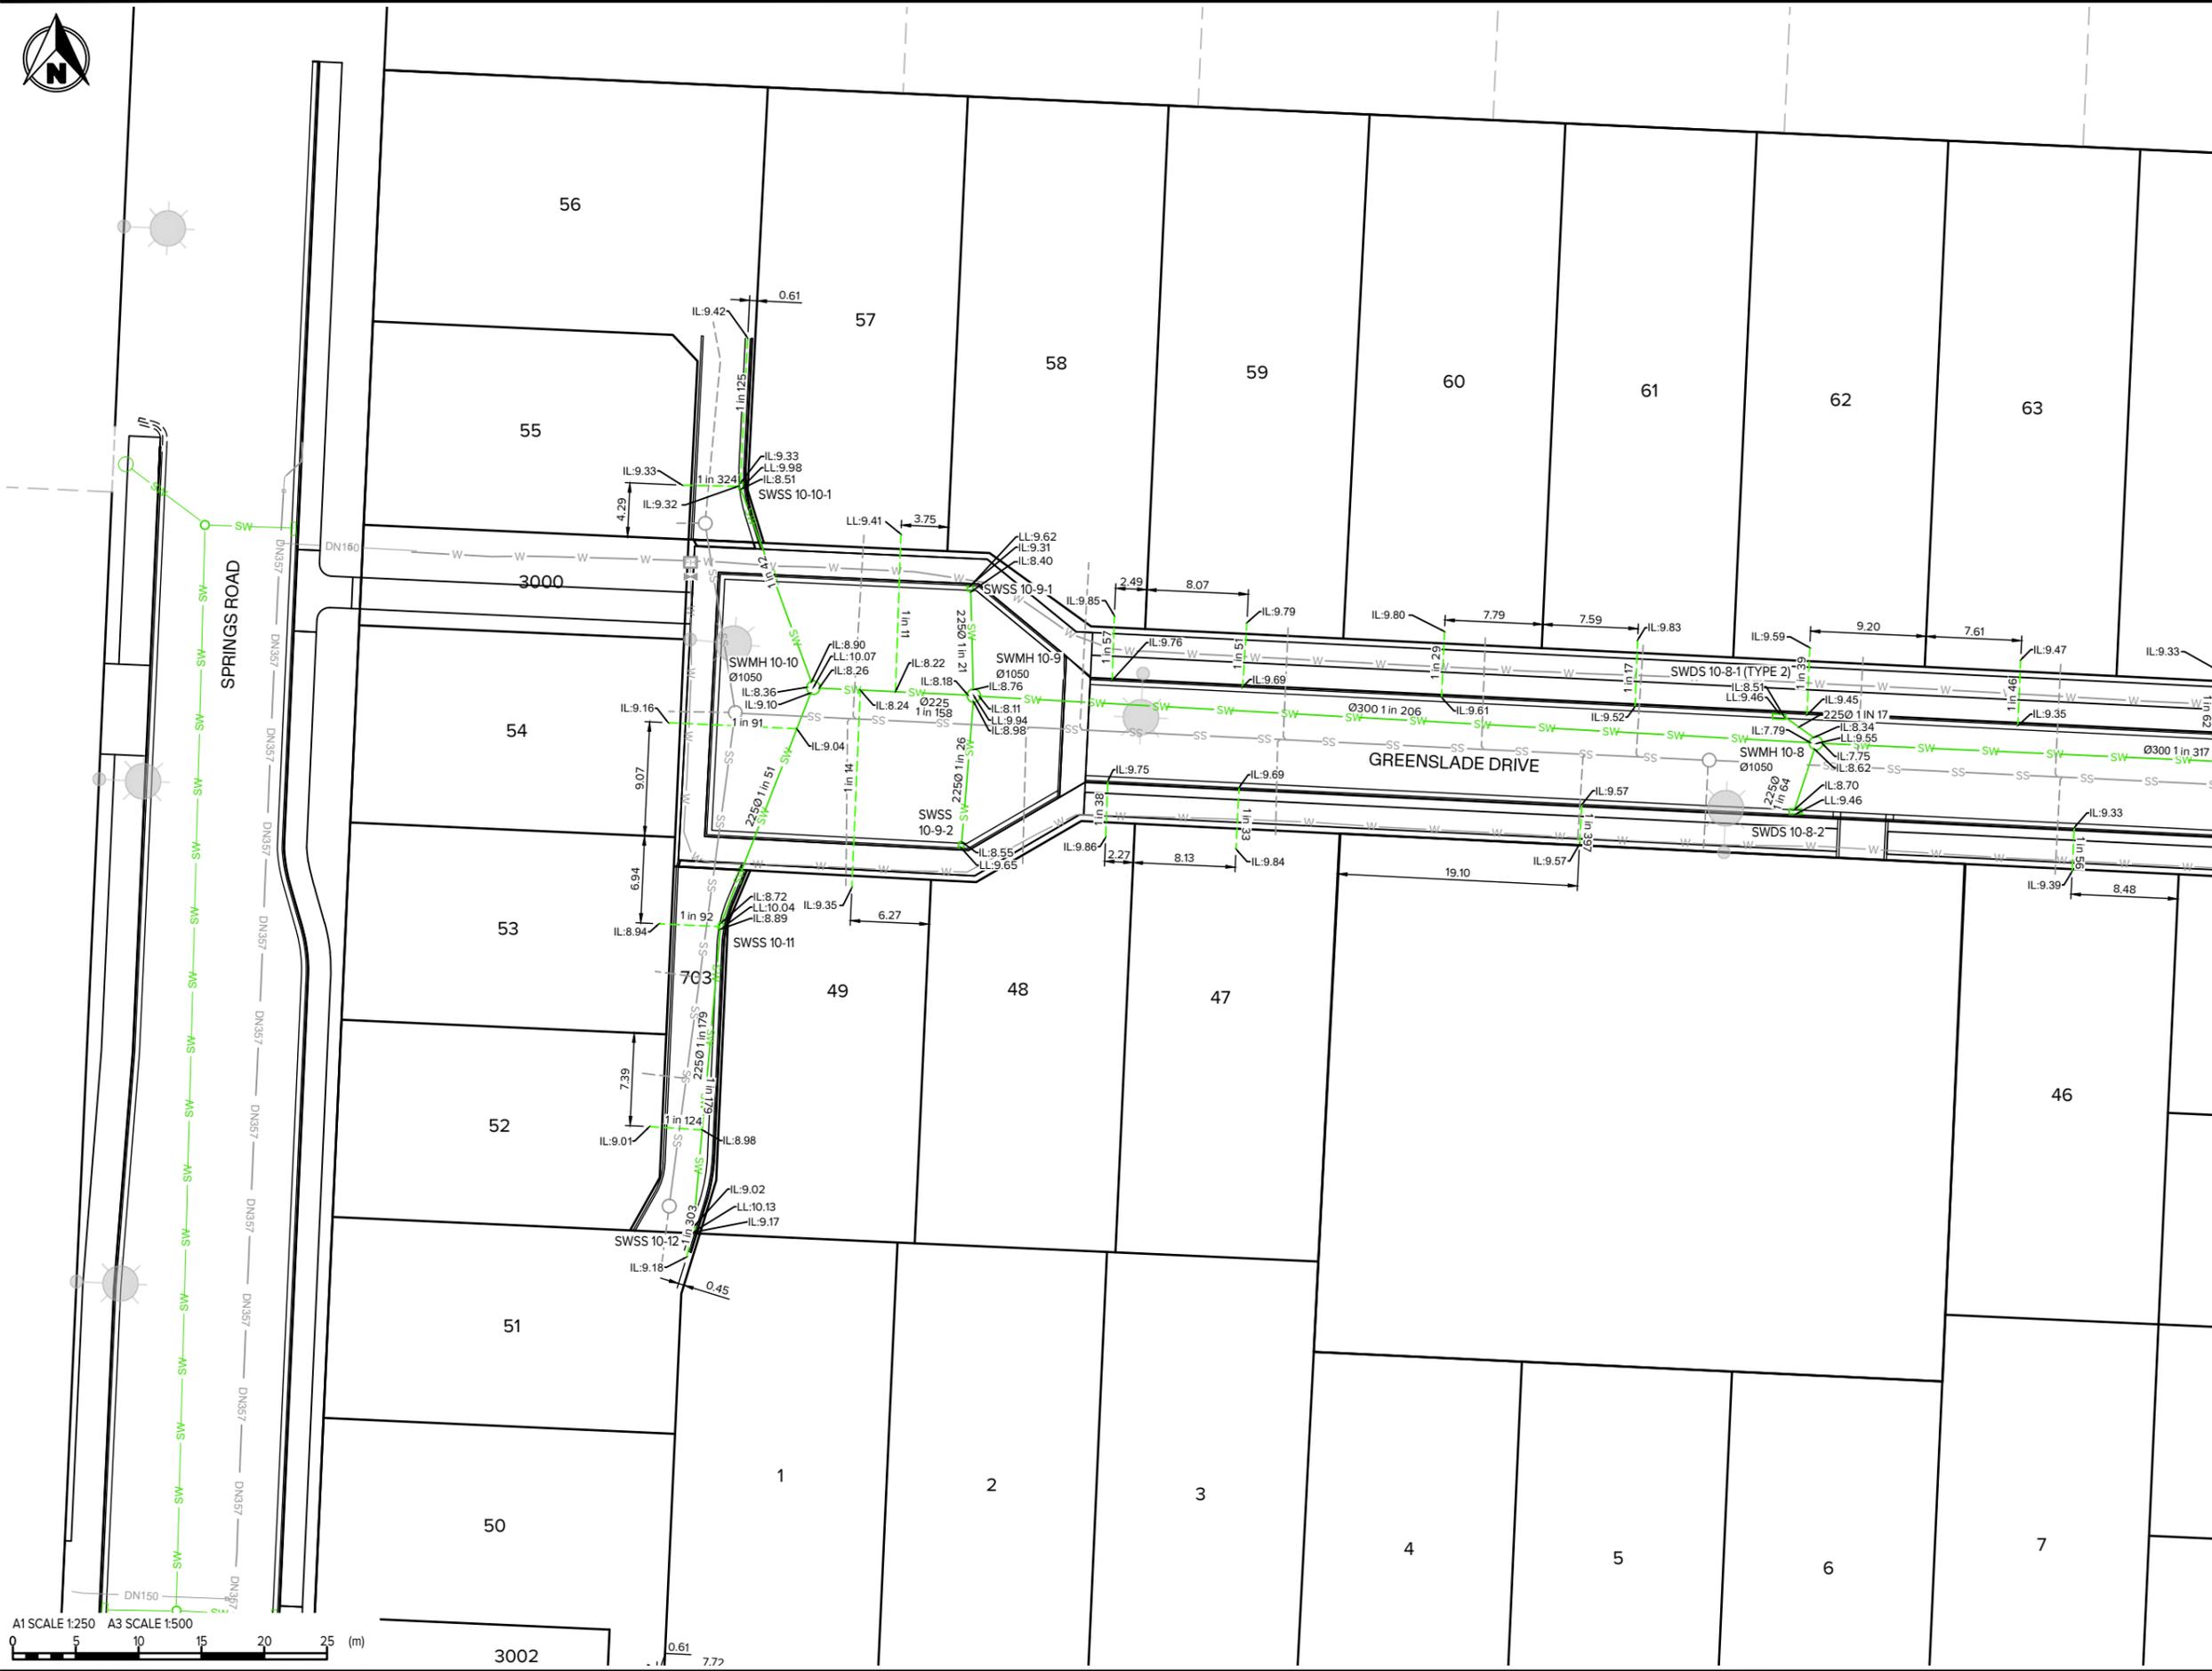

- NOTES**
1. CO-ORDINATES ARE IN TERMS OF NEW ZEALAND TRANSVERSE MERCATOR 2000 PROJECTION (NZTM2000).
 2. HEIGHTS ARE IN TERMS OF NEW ZEALAND VERTICAL DATUM 2016 (NZVD2016).
 3. AS-BUILT DATA CARRIED OUT BY MAUGERS CONTRACTING LTD AND SUPPLIED TO INOVO PROJECTS LTD.
 4. ALL STORMWATER LATERALS ARE DN100 uPVC SN8.
 5. PROPOSED BOUNDARIES ARE SUBJECT TO FINAL SURVEY.
 6. EXISTING BOUNDARIES SOURCED FROM LINZ DATA SERVICE AND IS TO BE USED IN ACCORDANCE WITH THE INTERNATIONAL CREATIVE COMMONS LICENCE 4.0.
 7. ALL DIMENSIONS ARE IN METRES UNLESS STATED.

- LEGEND**
- - - - - SITE BOUNDARIES
 - SW — SW STORMWATER MAIN
 - - - - - STORMWATER LATERAL
 - ★ STREET LIGHT

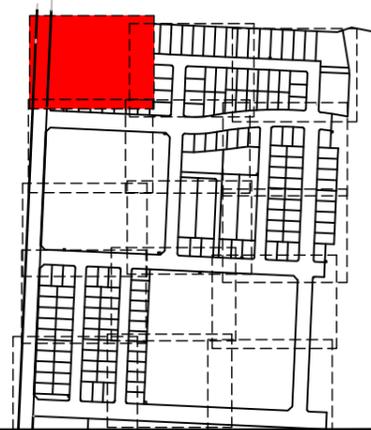

Rev#	Description	Drawn	Date

INOVO
 Level 1, 93 Manchester St, Christchurch 8022
 Ph. 03 377 3290
 Level 1, Shed 19, Princess Wharf, Auckland 1010
 Ph. 09 600 1099
 www.inovo.nz

Scale A1
1:250
 Scale A3
1:500
 DO NOT SCALE FROM DRAWING

Drawn
AMcC
 Approved
TMCL
 Date
28.08.25

Client
EARLSBROOK
LINCOLN

Project
EARLSBROOK RESIDENTIAL SUBDIVISION STAGE 1

Drawing Title
STORMWATER AS-BUILT STAGE 1 SHEET 2


Status
AS-BUILT
AUG 2025

Drawing No.
15721-S1-AB-4001

Rev
0



- NOTES**
1. CO-ORDINATES ARE IN TERMS OF NEW ZEALAND TRANSVERSE MERCATOR 2000 PROJECTION (NZTM2000).
 2. HEIGHTS ARE IN TERMS OF NEW ZEALAND VERTICAL DATUM 2016 (NZVD2016).
 3. AS-BUILT DATA CARRIED OUT BY MAUGERS CONTRACTING LTD AND SUPPLIED TO INOVO PROJECTS LTD.
 4. ALL STORMWATER LATERALS ARE DN100 uPVC SN8.
 5. PROPOSED BOUNDARIES ARE SUBJECT TO FINAL SURVEY.
 6. EXISTING BOUNDARIES SOURCED FROM LINZ DATA SERVICE AND IS TO BE USED IN ACCORDANCE WITH THE INTERNATIONAL CREATIVE COMMONS LICENCE 4.0.
 7. ALL DIMENSIONS ARE IN METRES UNLESS STATED.

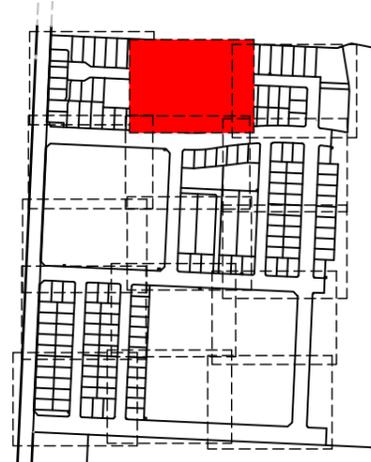

Rev#	Description	Drawn	Date
0	FOR AS-BUILT	AMcC	28.08.25

INOVO
 Level 1, 93 Manchester St, Christchurch 8022
 Ph. 03 377 3290
 Level 1, Shed 19, Princess Wharf, Auckland 1010
 Ph. 09 600 1099
 www.inovo.nz

Scale A1
1:250
Scale A3
1:500
DO NOT SCALE FROM DRAWING

Drawn
AMcC
Approved
TMCL
Date
28.08.25

Client
EARLSBROOK LINCOLN


Project
EARLSBROOK RESIDENTIAL SUBDIVISION STAGE 1

Drawing Title
STORMWATER AS-BUILT STAGE 1 SHEET 3

Status
AS-BUILT AUG 2025

Drawing No.
15721-S1-AB-4002

Rev
0

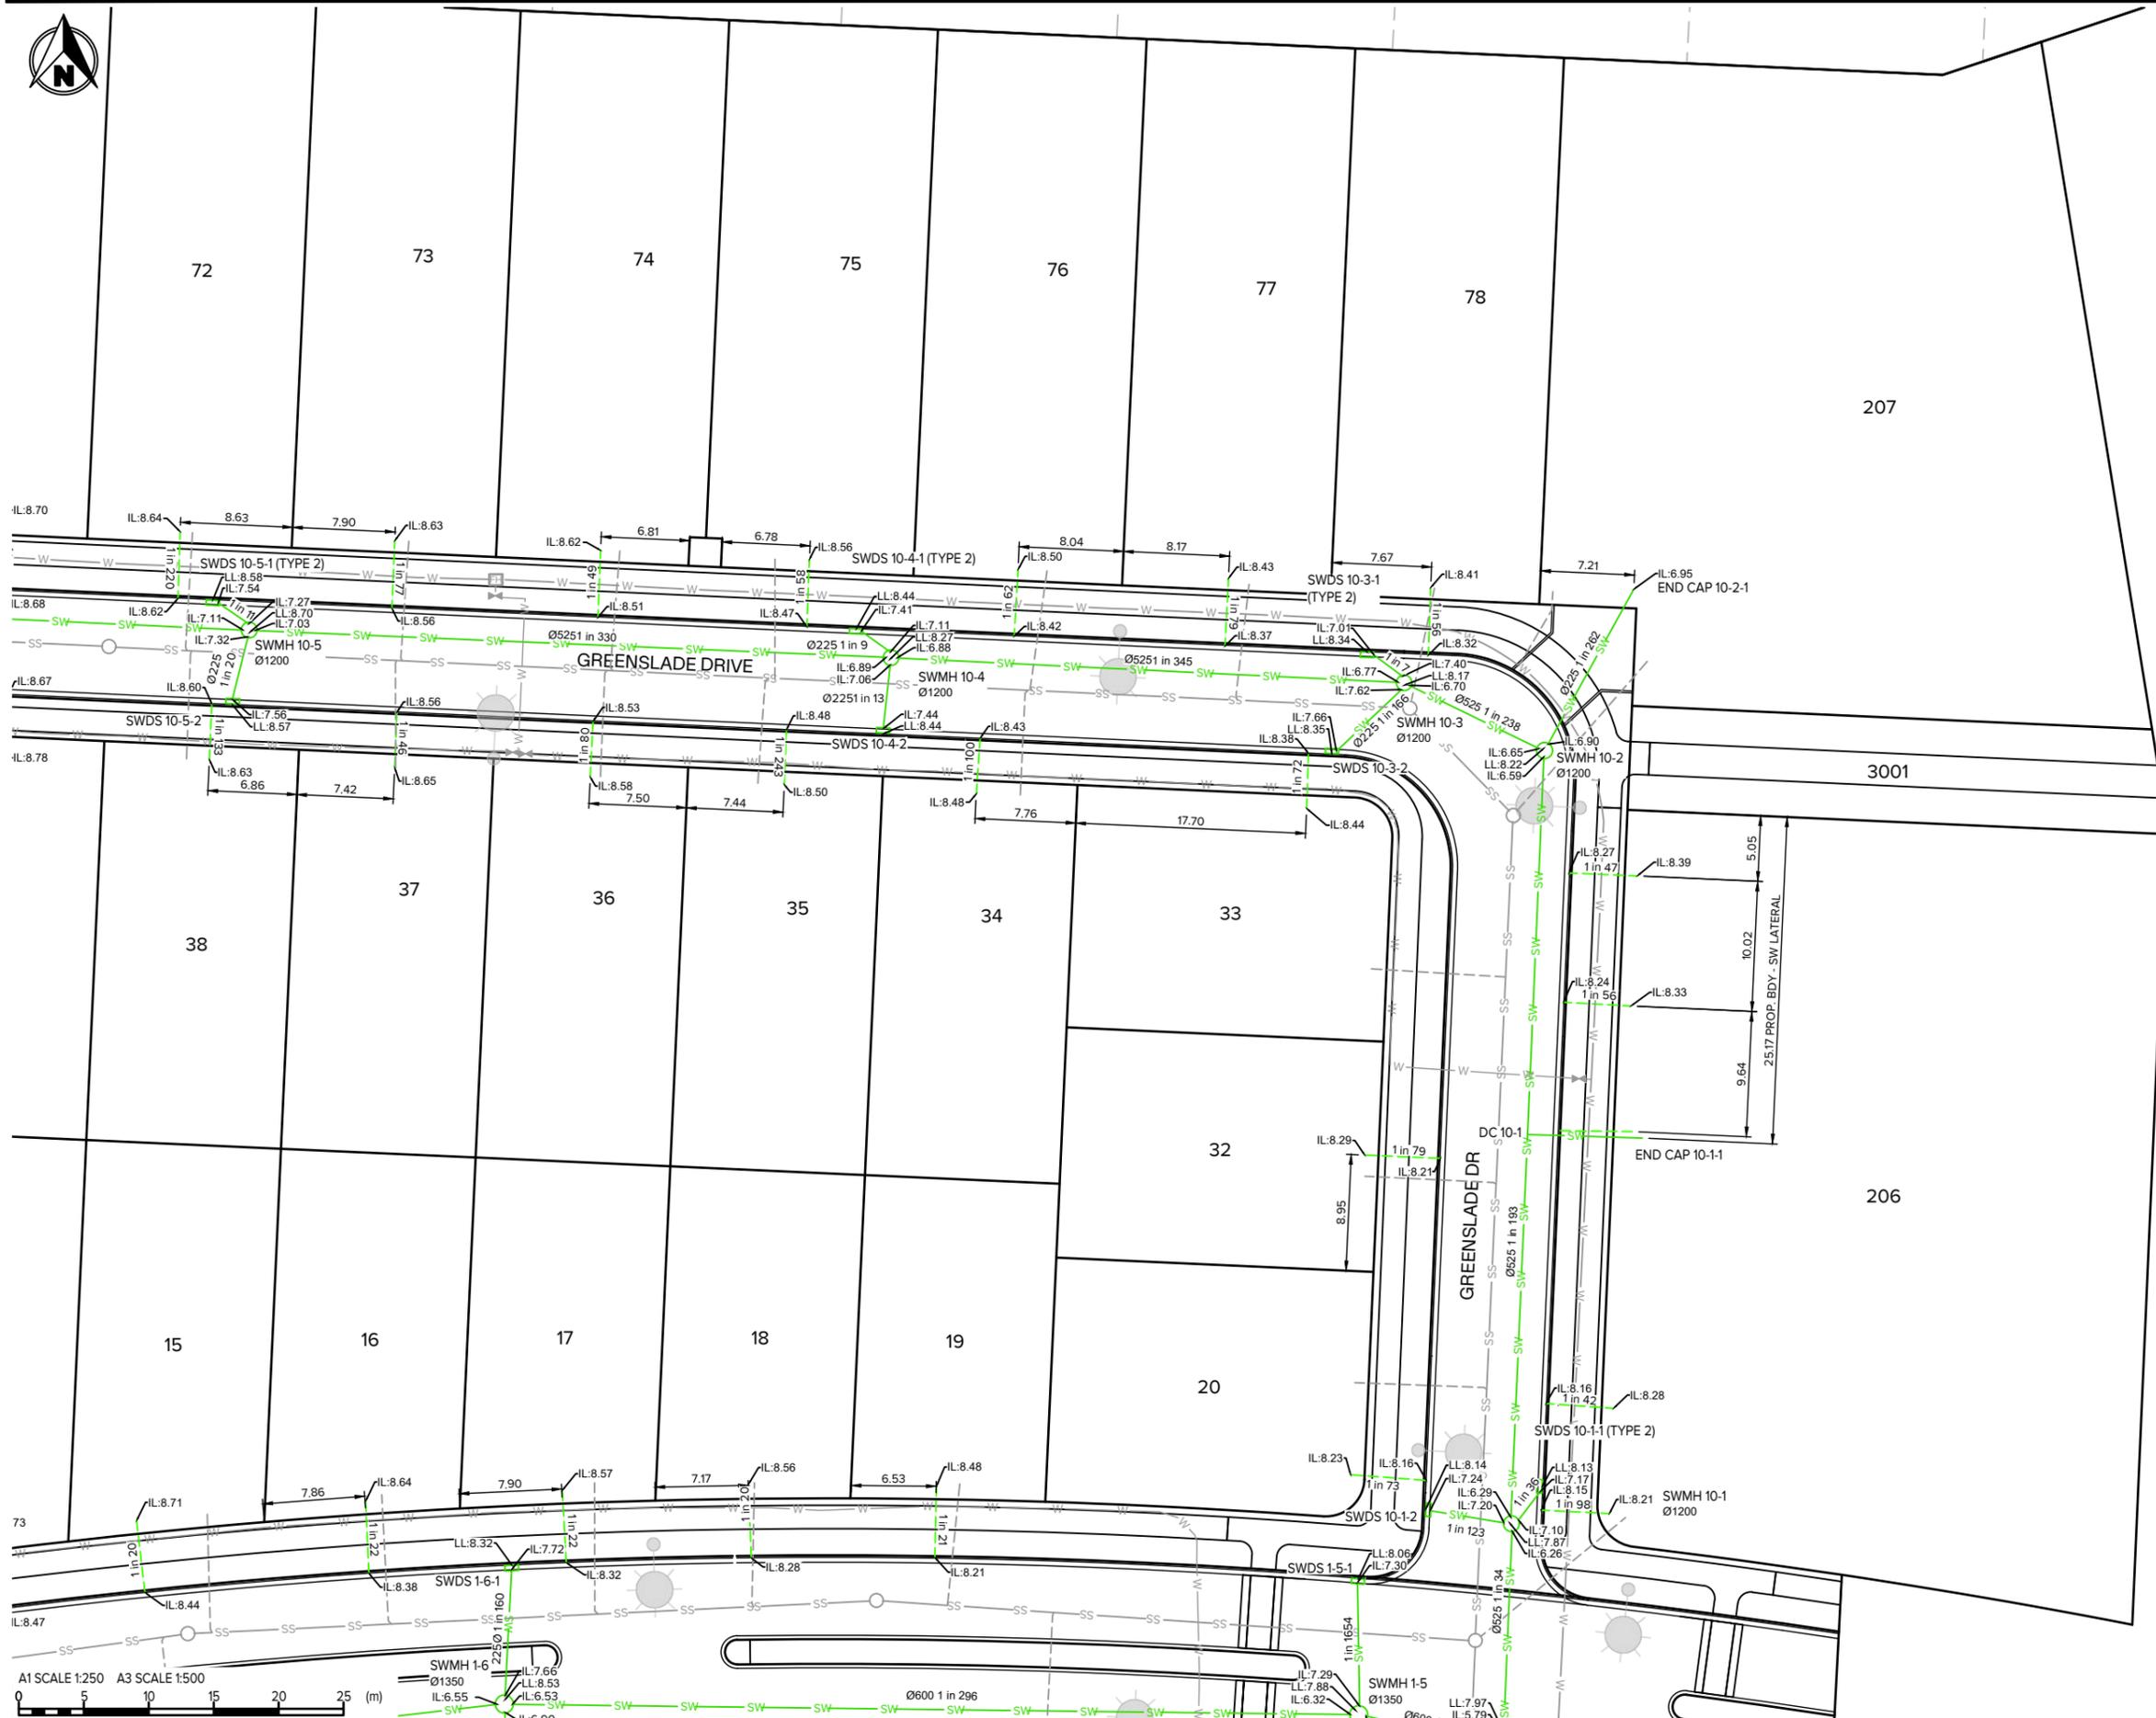

- NOTES**
1. CO-ORDINATES ARE IN TERMS OF NEW ZEALAND TRANSVERSE MERCATOR 2000 PROJECTION (NZTM2000).
 2. HEIGHTS ARE IN TERMS OF NEW ZEALAND VERTICAL DATUM 2016 (NZVD2016).
 3. AS-BUILT DATA CARRIED OUT BY MAUGERS CONTRACTING LTD AND SUPPLIED TO INOVO PROJECTS LTD.
 4. ALL STORMWATER LATERALS ARE DN100 uPVC SN8.
 5. PROPOSED BOUNDARIES ARE SUBJECT TO FINAL SURVEY.
 6. EXISTING BOUNDARIES SOURCED FROM LINZ DATA SERVICE AND IS TO BE USED IN ACCORDANCE WITH THE INTERNATIONAL CREATIVE COMMONS LICENCE 4.0.
 7. ALL DIMENSIONS ARE IN METRES UNLESS STATED.



Rev#	Description	Drawn	Date

INOVO
 Level 1, 93 Manchester St, Christchurch 8022
 Ph. 03 377 3290
 Level 1, Shed 19, Princess Wharf, Auckland 1010
 Ph. 09 600 1099
 www.inovo.nz

Scale A1
1:250
Scale A3
1:500
DO NOT SCALE FROM DRAWING

Drawn
AMcC
Approved
TMCL
Date
28.08.25

Client
EARLSBROOK
LINCOLN


Project
EARLSBROOK
RESIDENTIAL SUBDIVISION
STAGE 1


Drawing Title
STORMWATER AS-BUILT
STAGE 1
SHEET 4

Status
AS-BUILT
AUG 2025

Drawing No.
15721-S1-AB-4003


Rev
0

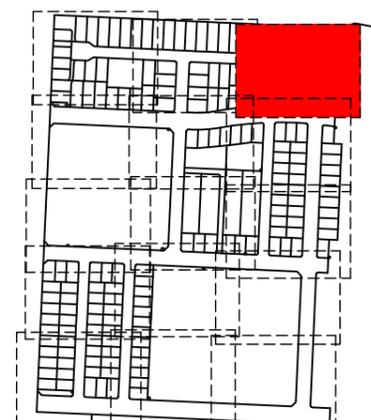

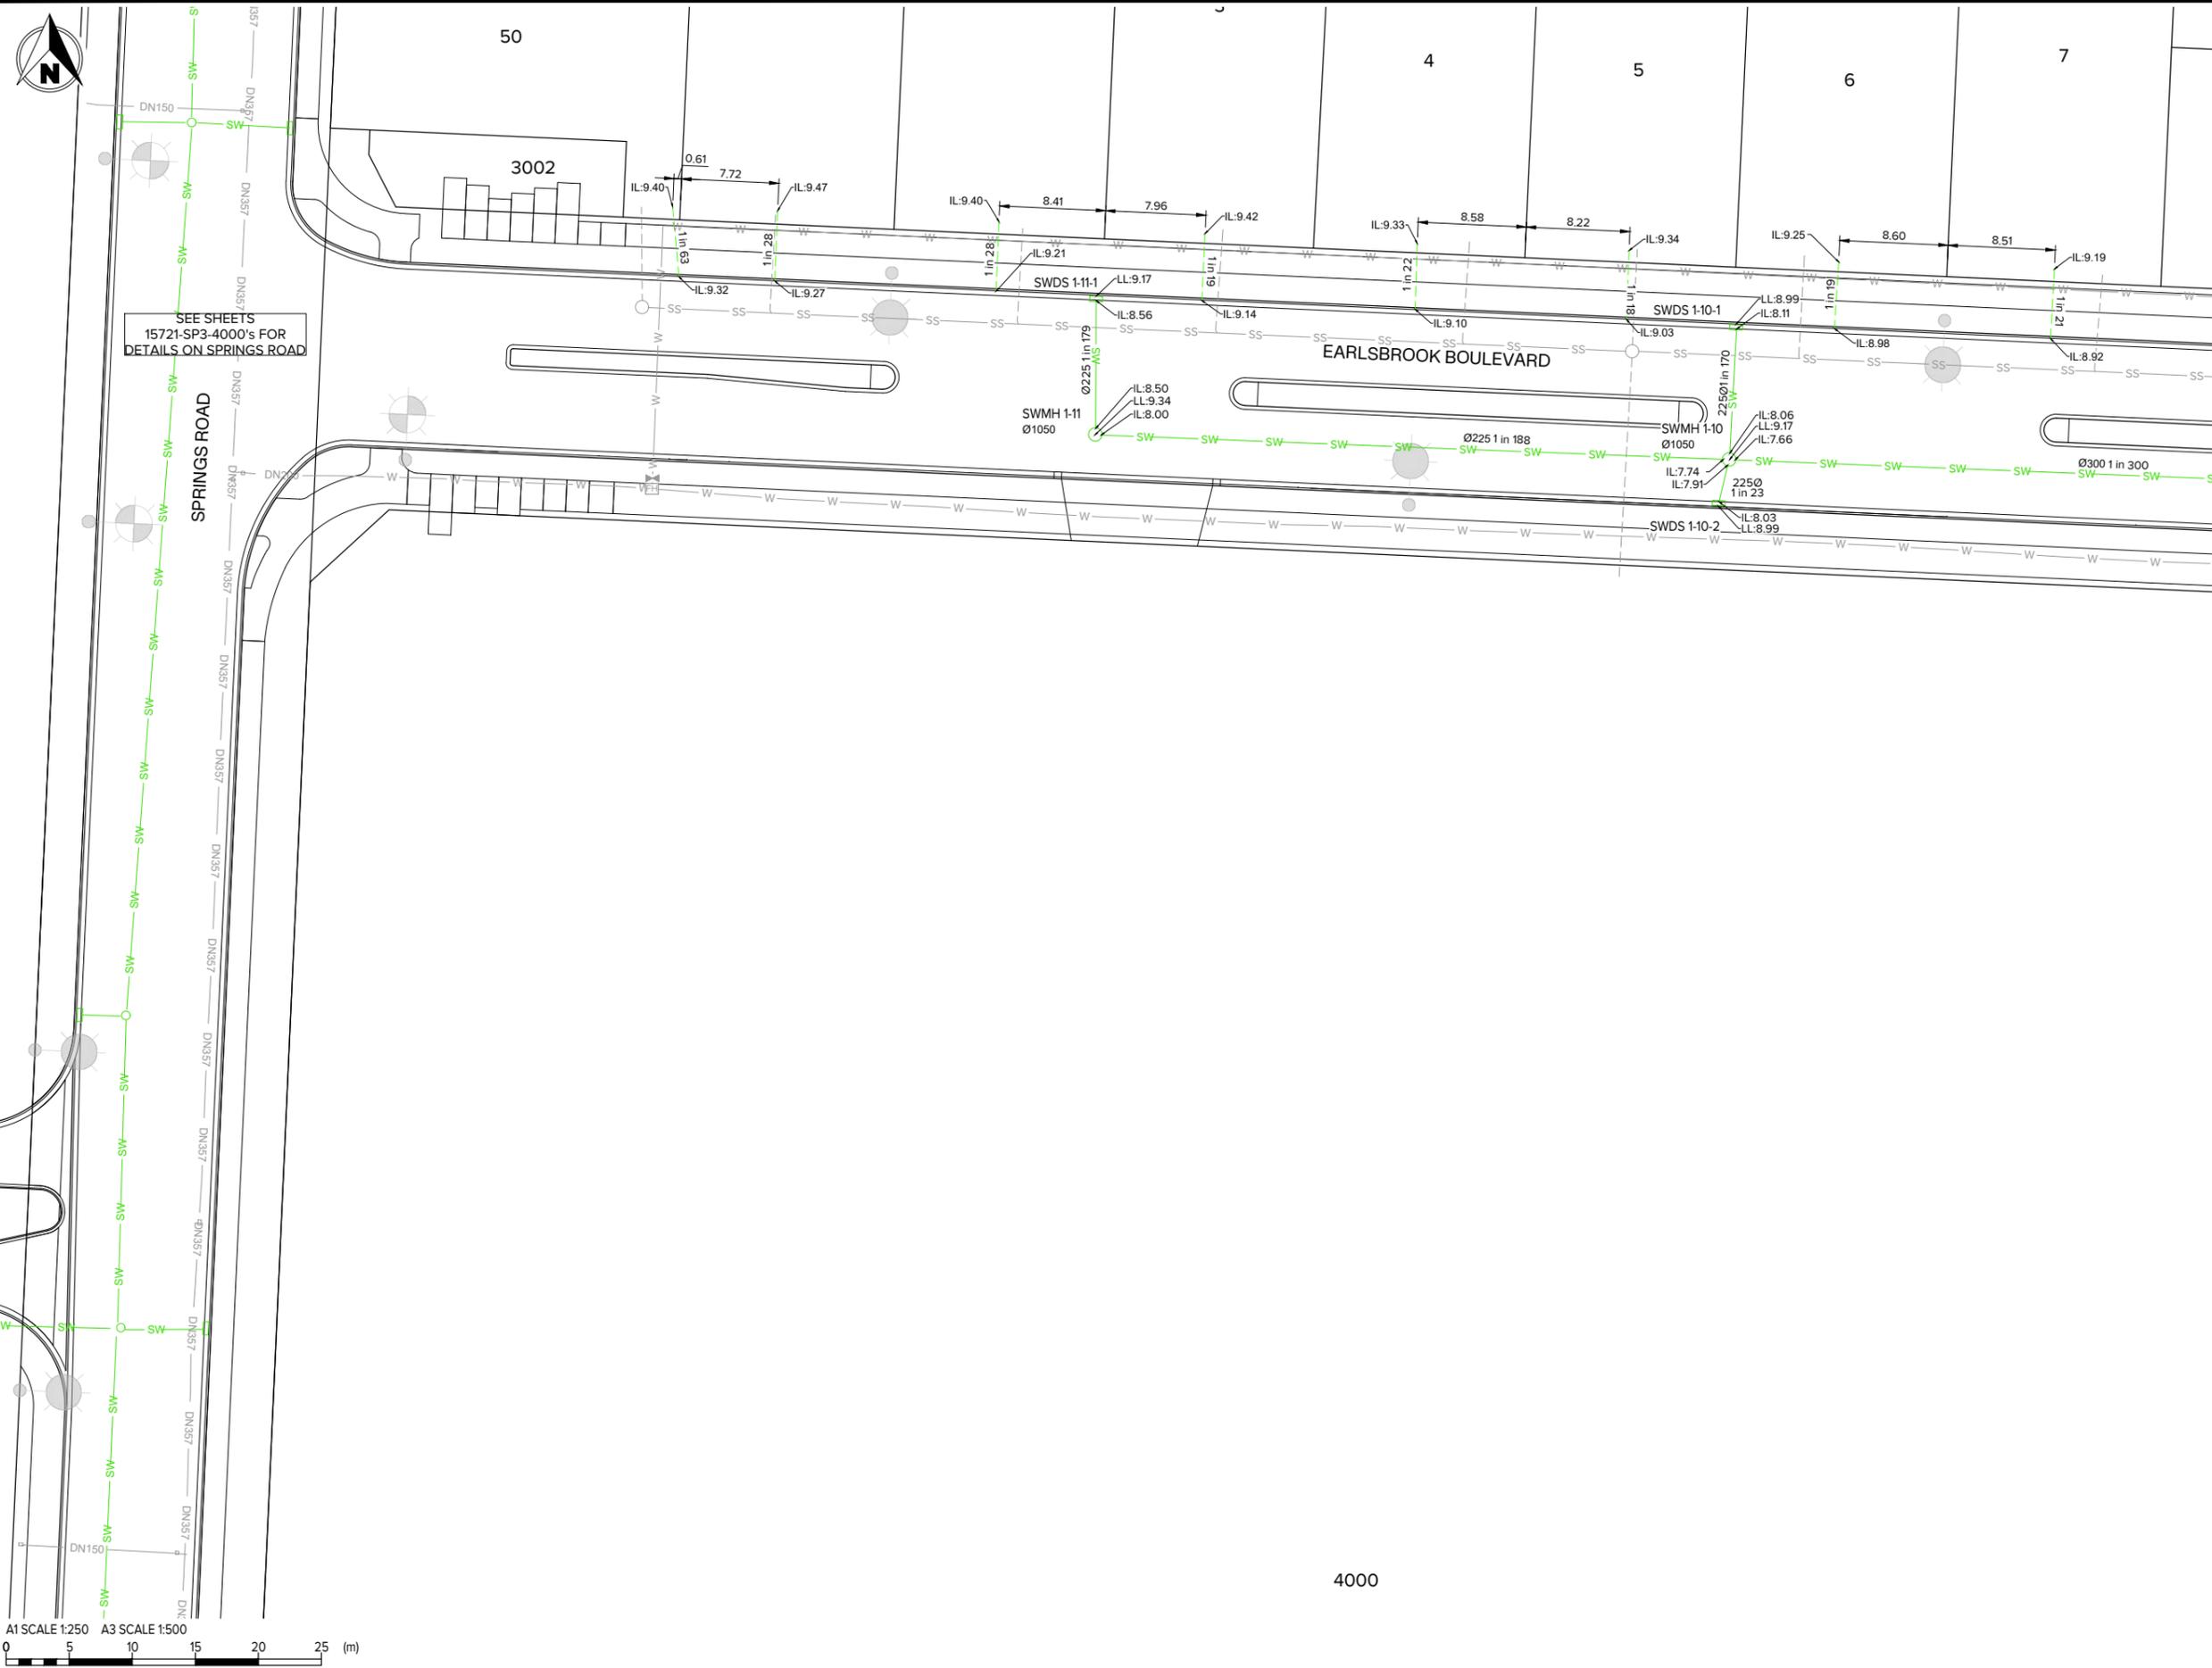

- NOTES**
1. CO-ORDINATES ARE IN TERMS OF NEW ZEALAND TRANSVERSE MERCATOR 2000 PROJECTION (NZTM2000).
 2. HEIGHTS ARE IN TERMS OF NEW ZEALAND VERTICAL DATUM 2016 (NZVD2016).
 3. AS-BUILT DATA CARRIED OUT BY MAUGERS CONTRACTING LTD AND SUPPLIED TO INOVO PROJECTS LTD.
 4. ALL STORMWATER LATERALS ARE DN100 uPVC SN8.
 5. PROPOSED BOUNDARIES ARE SUBJECT TO FINAL SURVEY.
 6. EXISTING BOUNDARIES SOURCED FROM LINZ DATA SERVICE AND IS TO BE USED IN ACCORDANCE WITH THE INTERNATIONAL CREATIVE COMMONS LICENCE 4.0.
 7. ALL DIMENSIONS ARE IN METRES UNLESS STATED.

- LEGEND**
- - - - - SITE BOUNDARIES
 - SW — SW STORMWATER MAIN
 - - - - - STORMWATER LATERAL
 - STREET LIGHT

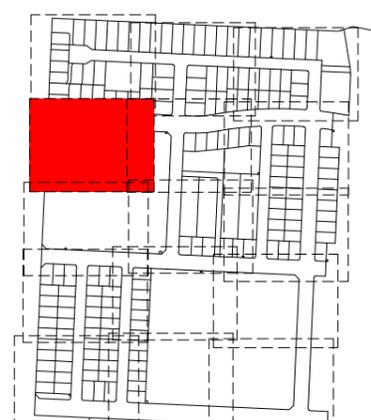

A1 SCALE 1:250 A3 SCALE 1:500
 0 5 10 15 20 25 (m)

Rev#	Description	Drawn	Date
0	FOR AS-BUILT		

INOVO
 Level 1, 93 Manchester St, Christchurch 8022
 Ph. 03 377 3290
 Level 1, Shed 19, Princess Wharf, Auckland 1010
 Ph. 09 600 1099
 www.inovo.nz

Scale A1
1:250
 Scale A3
1:500
 DO NOT SCALE FROM DRAWING

Drawn
AMcC
 Approved
TMcL
 Date
28.08.25

Client
EARLSBROOK
 LINCOLN


Project
EARLSBROOK
RESIDENTIAL SUBDIVISION
STAGE 1

Drawing Title
STORMWATER AS-BUILT
STAGE 1
SHEET 5


Status
AS-BUILT
AUG 2025

Drawing No.
15721-S1-AB-4004

Rev
 0

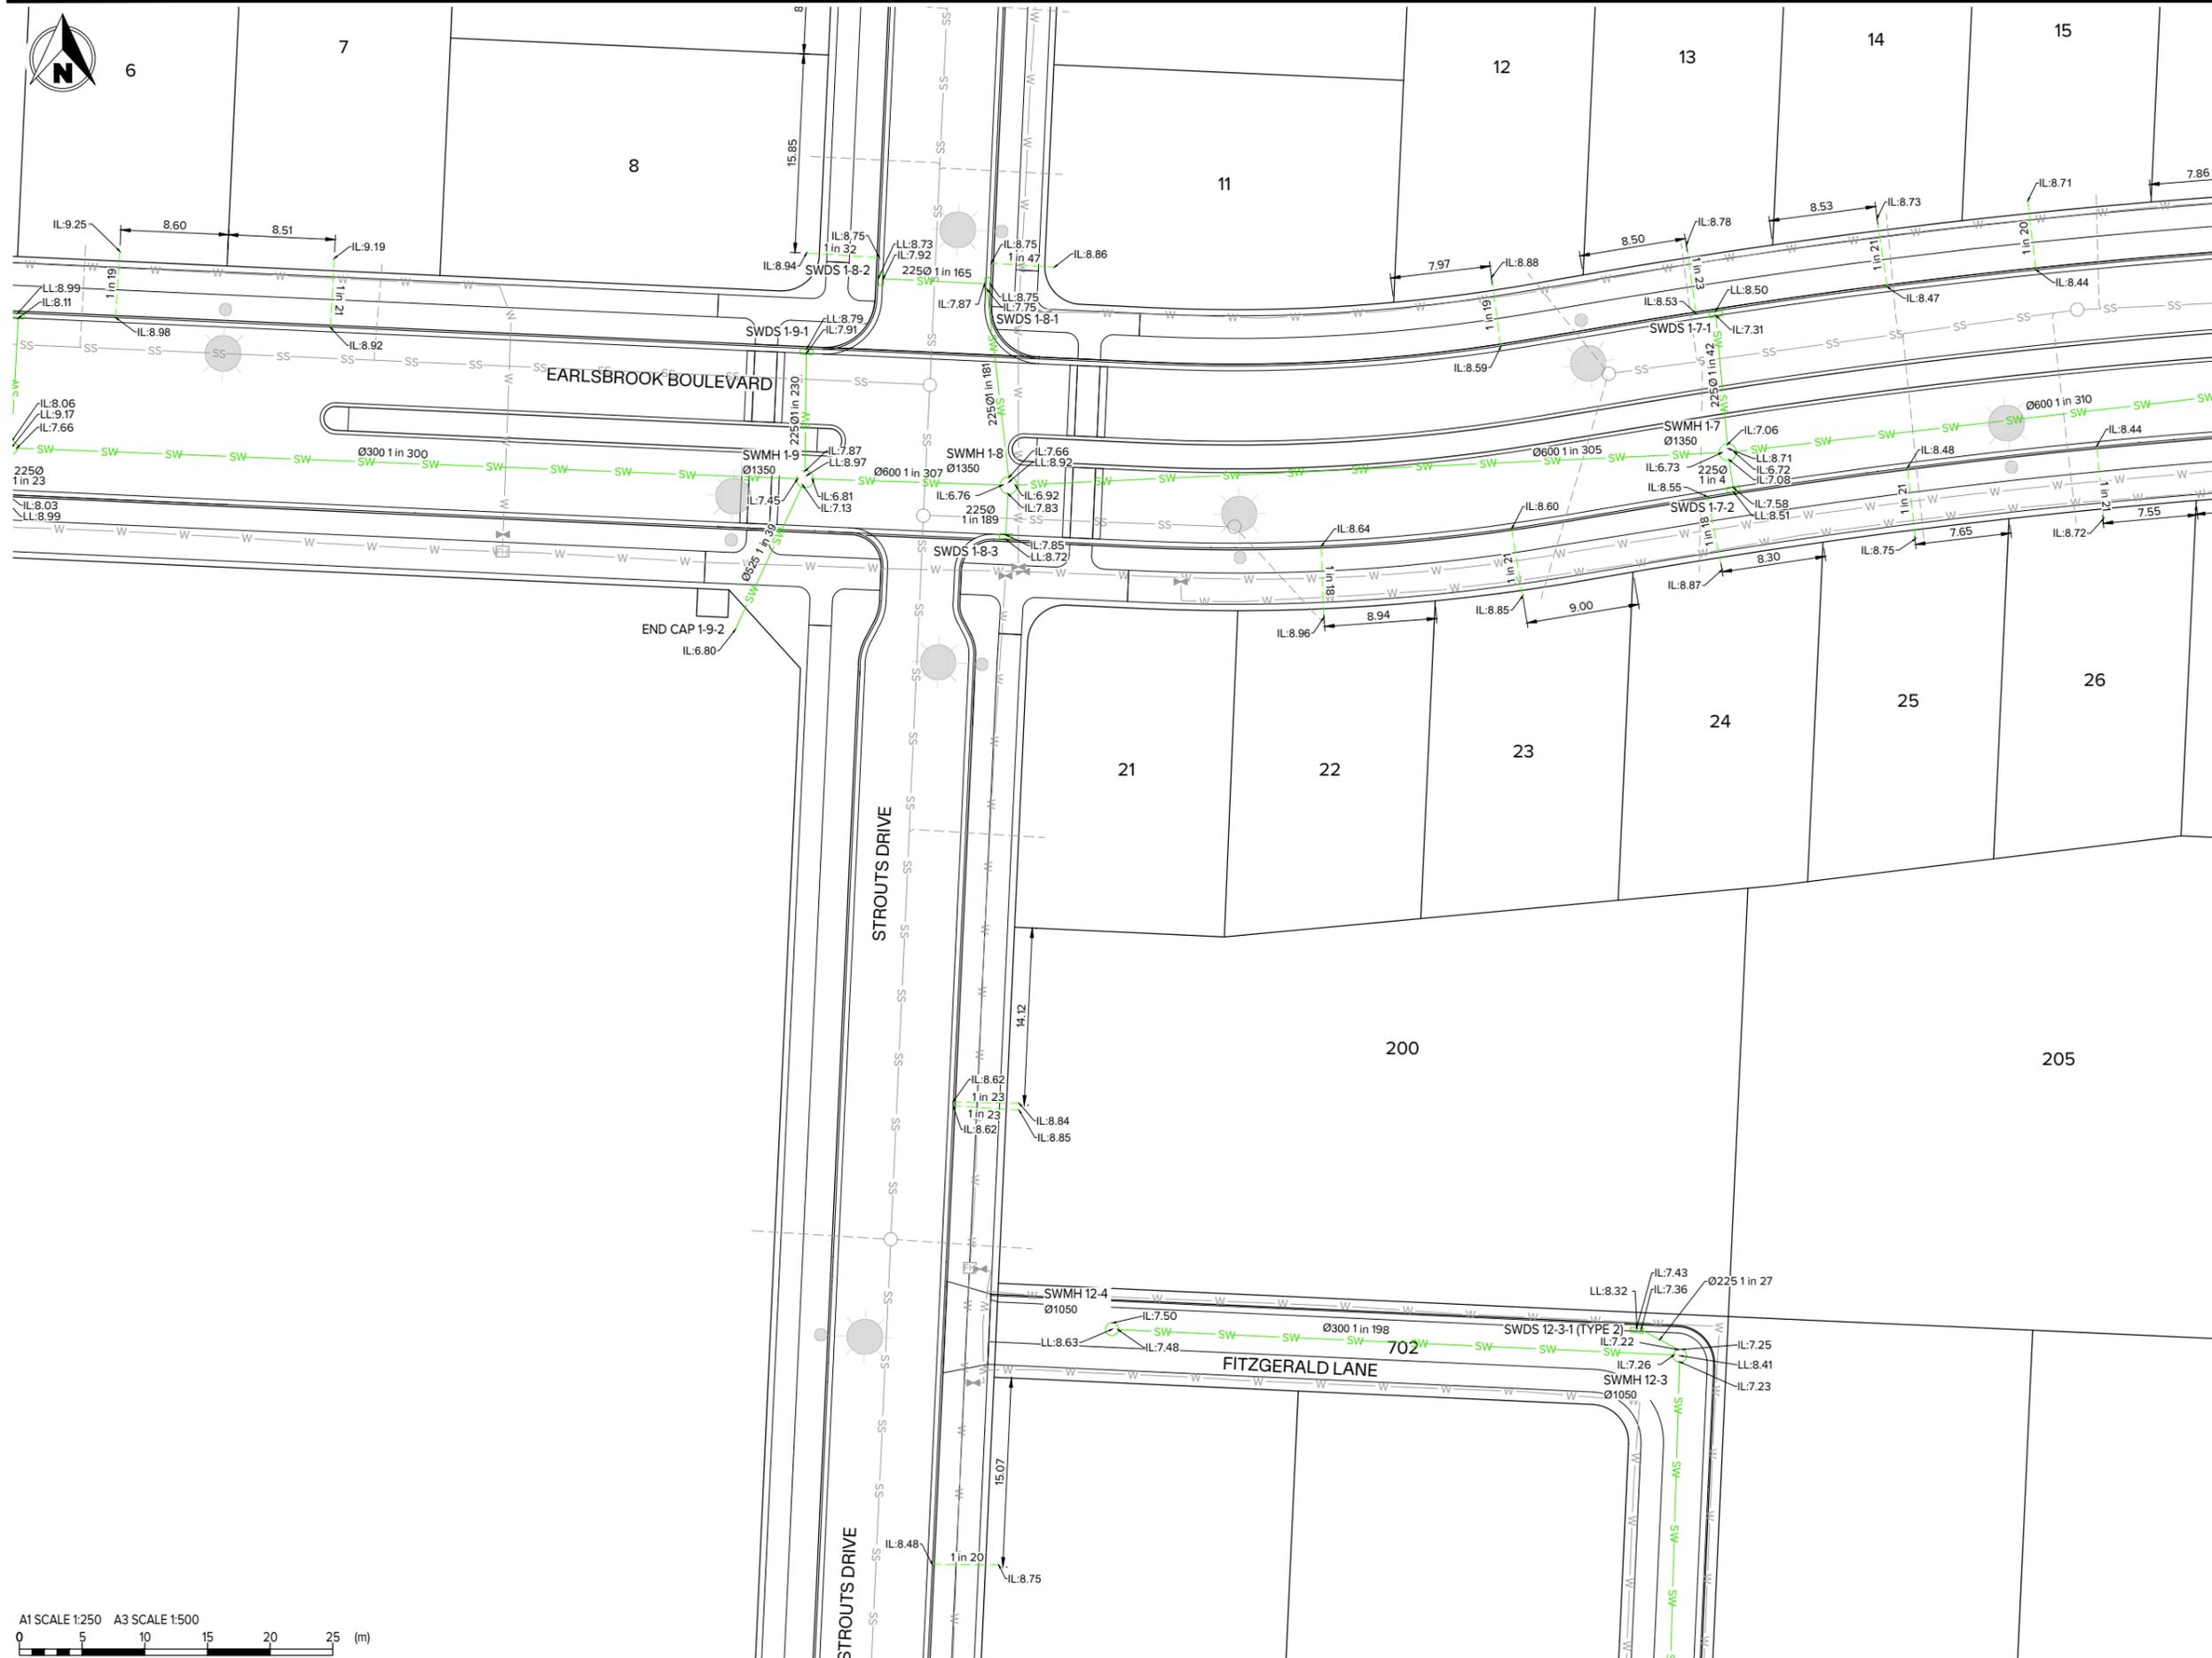

- NOTES**
1. CO-ORDINATES ARE IN TERMS OF NEW ZEALAND TRANSVERSE MERCATOR 2000 PROJECTION (NZTM2000).
 2. HEIGHTS ARE IN TERMS OF NEW ZEALAND VERTICAL DATUM 2016 (NZVD2016).
 3. AS-BUILT DATA CARRIED OUT BY MAUGERS CONTRACTING LTD AND SUPPLIED TO INOVO PROJECTS LTD.
 4. ALL STORMWATER LATERALS ARE DN100 uPVC SN8.
 5. PROPOSED BOUNDARIES ARE SUBJECT TO FINAL SURVEY.
 6. EXISTING BOUNDARIES SOURCED FROM LINZ DATA SERVICE AND IS TO BE USED IN ACCORDANCE WITH THE INTERNATIONAL CREATIVE COMMONS LICENCE 4.0.
 7. ALL DIMENSIONS ARE IN METRES UNLESS STATED.

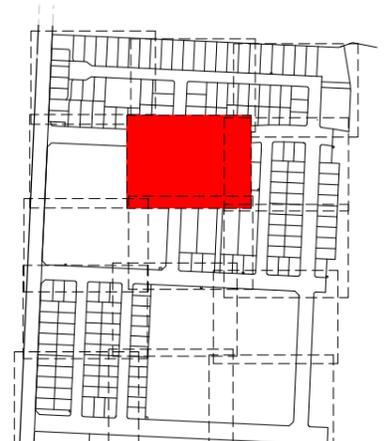

Rev#	Description	Drawn	Date
0	FOR AS-BUILT	IAMcC	28.08.25

INOVO
 Level 1, 93 Manchester St, Christchurch 8022
 Ph. 03 377 3290
 Level 1, Shed 19, Princess Wharf, Auckland 1010
 Ph. 09 600 1099
 www.inovo.nz

Scale A1
1:250
 Scale A3
1:500
 DO NOT SCALE FROM DRAWING

Drawn
AMcC
 Approved
TMcL
 Date
28.08.25

Client
EARLSBROOK LINCOLN


Project
EARLSBROOK RESIDENTIAL SUBDIVISION STAGE 1

Drawing Title
STORMWATER AS-BUILT STAGE 1 SHEET 6



Status
AS-BUILT AUG 2025

Drawing No.
15721-S1-AB-4005

Rev
0

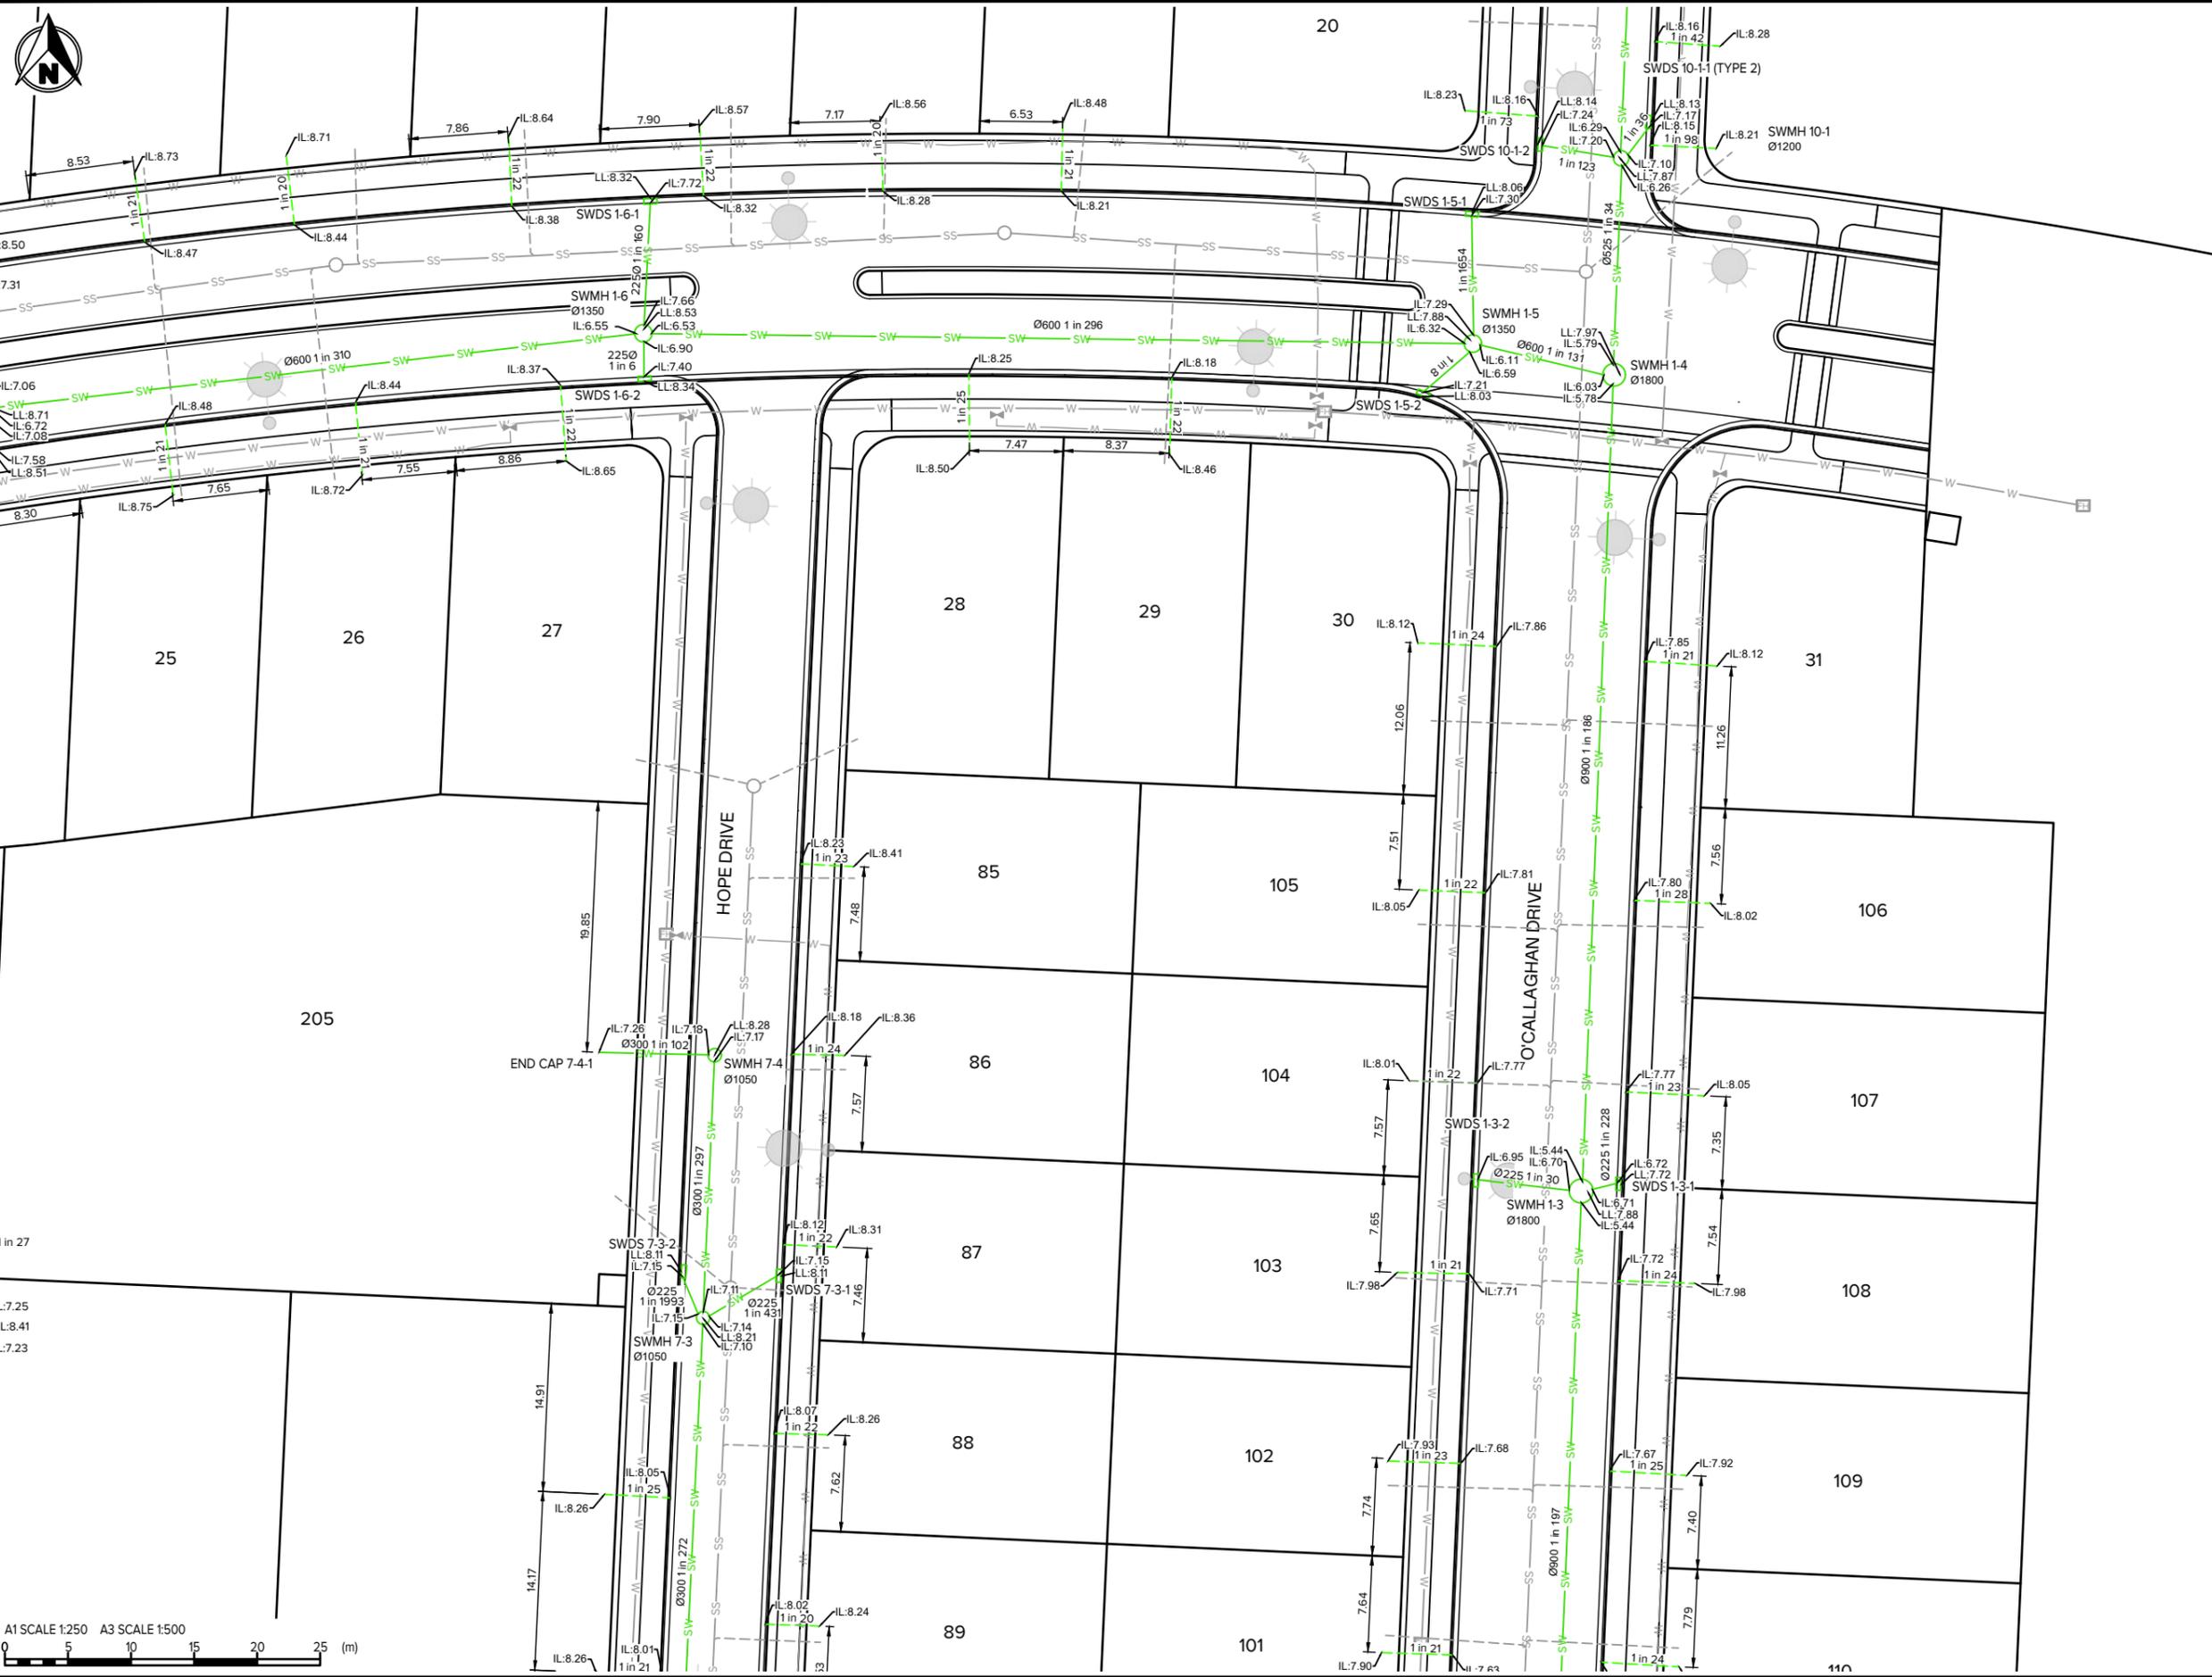

- NOTES**
1. CO-ORDINATES ARE IN TERMS OF NEW ZEALAND TRANSVERSE MERCATOR 2000 PROJECTION (NZTM2000).
 2. HEIGHTS ARE IN TERMS OF NEW ZEALAND VERTICAL DATUM 2016 (NZVD2016).
 3. AS-BUILT DATA CARRIED OUT BY MAUGERS CONTRACTING LTD AND SUPPLIED TO INOVO PROJECTS LTD.
 4. ALL STORMWATER LATERALS ARE DN100 uPVC SNB.
 5. PROPOSED BOUNDARIES ARE SUBJECT TO FINAL SURVEY.
 6. EXISTING BOUNDARIES SOURCED FROM LINZ DATA SERVICE AND IS TO BE USED IN ACCORDANCE WITH THE INTERNATIONAL CREATIVE COMMONS LICENCE 4.0.
 7. ALL DIMENSIONS ARE IN METRES UNLESS STATED.

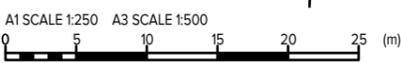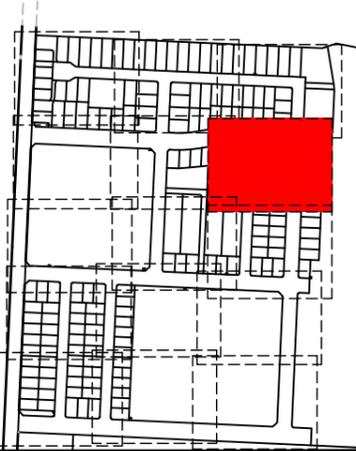

Rev#	Description	Drawn	Date



Level 1, 93 Manchester St, Christchurch 8022
 Ph. 03 377 3290
 Level 1, Shed 19, Princess Wharf, Auckland 1010
 Ph. 09 600 1099
 www.inovo.nz

Scale A1
1:250
Scale A3
1:500
DO NOT SCALE FROM DRAWING

Drawn
AMcC
Approved
TMcL
Date
28.08.25



Client
EARLSBROOK LINCOLN
Project
EARLSBROOK RESIDENTIAL SUBDIVISION STAGE 1

Drawing Title
STORMWATER AS-BUILT STAGE 1 SHEET 7

Status
AS-BUILT AUG 2025
Drawing No.
15721-S1-AB-4006 Rev
0






4000

NOTES

1. CO-ORDINATES ARE IN TERMS OF NEW ZEALAND TRANSVERSE MERCATOR 2000 PROJECTION (NZTM2000).
2. HEIGHTS ARE IN TERMS OF NEW ZEALAND VERTICAL DATUM 2016 (NZVD2016).
3. AS-BUILT DATA CARRIED OUT BY MAUGERS CONTRACTING LTD AND SUPPLIED TO INOVO PROJECTS LTD.
4. ALL STORMWATER LATERALS ARE DN100 uPVC SN8.
5. PROPOSED BOUNDARIES ARE SUBJECT TO FINAL SURVEY.
6. EXISTING BOUNDARIES SOURCED FROM LINZ DATA SERVICE AND IS TO BE USED IN ACCORDANCE WITH THE INTERNATIONAL CREATIVE COMMONS LICENCE 4.0.
7. ALL DIMENSIONS ARE IN METRES UNLESS STATED.

LEGEND

- SITE BOUNDARIES
- STORMWATER MAIN
- STORMWATER LATERAL
- STREET LIGHT

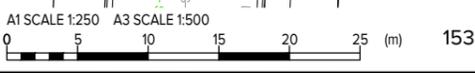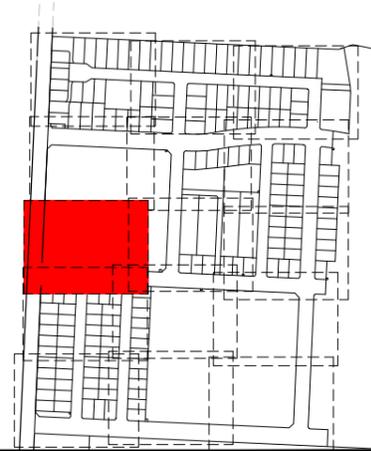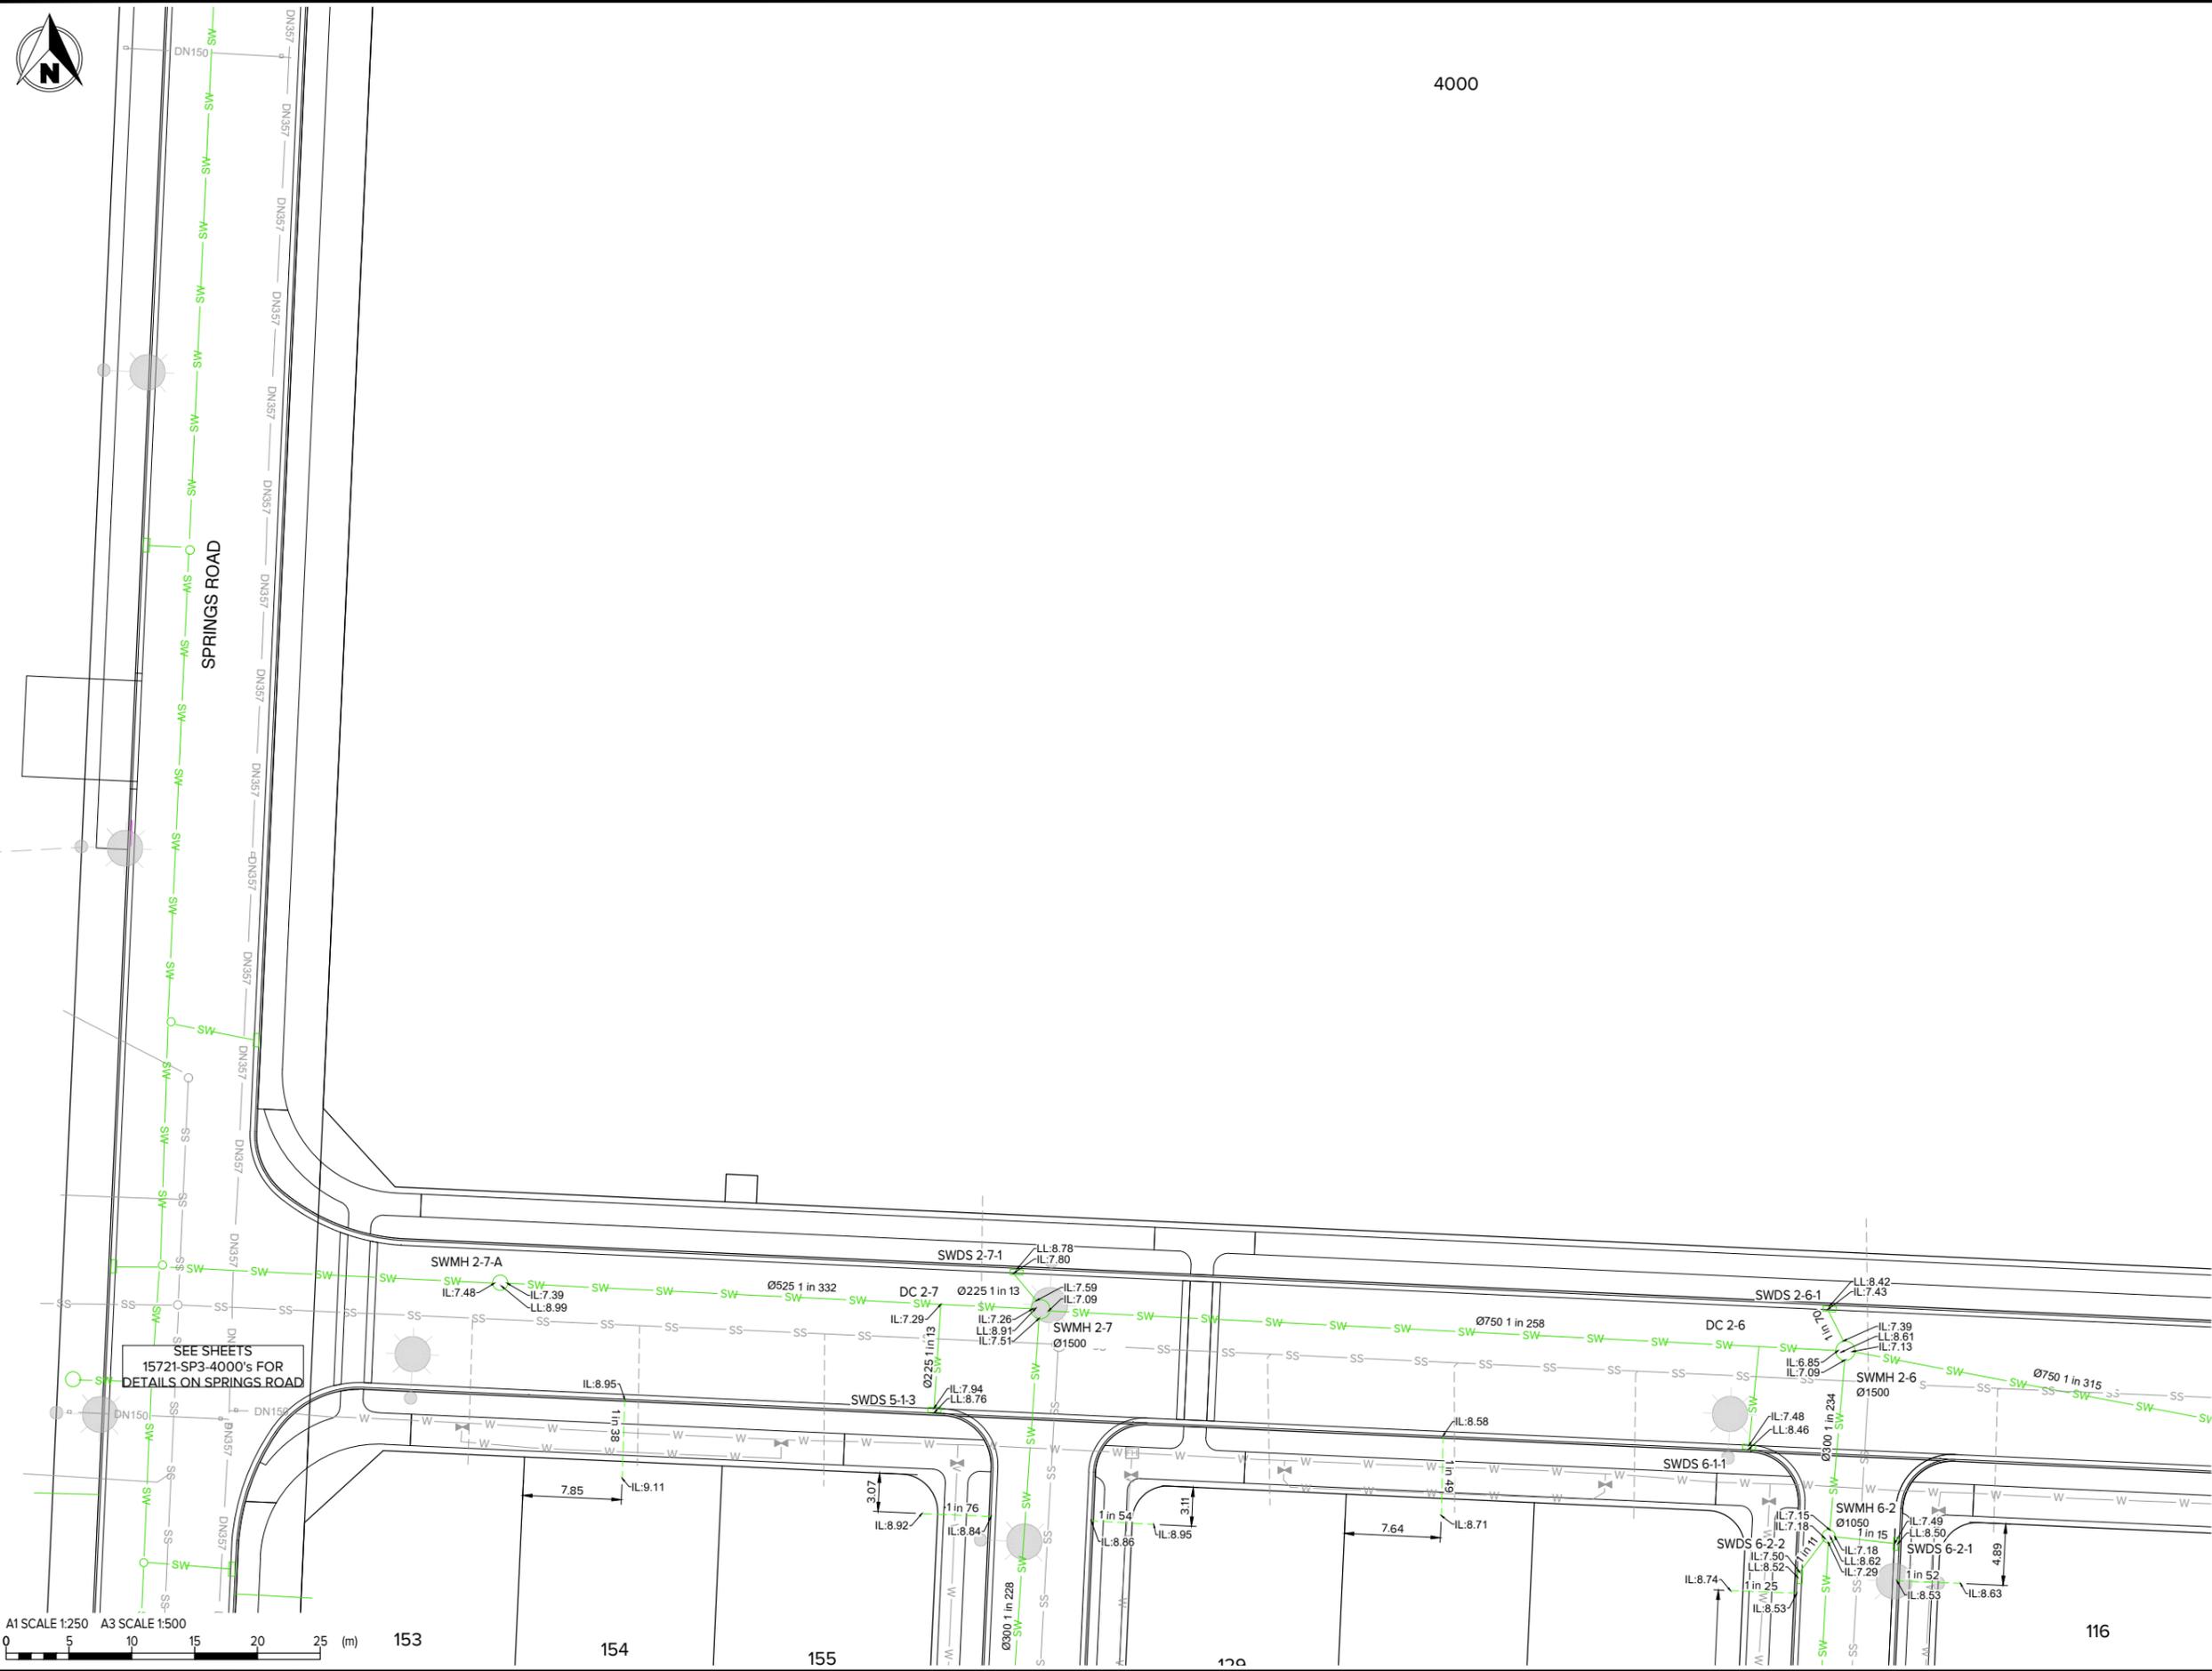

Rev#	Description	Drawn	Date
0	FOR AS-BUILT	IAMcC	28.08.25

INOVO
 Level 1, 93 Manchester St, Christchurch 8022
 Ph. 03 377 3290
 Level 1, Shed 19, Princess Wharf, Auckland 1010
 Ph. 09 600 1099
 www.inovo.nz

Scale A1
1:250
 Scale A3
1:500
 DO NOT SCALE FROM DRAWING

Drawn
AMcC
 Approved
TMcL
 Date
28.08.25

Client
EARLSBROOK
 LINCOLN

Project
EARLSBROOK
RESIDENTIAL SUBDIVISION
STAGE 1

Drawing Title
STORMWATER AS-BUILT
STAGE 1
SHEET 8

Status
AS-BUILT
AUG 2025

Drawing No.
15721-S1-AB-4007

Rev
0



NOTES

1. CO-ORDINATES ARE IN TERMS OF NEW ZEALAND TRANSVERSE MERCATOR 2000 PROJECTION (NZTM2000).
2. HEIGHTS ARE IN TERMS OF NEW ZEALAND VERTICAL DATUM 2016 (NZVD2016).
3. AS-BUILT DATA CARRIED OUT BY MAUGERS CONTRACTING LTD AND SUPPLIED TO INOVO PROJECTS LTD.
4. PROPOSED BOUNDARIES ARE SUBJECT TO FINAL SURVEY.
5. EXISTING BOUNDARIES SOURCED FROM LINZ DATA SERVICE AND IS TO BE USED IN ACCORDANCE WITH THE INTERNATIONAL CREATIVE COMMONS LICENCE 4.0.
6. ALL DIMENSIONS ARE IN METRES UNLESS STATED.

LEGEND

- - - - - SITE BOUNDARIES
- SW — SW STORMWATER MAIN
- - - - - STORMWATER LATERAL
- ⊙ STREET LIGHT



Rev#	Description	Drawn	Date
0	FOR AS-BUILT	IAMcC	28.08.25

INOVO
 Level 1, 93 Manchester St, Christchurch 8022
 Ph. 03 377 3290
 Level 1, Shed 19, Princess Wharf, Auckland 1010
 Ph. 09 600 1099
 www.inovo.nz

Scale A1
1:250
 Scale A3
1:500
 DO NOT SCALE FROM DRAWING

Drawn
AMcC
 Approved
TMcL
 Date
28.08.25

Client
EARLSBROOK
LINCOLN

Project
EARLSBROOK
RESIDENTIAL SUBDIVISION
STAGE 1

Drawing Title
STORMWATER AS-BUILT
STAGE 1
SHEET 9

Status
AS-BUILT
AUG 2025

Drawing No.
15721-S1-AB-4008

Rev
0



- NOTES**
1. CO-ORDINATES ARE IN TERMS OF NEW ZEALAND TRANSVERSE MERCATOR 2000 PROJECTION (NZTM2000).
 2. HEIGHTS ARE IN TERMS OF NEW ZEALAND VERTICAL DATUM 2016 (NZVD2016).
 3. AS-BUILT DATA CARRIED OUT BY MAUGERS CONTRACTING LTD AND SUPPLIED TO INOVO PROJECTS LTD.
 4. ALL STORMWATER LATERALS ARE DN100 uPVC SN8.
 5. PROPOSED BOUNDARIES ARE SUBJECT TO FINAL SURVEY.
 6. EXISTING BOUNDARIES SOURCED FROM LINZ DATA SERVICE AND IS TO BE USED IN ACCORDANCE WITH THE INTERNATIONAL CREATIVE COMMONS LICENCE 4.0.
 7. ALL DIMENSIONS ARE IN METRES UNLESS STATED.



Rev#	Description	Drawn	Date
0	FOR AS-BUILT	IAMcC	28.08.25



Scale A1
1:250
Scale A3
1:500
DO NOT SCALE FROM DRAWING

Client
EARLSBROOK
LINCOLN


Project
EARLSBROOK
RESIDENTIAL SUBDIVISION
STAGE 1

Drawing Title
STORMWATER AS-BUILT
STAGE 1
SHEET 10

Status
AS-BUILT
AUG 2025

Drawing No.
15721-S1-AB-4009

Rev
0

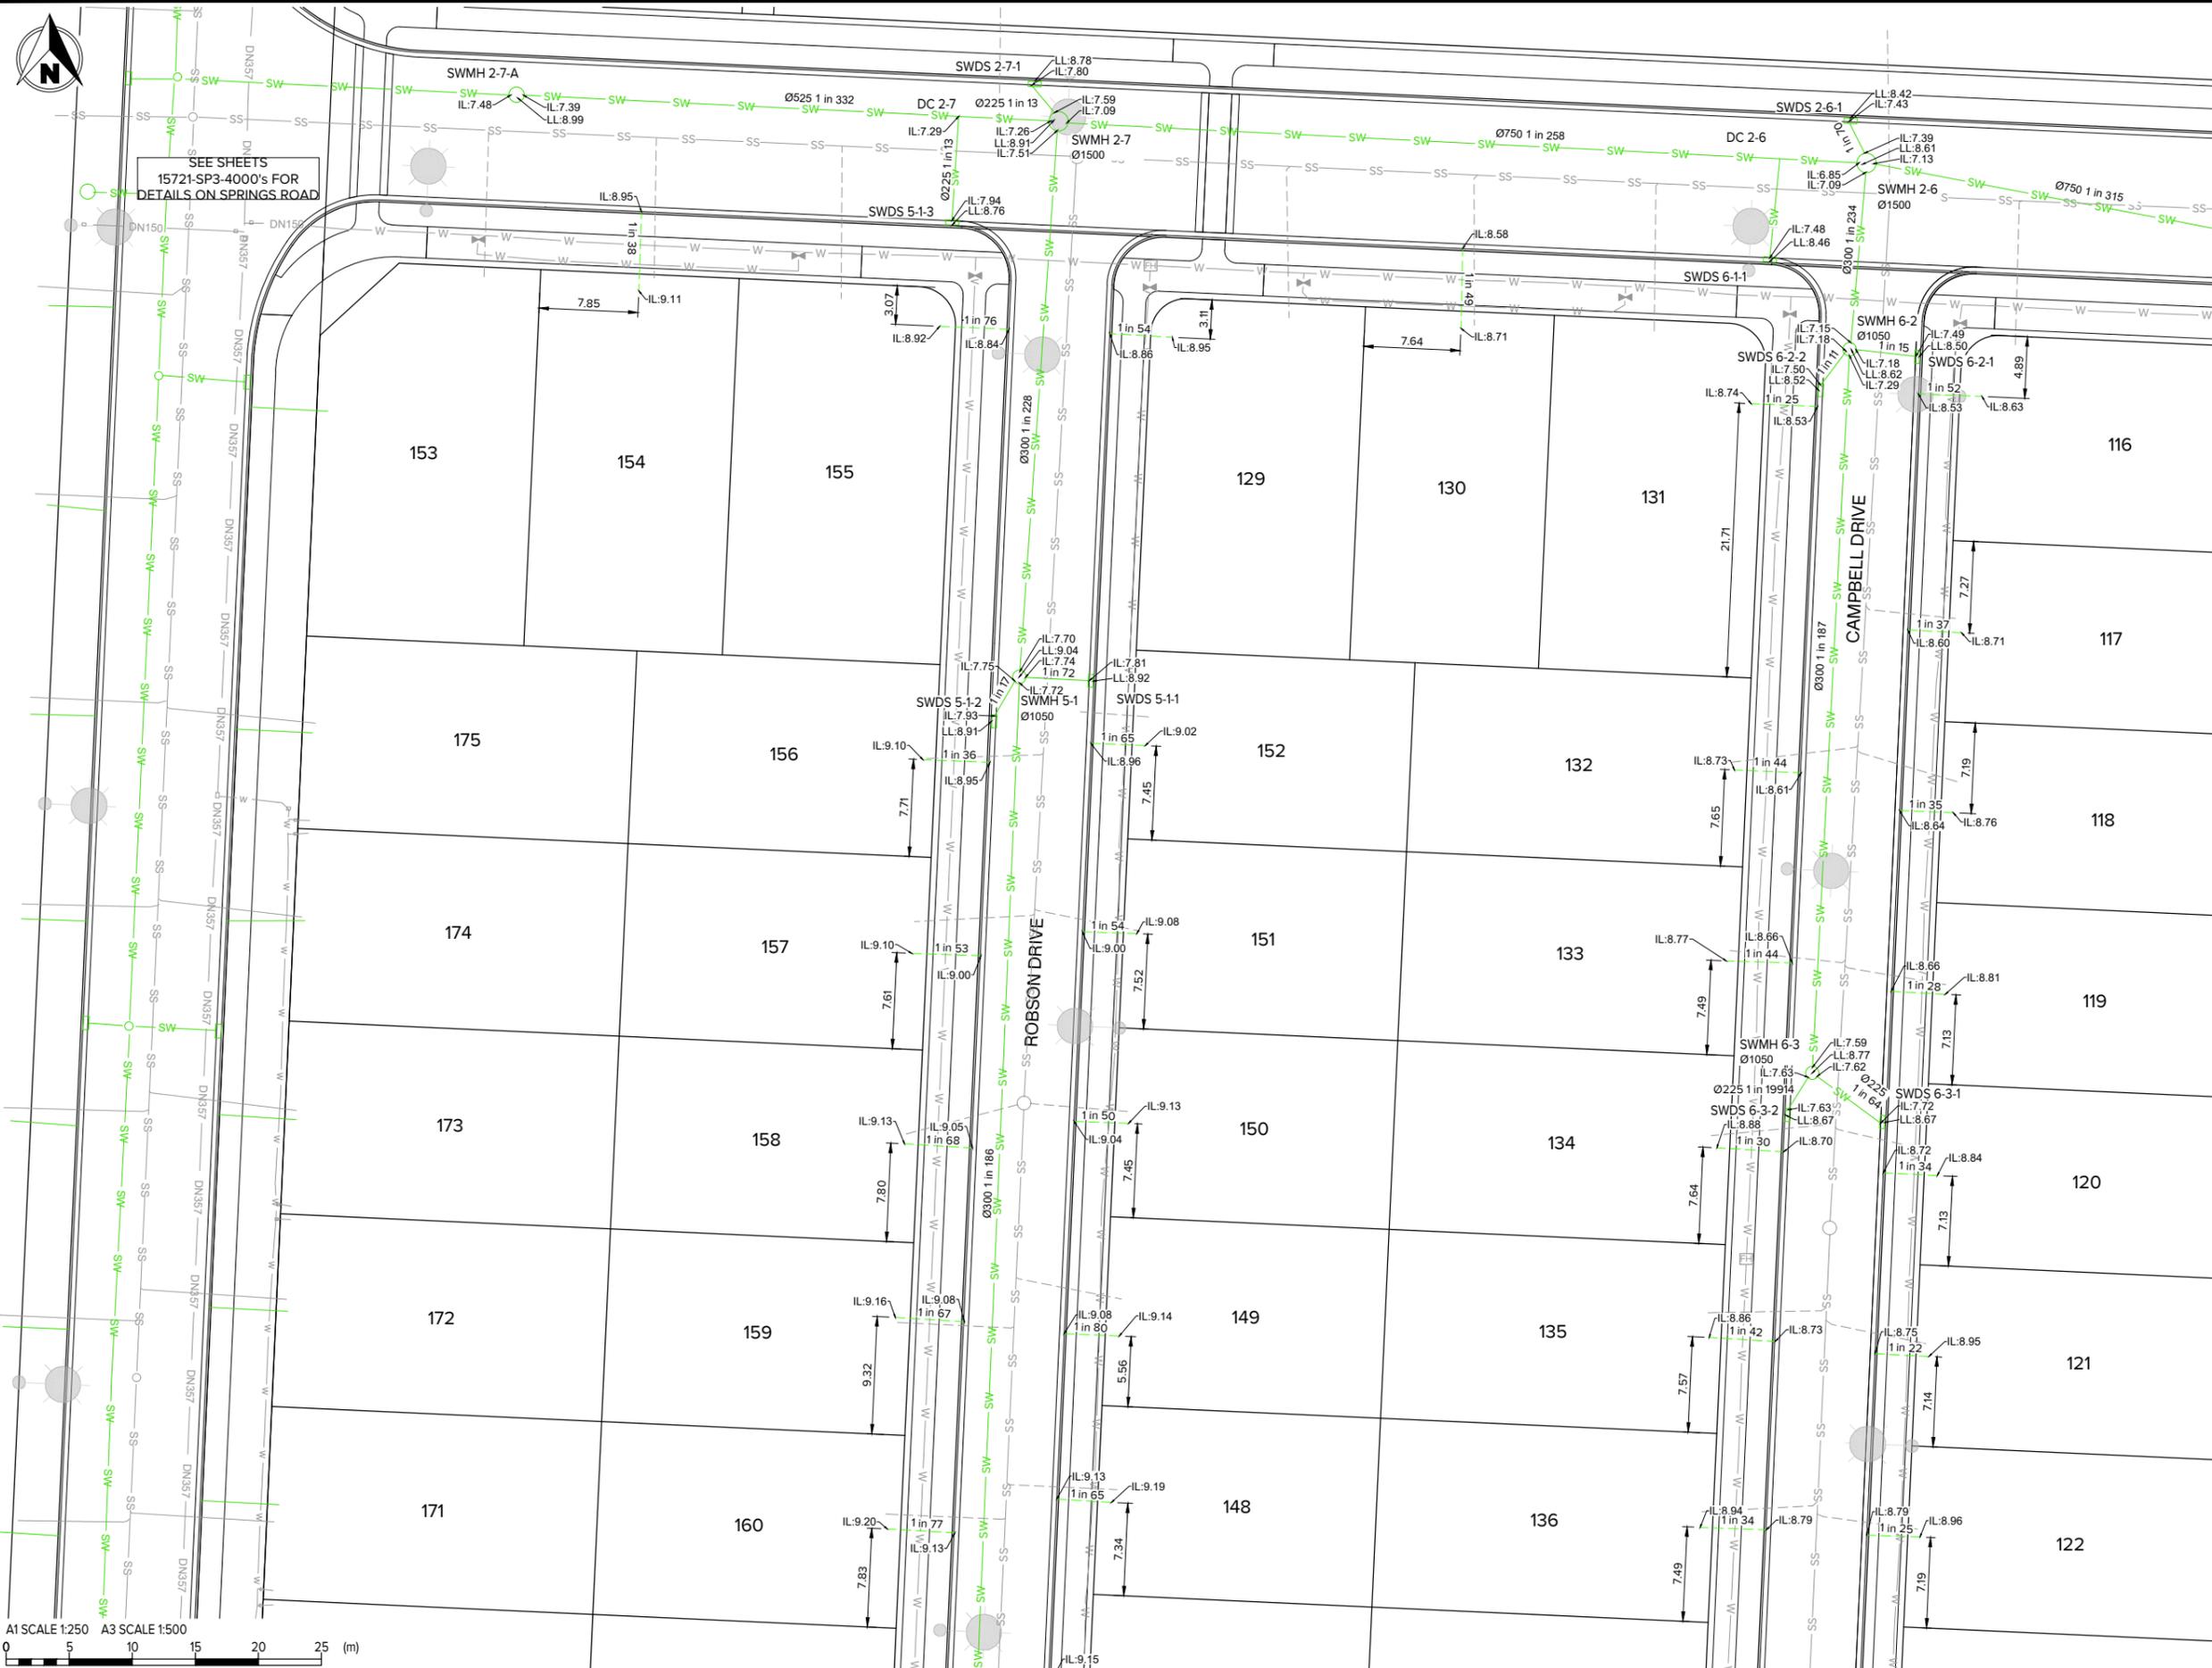


SEE SHEETS
15721-SP3-4000's FOR
DETAILS ON SPRINGS ROAD

A1 SCALE 1:250 A3 SCALE 1:500
0 5 10 15 20 25 (m)

- NOTES**
1. CO-ORDINATES ARE IN TERMS OF NEW ZEALAND TRANSVERSE MERCATOR 2000 PROJECTION (NZTM2000).
 2. HEIGHTS ARE IN TERMS OF NEW ZEALAND VERTICAL DATUM 2016 (NZVD2016).
 3. AS-BUILT DATA CARRIED OUT BY MAUGERS CONTRACTING LTD AND SUPPLIED TO INOVO PROJECTS LTD.
 4. ALL STORMWATER LATERALS ARE DN100 uPVC SN8.
 5. PROPOSED BOUNDARIES ARE SUBJECT TO FINAL SURVEY.
 6. EXISTING BOUNDARIES SOURCED FROM LINZ DATA SERVICE AND IS TO BE USED IN ACCORDANCE WITH THE INTERNATIONAL CREATIVE COMMONS LICENCE 4.0.
 7. ALL DIMENSIONS ARE IN METRES UNLESS STATED.

- LEGEND**
- SITE BOUNDARIES
 - SW — STORMWATER MAIN
 - - - - STORMWATER LATERAL
 - STREET LIGHT

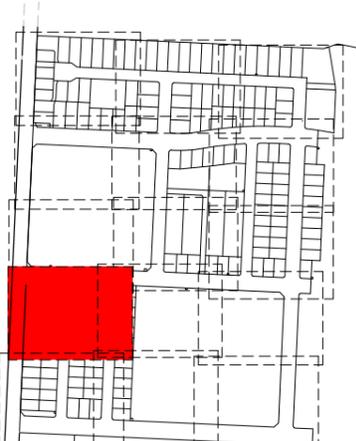

Rev#	Description	Drawn	Date
0	FOR AS-BUILT	IAMcC	28.08.25

INOVO
Level 1, 93 Manchester St, Christchurch 8022
Ph. 03 377 3290
Level 1, Shed 19, Princess Wharf, Auckland 1010
Ph. 09 600 1099
www.inovo.nz

Scale A1
1:250
Scale A3
1:500
DO NOT SCALE FROM DRAWING

Drawn
AMcC
Approved
TMcL
Date
28.08.25

Client
EARLSBROOK
LINCOLN


Project
EARLSBROOK
RESIDENTIAL SUBDIVISION
STAGE 1

Drawing Title
STORMWATER AS-BUILT
STAGE 1
SHEET 11

Status
AS-BUILT
AUG 2025


Drawing No.
15721-S1-AB-4010

Rev
0

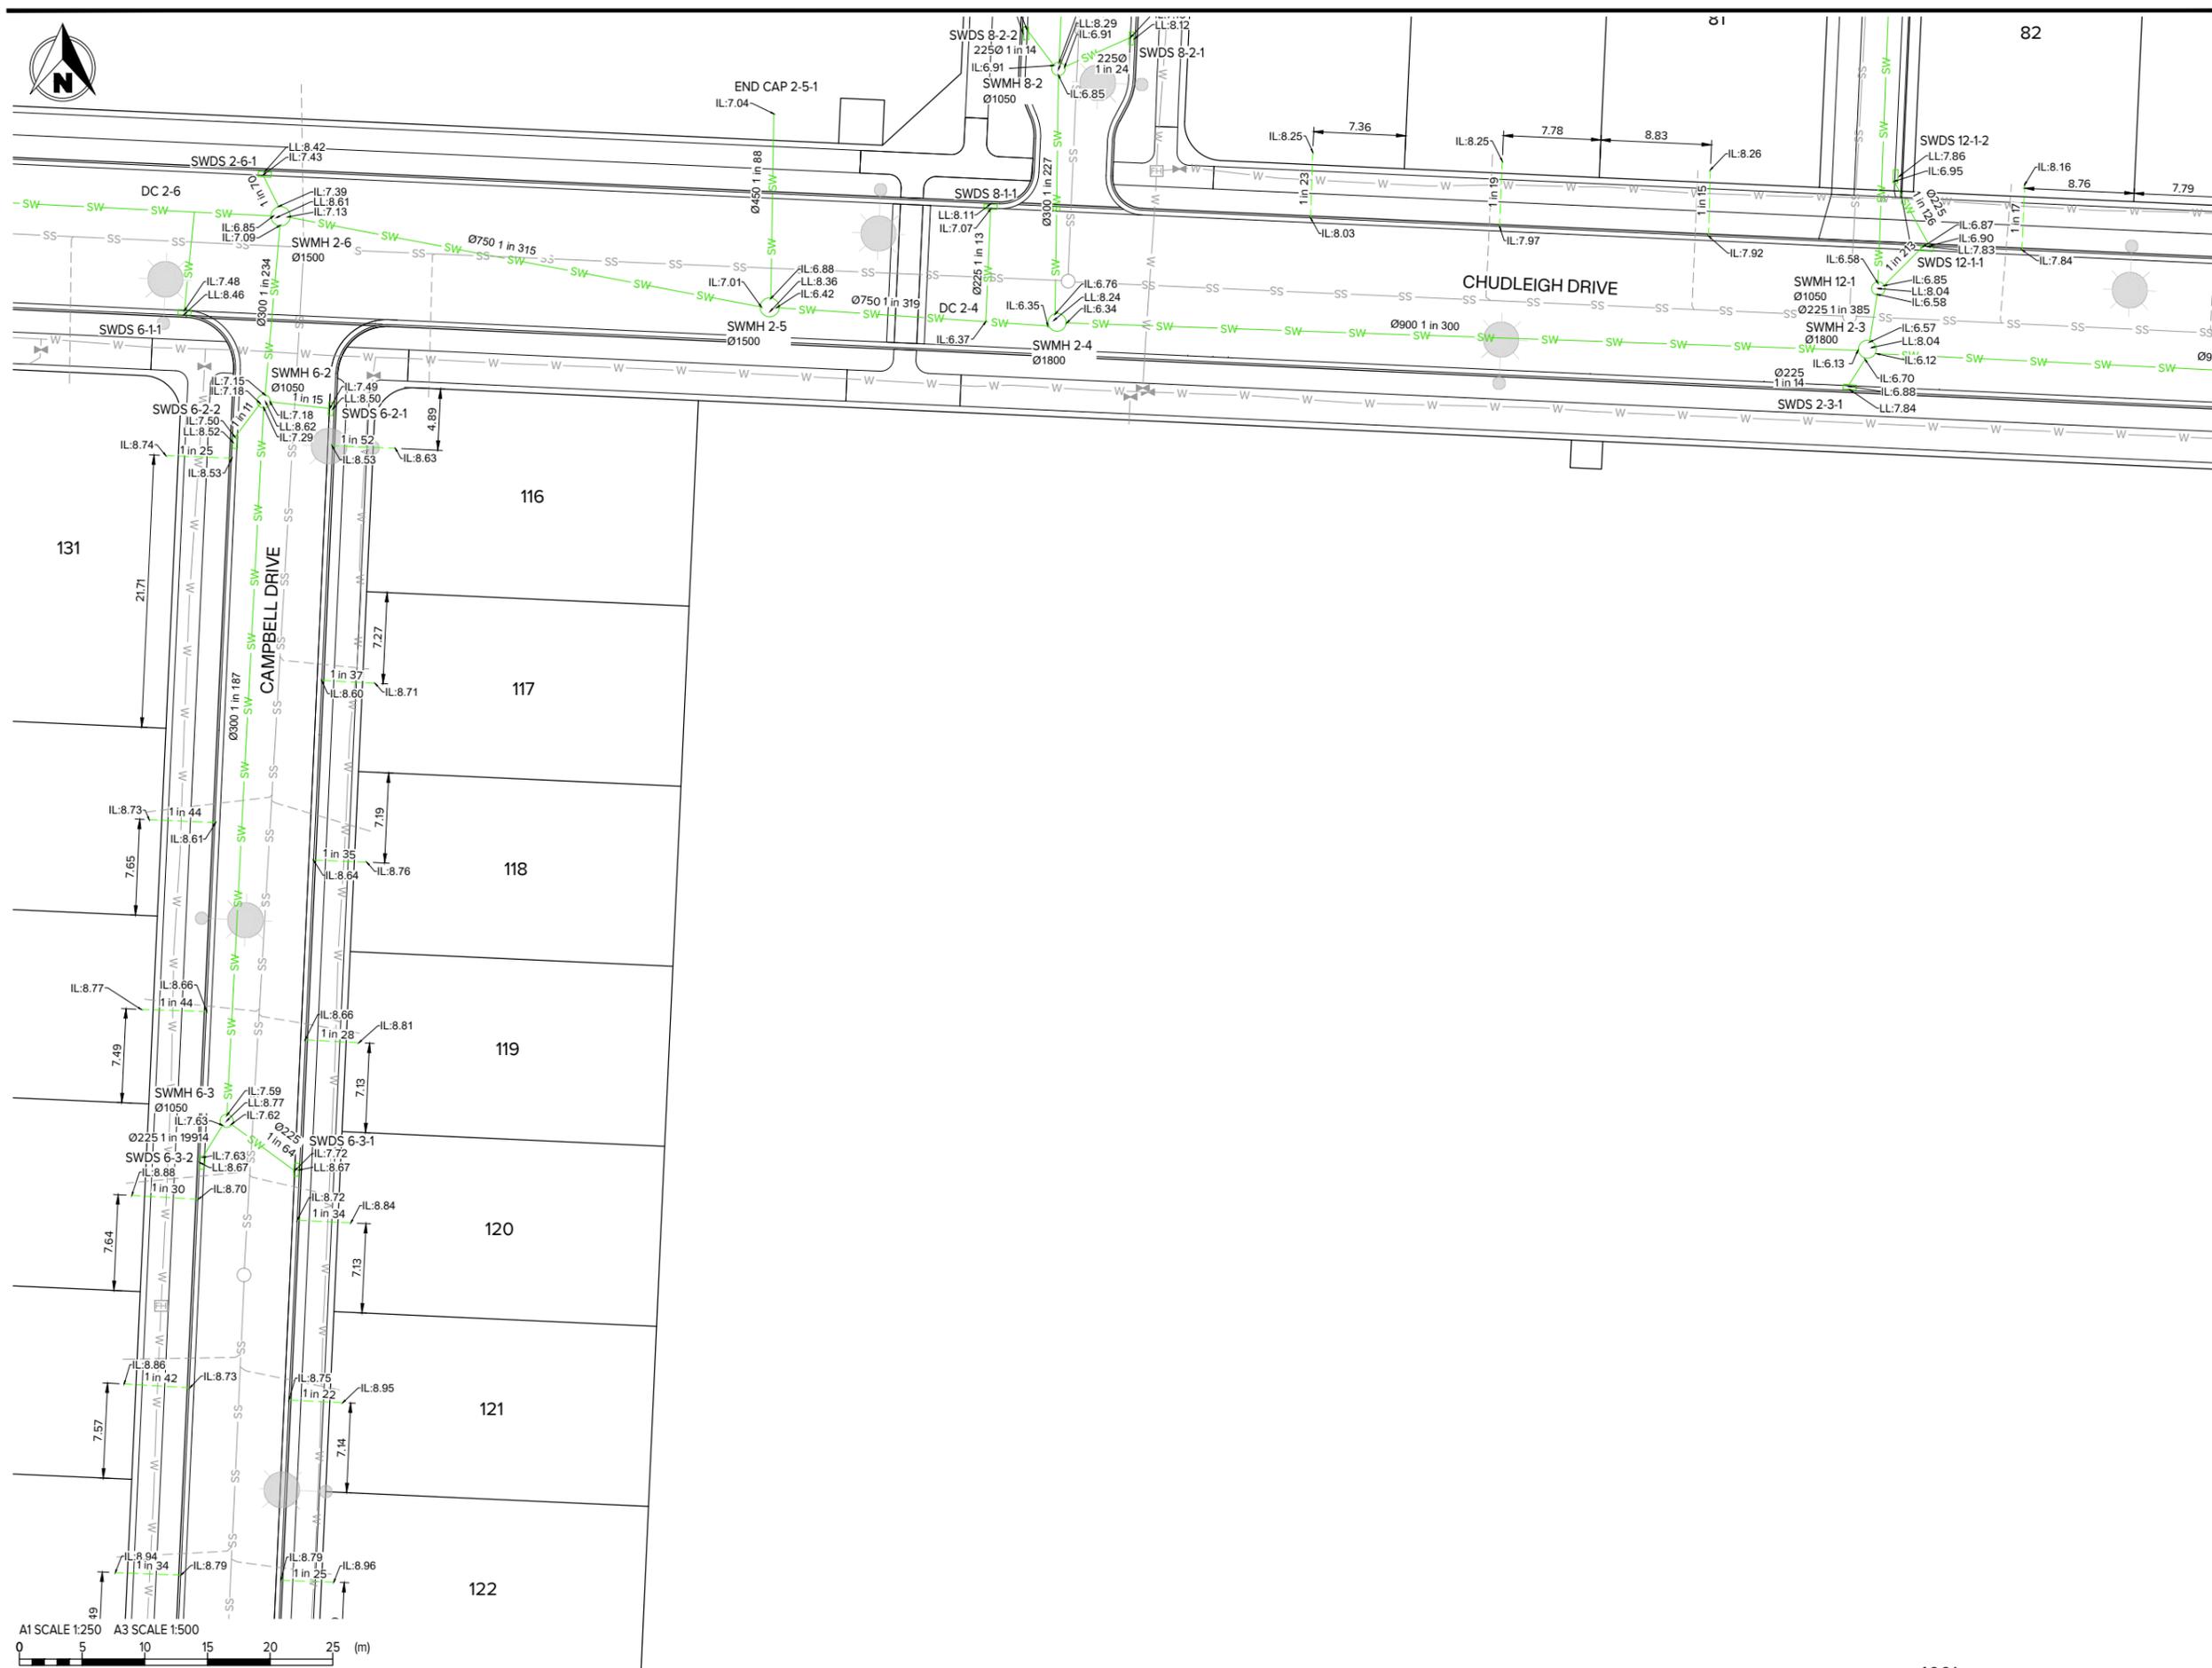

- NOTES**
1. CO-ORDINATES ARE IN TERMS OF NEW ZEALAND TRANSVERSE MERCATOR 2000 PROJECTION (NZTM2000).
 2. HEIGHTS ARE IN TERMS OF NEW ZEALAND VERTICAL DATUM 2016 (NZVD2016).
 3. AS-BUILT DATA CARRIED OUT BY MAUGERS CONTRACTING LTD AND SUPPLIED TO INOVO PROJECTS LTD.
 4. ALL STORMWATER LATERALS ARE DN100 uPVC SN8.
 5. PROPOSED BOUNDARIES ARE SUBJECT TO FINAL SURVEY.
 6. EXISTING BOUNDARIES SOURCED FROM LINZ DATA SERVICE AND IS TO BE USED IN ACCORDANCE WITH THE INTERNATIONAL CREATIVE COMMONS LICENCE 4.0.
 7. ALL DIMENSIONS ARE IN METRES UNLESS STATED.

- LEGEND**
- SITE BOUNDARIES
 - SW — STORMWATER MAIN
 - - - - STORMWATER LATERAL
 - STREET LIGHT

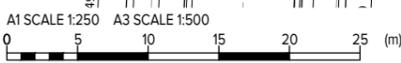

Rev#	Description	Drawn	Date
0	FOR AS-BUILT	IAMC	28.08.25

INOVO
 Level 1, 93 Manchester St, Christchurch 8022
 Ph. 03 377 3290
 Level 1, Shed 19, Princess Wharf, Auckland 1010
 Ph. 09 600 1099
 www.inovo.nz

Scale A1
1:250
 Scale A3
1:500
 DO NOT SCALE FROM DRAWING

Drawn
AMcC
 Approved
TMcL
 Date
28.08.25

Client
EARLSBROOK
LINCOLN


Project
**EARLSBROOK
 RESIDENTIAL SUBDIVISION
 STAGE 1**

Drawing Title
**STORMWATER AS-BUILT
 STAGE 1
 SHEET 12**

Status
**AS-BUILT
 AUG 2025**

Drawing No.
15721-S1-AB-4011


Rev
 0

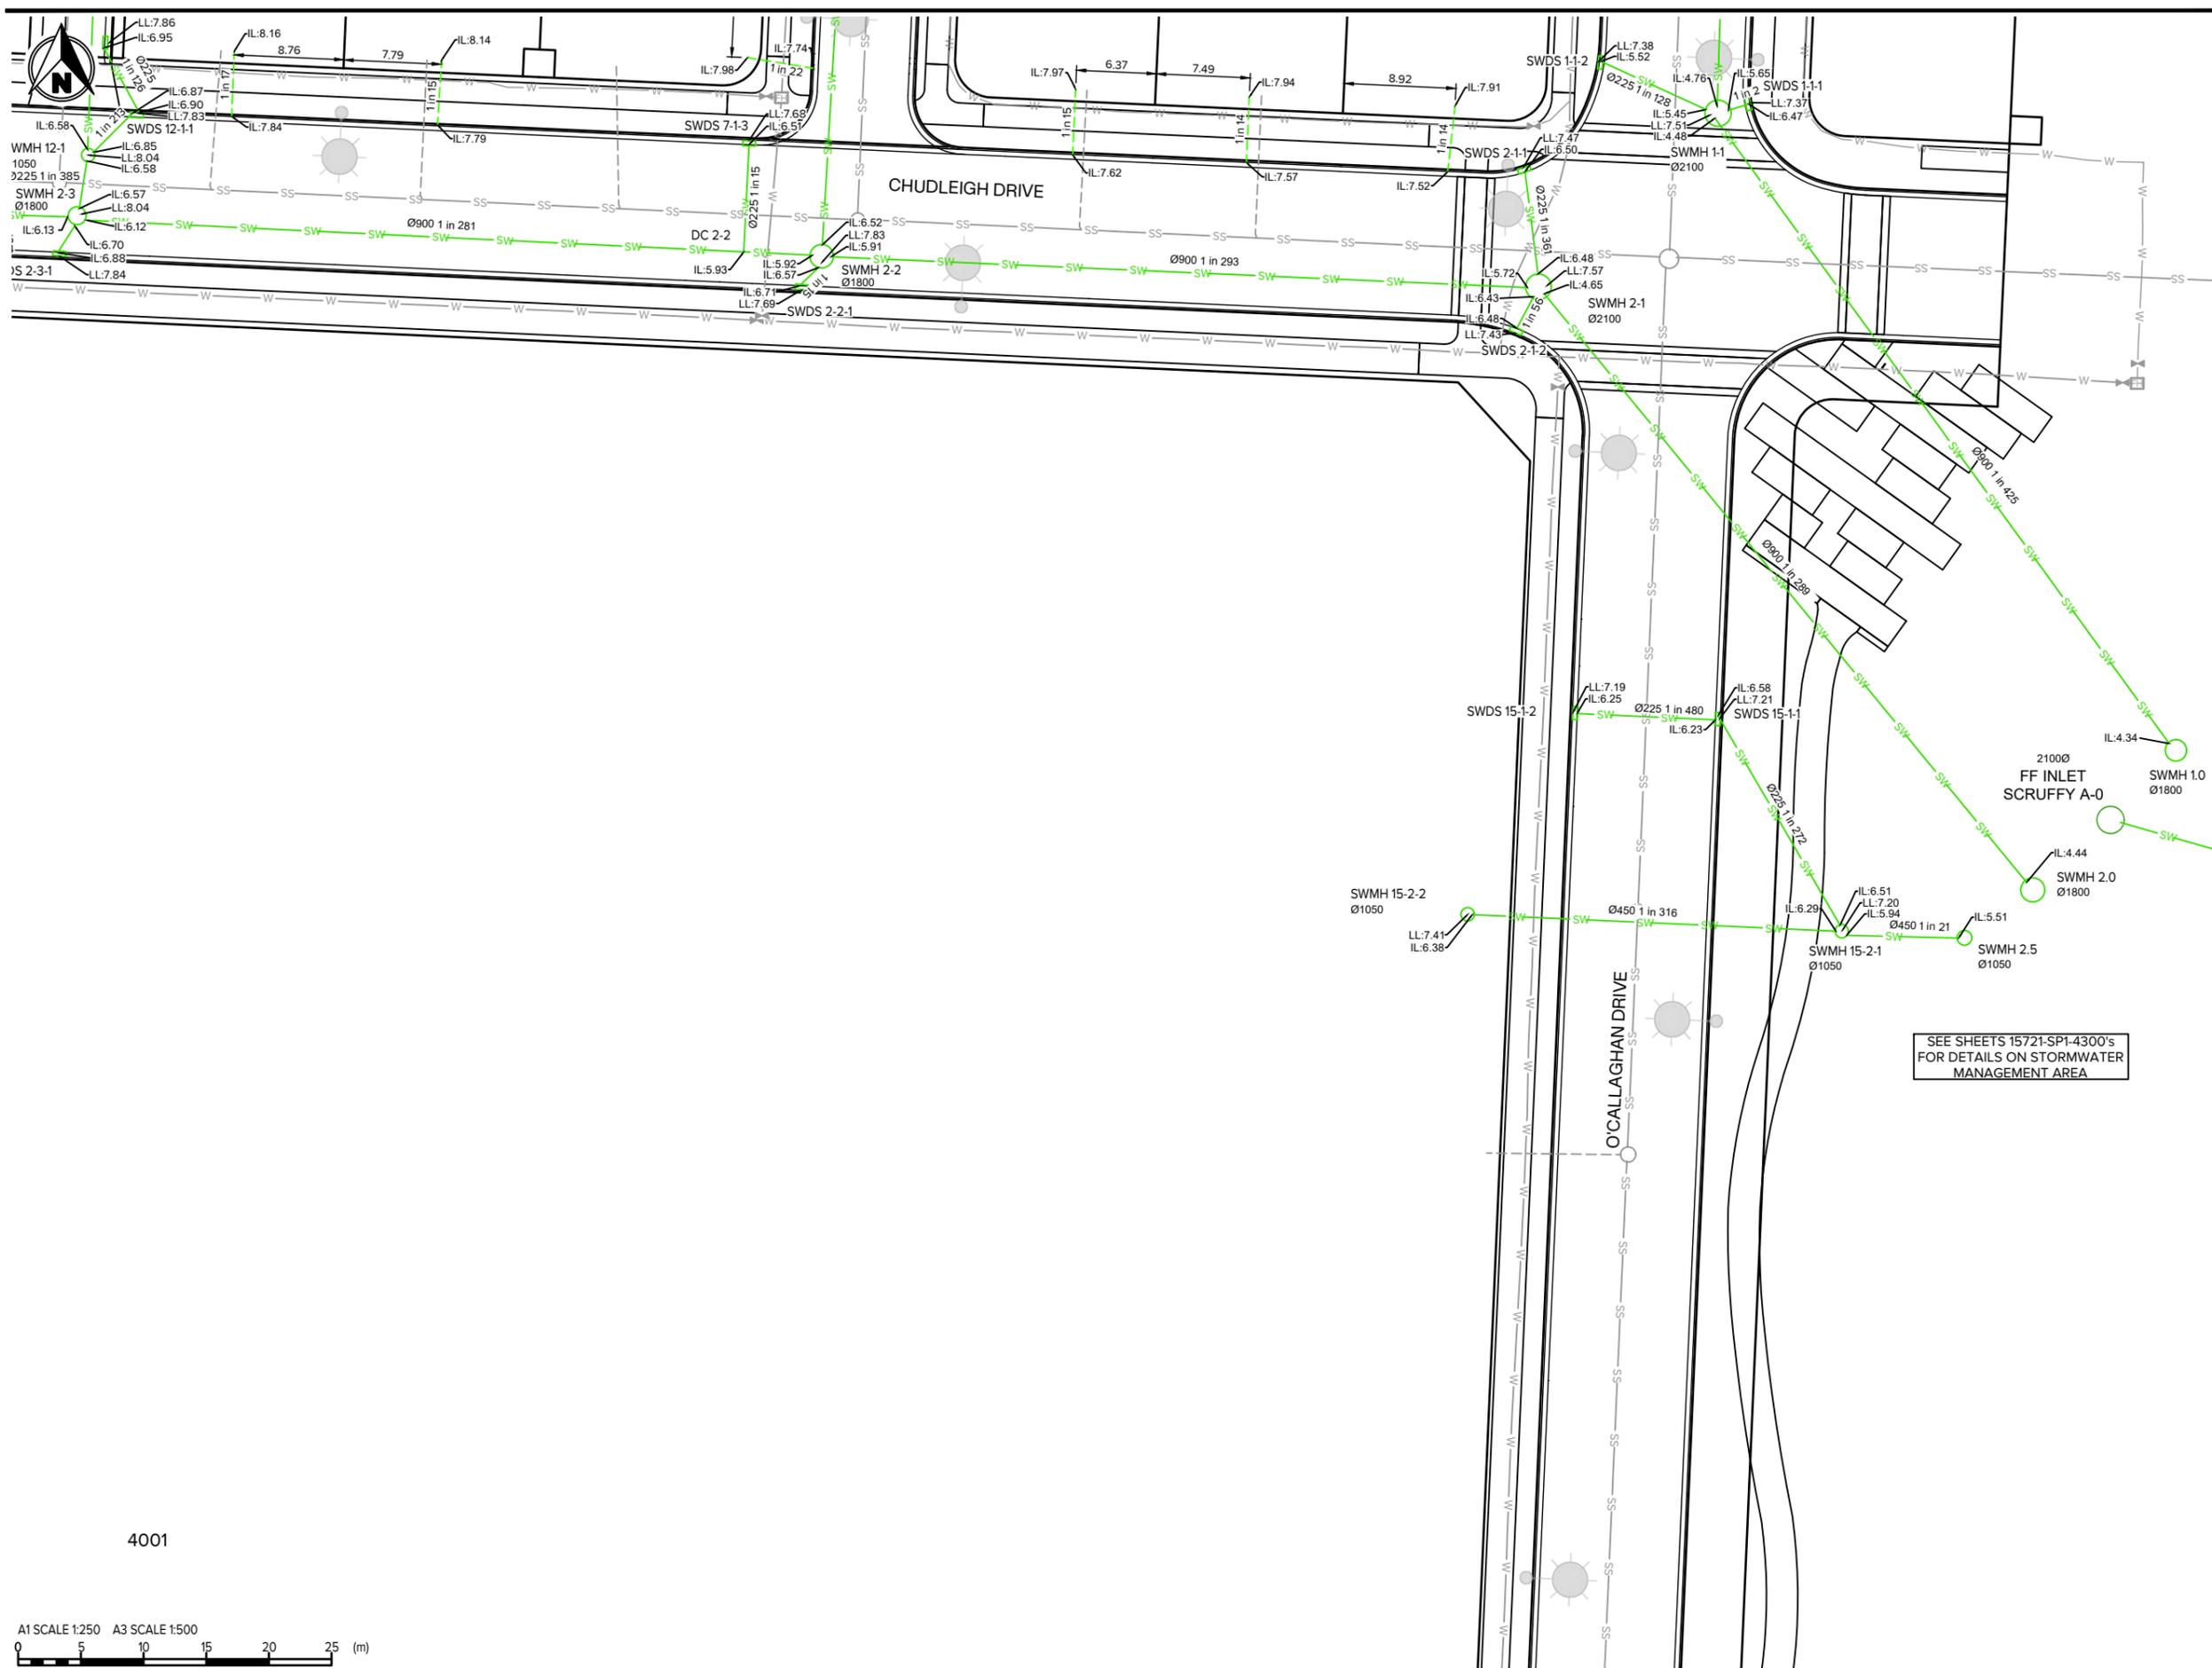

- NOTES**
1. CO-ORDINATES ARE IN TERMS OF NEW ZEALAND TRANSVERSE MERCATOR 2000 PROJECTION (NZTM2000).
 2. HEIGHTS ARE IN TERMS OF NEW ZEALAND VERTICAL DATUM 2016 (NZVD2016).
 3. AS-BUILT DATA CARRIED OUT BY MAUGERS CONTRACTING LTD AND SUPPLIED TO INOVO PROJECTS LTD.
 4. ALL STORMWATER LATERALS ARE DN100 uPVC SNB.
 5. PROPOSED BOUNDARIES ARE SUBJECT TO FINAL SURVEY.
 6. EXISTING BOUNDARIES SOURCED FROM LINZ DATA SERVICE AND IS TO BE USED IN ACCORDANCE WITH THE INTERNATIONAL CREATIVE COMMONS LICENCE 4.0.
 7. ALL DIMENSIONS ARE IN METRES UNLESS STATED.

- LEGEND**
- SITE BOUNDARIES
 - SW — STORMWATER MAIN
 - - - - STORMWATER LATERAL
 - ☼ STREET LIGHT

SEE SHEETS 15721-SPI-4300'S FOR DETAILS ON STORMWATER MANAGEMENT AREA

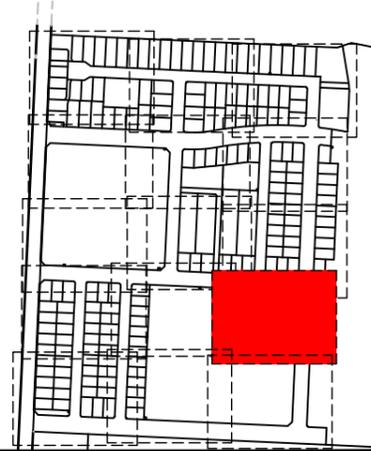

4001



Rev#	Description	Drawn	Date
0	FOR AS-BUILT	AMcC	28.08.25



Level 1, 93 Manchester St, Christchurch 8022
 Ph. 03 377 3290
 Level 1, Shed 19, Princess Wharf, Auckland 1010
 Ph. 09 600 1099
 www.inovo.nz

Scale A1
1:250
Scale A3
1:500
DO NOT SCALE FROM DRAWING

Drawn
AMcC
Approved
TMCL
Date
28.08.25



Project
**EARLSBROOK
RESIDENTIAL SUBDIVISION
STAGE 1**

Drawing Title
**STORMWATER AS-BUILT
STAGE 1
SHEET 13**


Status
**AS-BUILT
AUG 2025**
Drawing No.
15721-S1-AB-4012 Rev
0



- NOTES**
1. CO-ORDINATES ARE IN TERMS OF NEW ZEALAND TRANSVERSE MERCATOR 2000 PROJECTION (NZTM2000).
 2. HEIGHTS ARE IN TERMS OF NEW ZEALAND VERTICAL DATUM 2016 (NZVD2016).
 3. AS-BUILT DATA CARRIED OUT BY MAUGERS CONTRACTING LTD AND SUPPLIED TO INOVO PROJECTS LTD.
 4. ALL STORMWATER LATERALS ARE DN100 uPVC SN8.
 5. PROPOSED BOUNDARIES ARE SUBJECT TO FINAL SURVEY.
 6. EXISTING BOUNDARIES SOURCED FROM LINZ DATA SERVICE AND IS TO BE USED IN ACCORDANCE WITH THE INTERNATIONAL CREATIVE COMMONS LICENCE 4.0.
 7. ALL DIMENSIONS ARE IN METRES UNLESS STATED.

- LEGEND**
- SITE BOUNDARIES
 - SW STORMWATER MAIN
 - STORMWATER LATERAL
 - STREET LIGHT

SEE SHEETS 15721-SP3-4000'S FOR DETAILS ON SPRINGS ROAD

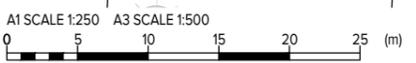

Rev#	Description	Drawn	Date
0	FOR AS-BUILT		



Scale A1 1:250
Scale A3 1:500
DO NOT SCALE FROM DRAWING


Client
EARLSBROOK LINCOLN

Project
EARLSBROOK RESIDENTIAL SUBDIVISION STAGE 1

Drawing Title
STORMWATER AS-BUILT STAGE 1 SHEET 14

Status
AS-BUILT AUG 2025


Drawing No. **15721-S1-AB-4013** Rev **0**

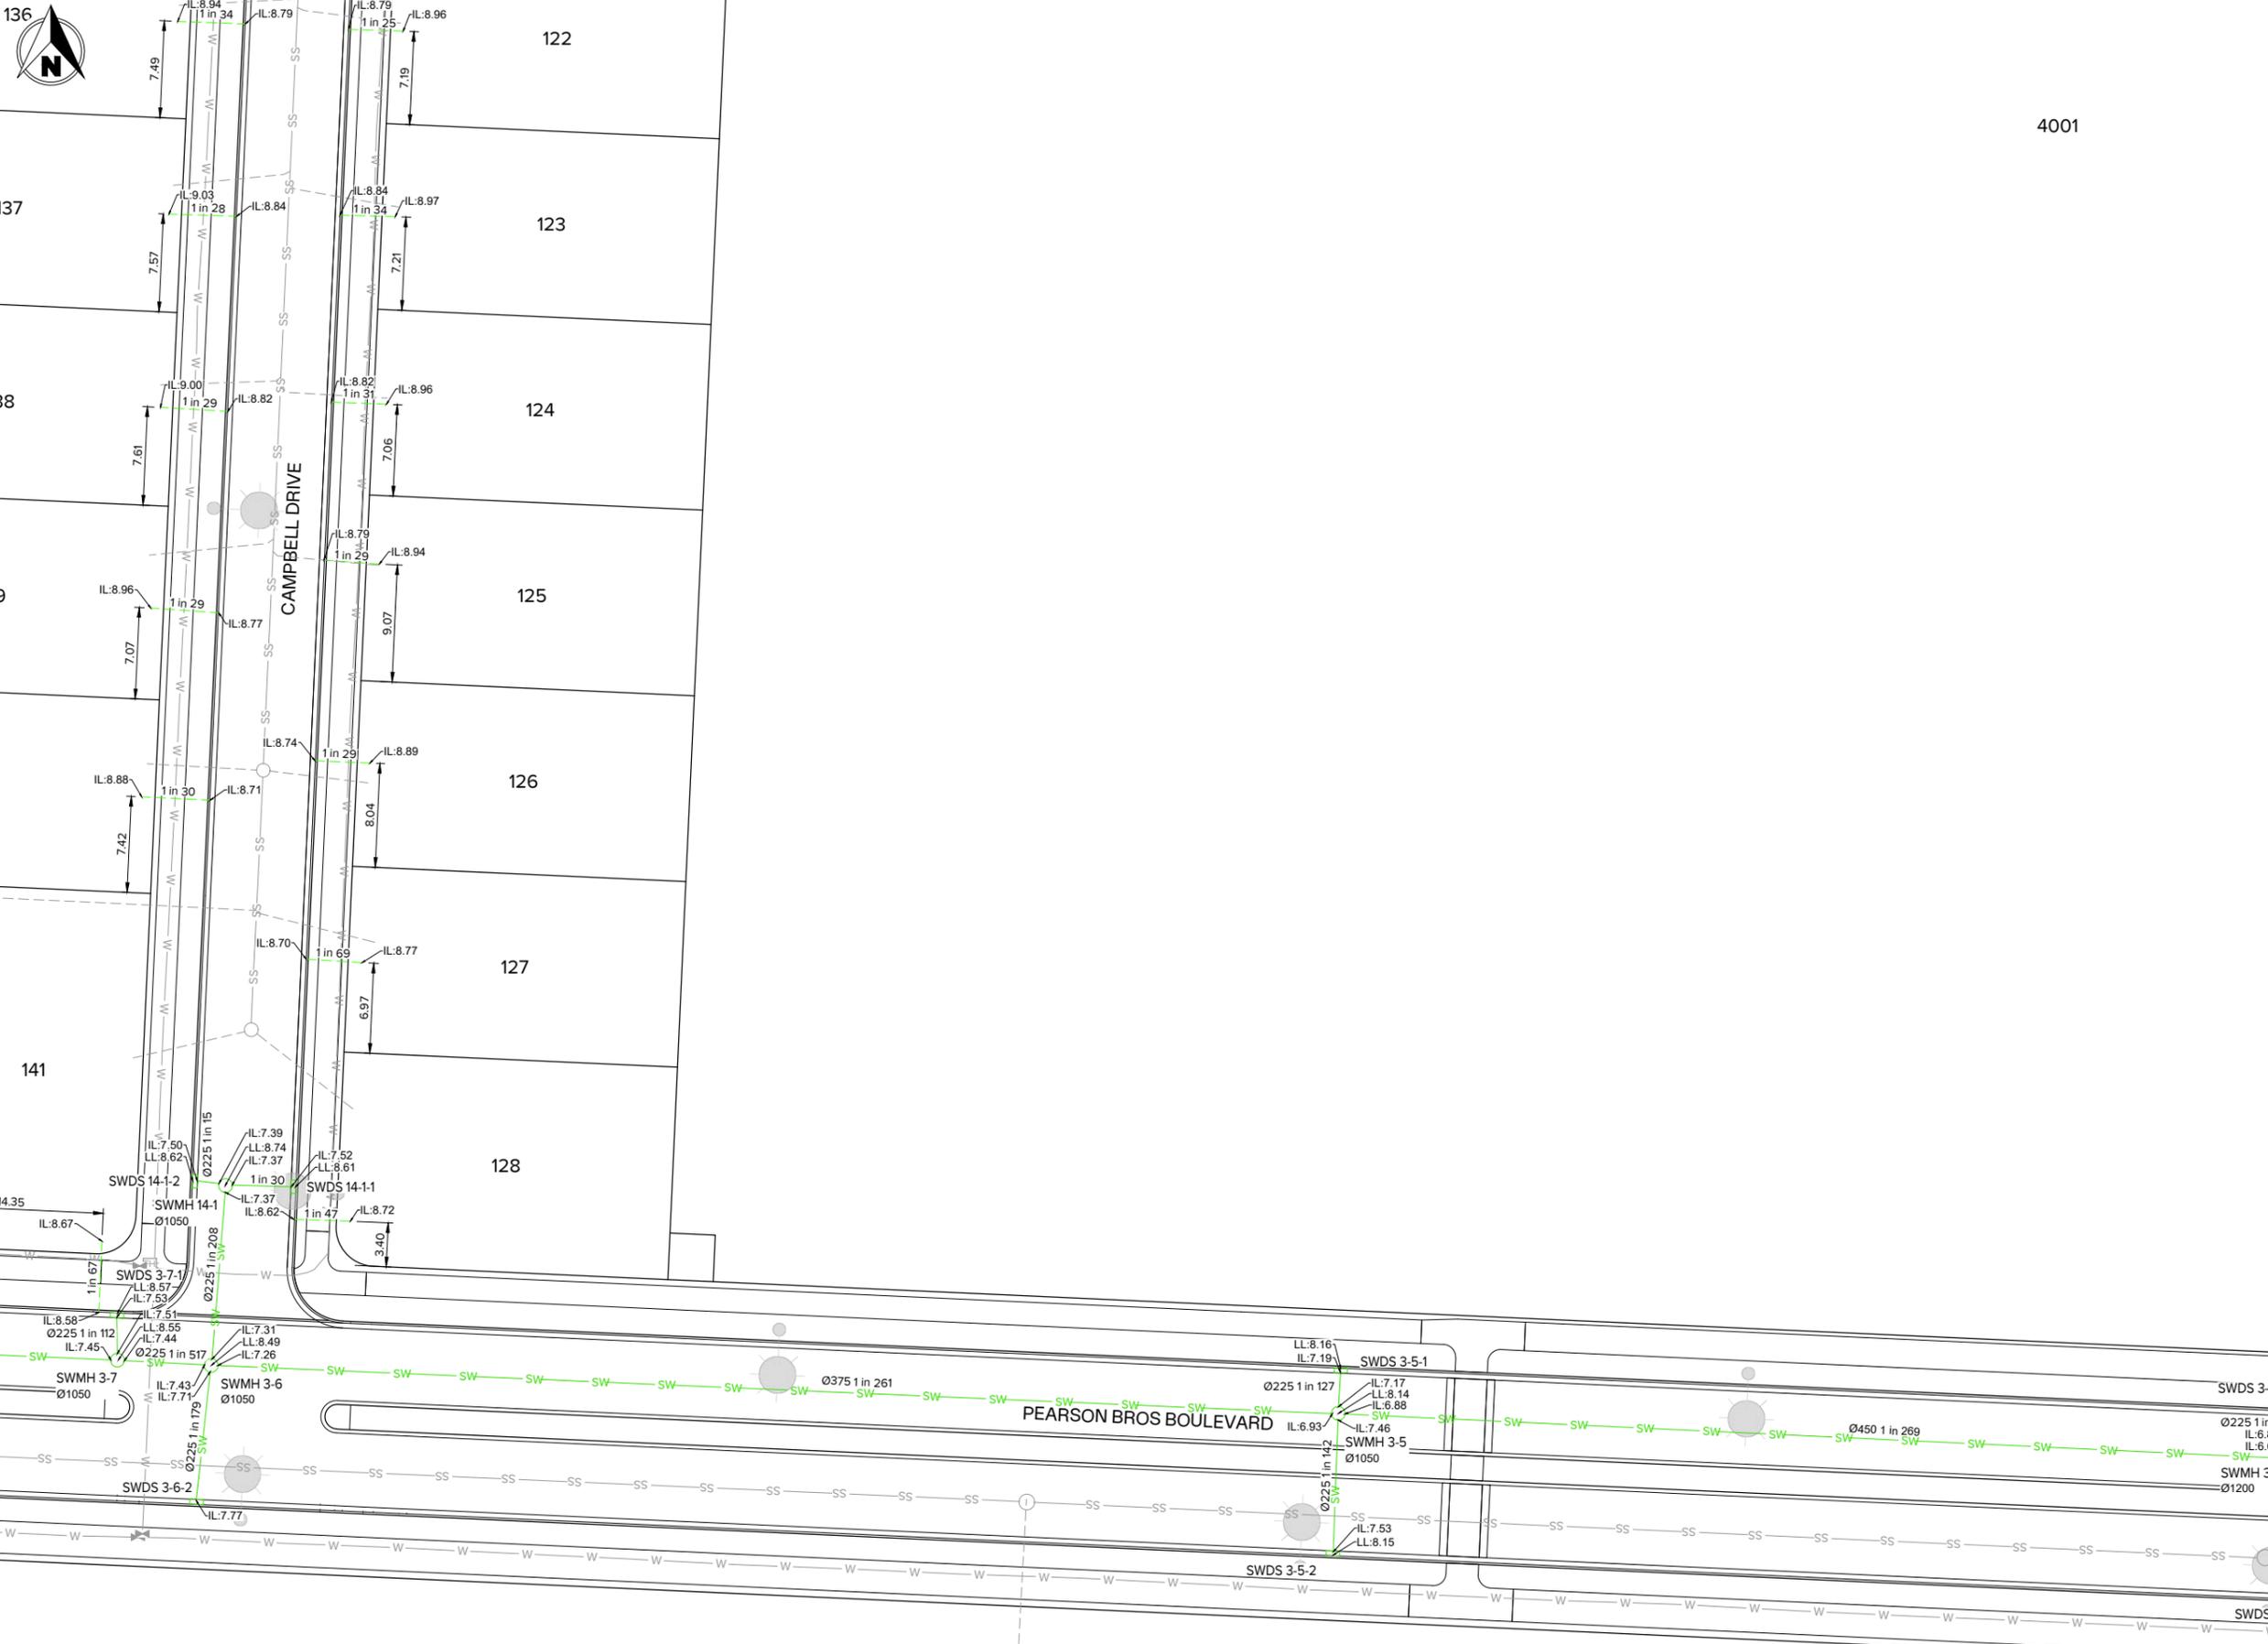

4001

- NOTES**
1. CO-ORDINATES ARE IN TERMS OF NEW ZEALAND TRANSVERSE MERCATOR 2000 PROJECTION (NZTM2000).
 2. HEIGHTS ARE IN TERMS OF NEW ZEALAND VERTICAL DATUM 2016 (NZVD2016).
 3. AS-BUILT DATA CARRIED OUT BY MAUGERS CONTRACTING LTD AND SUPPLIED TO INOVO PROJECTS LTD.
 4. ALL STORMWATER LATERALS ARE DN100 uPVC SN8.
 5. PROPOSED BOUNDARIES ARE SUBJECT TO FINAL SURVEY.
 6. EXISTING BOUNDARIES SOURCED FROM LINZ DATA SERVICE AND IS TO BE USED IN ACCORDANCE WITH THE INTERNATIONAL CREATIVE COMMONS LICENCE 4.0.
 7. ALL DIMENSIONS ARE IN METRES UNLESS STATED.

- LEGEND**
- SITE BOUNDARIES
 - SW — STORMWATER MAIN
 - - - - STORMWATER LATERAL
 - STREET LIGHT

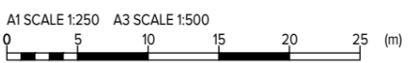

Rev#	Description	Drawn	Date
0	FOR AS-BUILT	AMcC	28.08.25



Scale A1
1:250
Scale A3
1:500
DO NOT SCALE FROM DRAWING

Drawn
AMcC
Approved
TMcL
Date
28.08.25

Client
EARLSBROOK
LINCOLN


Project
**EARLSBROOK
RESIDENTIAL SUBDIVISION
STAGE 1**

Drawing Title
**STORMWATER AS-BUILT
STAGE 1
SHEET 15**

Status
**AS-BUILT
AUG 2025**

Drawing No.
15721-S1-AB-4014

Rev
0

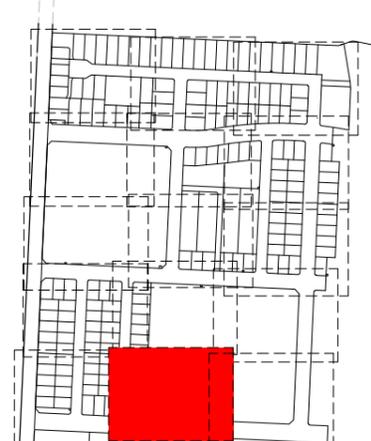



- NOTES**
1. CO-ORDINATES ARE IN TERMS OF NEW ZEALAND TRANSVERSE MERCATOR 2000 PROJECTION (NZTM2000).
 2. HEIGHTS ARE IN TERMS OF NEW ZEALAND VERTICAL DATUM 2016 (NZVD2016).
 3. AS-BUILT DATA CARRIED OUT BY MAUGERS CONTRACTING LTD AND SUPPLIED TO INOVO PROJECTS LTD.
 4. PROPOSED BOUNDARIES ARE SUBJECT TO FINAL SURVEY.
 5. EXISTING BOUNDARIES SOURCED FROM LINZ DATA SERVICE AND IS TO BE USED IN ACCORDANCE WITH THE INTERNATIONAL CREATIVE COMMONS LICENCE 4.
 6. ALL DIMENSIONS ARE IN METRES UNLESS STATED.

- LEGEND**
- - - - - SITE BOUNDARIES
 - SS-SS- WASTE WATER MAIN
 - - - - - WASTE WATER LATERAL
 - ★ STREET LIGHT

A1 SCALE 1:1500 A3 SCALE 1:3000
 0 20 40 60 80 100 150 (m)

Rev#	Description	Drawn	Date
0	FOR AS-BUILT	AMcC	28.08.25

INOVO
 Level 1, 93 Manchester St, Christchurch 8022
 Ph. 03 377 3290
 Level 1, Shed 19, Princess Wharf, Auckland 1010
 Ph. 09 600 1099
 www.inovo.nz

Scale A1
1:1,500
 Scale A3
1:3,000
 DO NOT SCALE FROM DRAWING

Drawn
AMcC
 Approved
TMcL
 Date
28.08.25

Client
EARLSBROOK
 LINCOLN


Project
**EARLSBROOK
 RESIDENTIAL SUBDIVISION
 STAGE 1**

Drawing Title
**WASTEWATER AS-BUILT
 STAGE 1
 SHEET 1**



Status
**AS-BUILT
 AUG 2025**

Drawing No.
15721-S1-AB-5000

Rev
 0

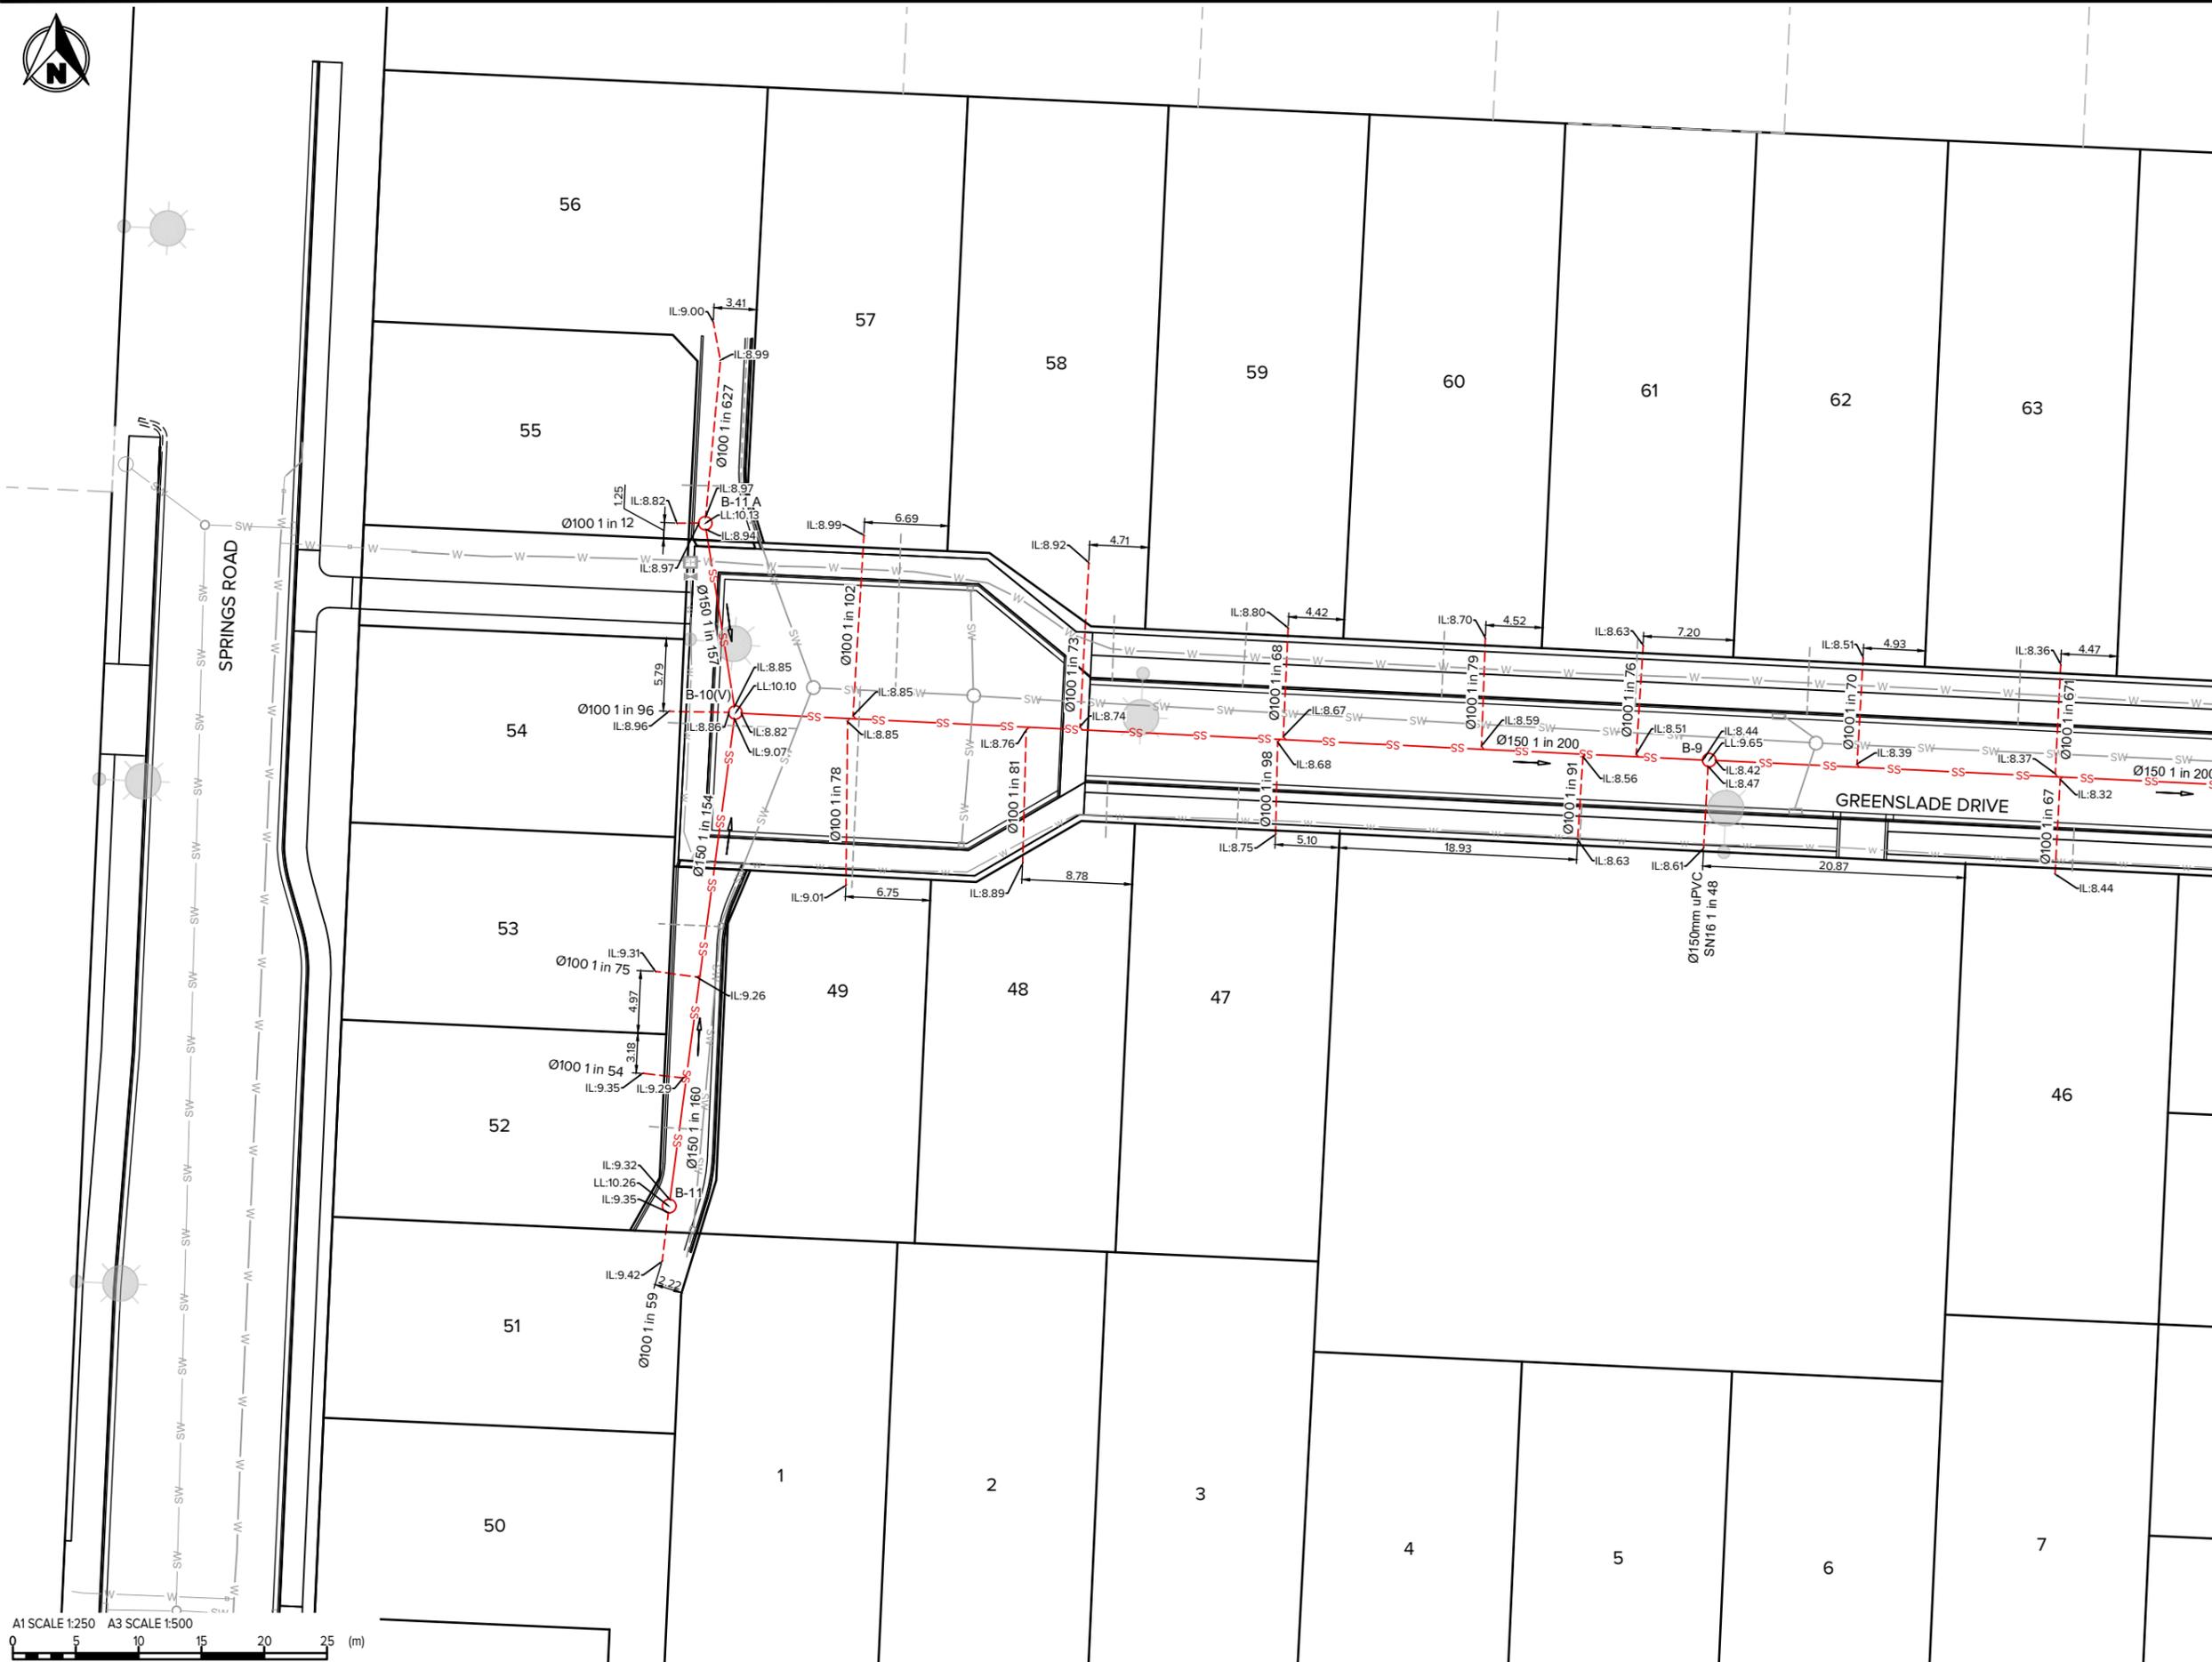

- NOTES**
1. CO-ORDINATES ARE IN TERMS OF NEW ZEALAND TRANSVERSE MERCATOR 2000 PROJECTION (NZTM2000).
 2. HEIGHTS ARE IN TERMS OF NEW ZEALAND VERTICAL DATUM 2016 (NZVD2016).
 3. AS-BUILT DATA CARRIED OUT BY MAUGERS CONTRACTING LTD AND SUPPLIED TO INOVO PROJECTS LTD.
 4. PROPOSED BOUNDARIES ARE SUBJECT TO FINAL SURVEY.
 5. EXISTING BOUNDARIES SOURCED FROM LINZ DATA SERVICE AND IS TO BE USED IN ACCORDANCE WITH THE INTERNATIONAL CREATIVE COMMONS LICENCE 4.
 6. ALL DIMENSIONS ARE IN METRES UNLESS STATED.

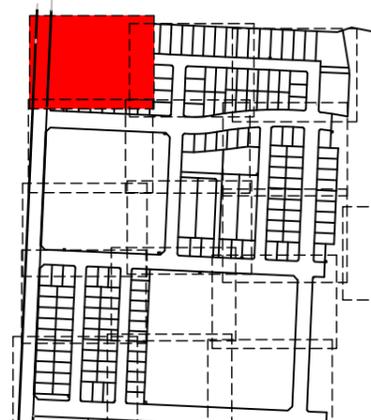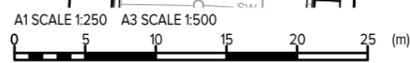

Rev#	Description	Drawn	Date
0	FOR AS-BUILT	AMcC	28.08.25

INOVO
 Level 1, 93 Manchester St, Christchurch 8022
 Ph. 03 377 3290
 Level 1, Shed 19, Princess Wharf, Auckland 1010
 Ph. 09 600 1099
 www.inovo.nz

Scale A1
1:250
 Scale A3
1:500
 DO NOT SCALE FROM DRAWING

Drawn
AMcC
 Approved
TMcL
 Date
28.08.25



Client
EARLSBROOK LINCOLN
 Project
EARLSBROOK RESIDENTIAL SUBDIVISION STAGE 1

Drawing Title
WASTEWATER AS-BUILT STAGE 1 SHEET 2

Status
AS-BUILT AUG 2025
 Drawing No.
15721-S1-AB-5001
 Rev
0



- NOTES**
1. CO-ORDINATES ARE IN TERMS OF NEW ZEALAND TRANSVERSE MERCATOR 2000 PROJECTION (NZTM2000).
 2. HEIGHTS ARE IN TERMS OF NEW ZEALAND VERTICAL DATUM 2016 (NZVD2016).
 3. AS-BUILT DATA CARRIED OUT BY MAUGERS CONTRACTING LTD AND SUPPLIED TO INOVO PROJECTS LTD.
 4. PROPOSED BOUNDARIES ARE SUBJECT TO FINAL SURVEY.
 5. EXISTING BOUNDARIES SOURCED FROM LINZ DATA SERVICE AND IS TO BE USED IN ACCORDANCE WITH THE INTERNATIONAL CREATIVE COMMONS LICENCE 4.
 6. ALL DIMENSIONS ARE IN METRES UNLESS STATED.

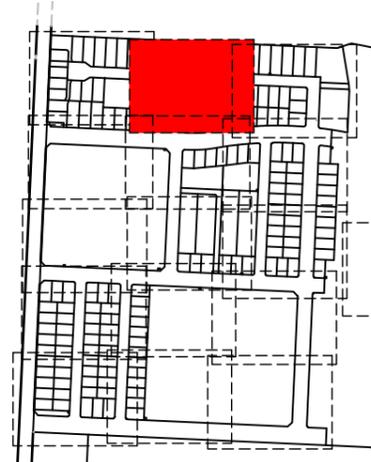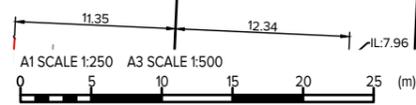

Rev#	Description	Drawn	Date

INOVO
 Level 1, 93 Manchester St, Christchurch 8022
 Ph. 03 377 3290
 Level 1, Shed 19, Princess Wharf, Auckland 1010
 Ph. 09 600 1099
 www.inovo.nz

Scale A1
1:250
Scale A3
1:500
DO NOT SCALE FROM DRAWING

Drawn
AMcC
Approved
TMCL
Date
28.08.25


Client
EARLSBROOK LINCOLN
Project
EARLSBROOK RESIDENTIAL SUBDIVISION STAGE 1

Drawing Title
WASTEWATER AS-BUILT STAGE 1 SHEET 3

Status
AS-BUILT AUG 2025
Drawing No.
15721-S1-AB-5002 Rev
0



- NOTES**
1. CO-ORDINATES ARE IN TERMS OF NEW ZEALAND TRANSVERSE MERCATOR 2000 PROJECTION (NZTM2000).
 2. HEIGHTS ARE IN TERMS OF NEW ZEALAND VERTICAL DATUM 2016 (NZVD2016).
 3. AS-BUILT DATA CARRIED OUT BY MAUGERS CONTRACTING LTD AND SUPPLIED TO INOVO PROJECTS LTD.
 4. PROPOSED BOUNDARIES ARE SUBJECT TO FINAL SURVEY.
 5. EXISTING BOUNDARIES SOURCED FROM LINZ DATA SERVICE AND IS TO BE USED IN ACCORDANCE WITH THE INTERNATIONAL CREATIVE COMMONS LICENCE 4.
 6. ALL DIMENSIONS ARE IN METRES UNLESS STATED.

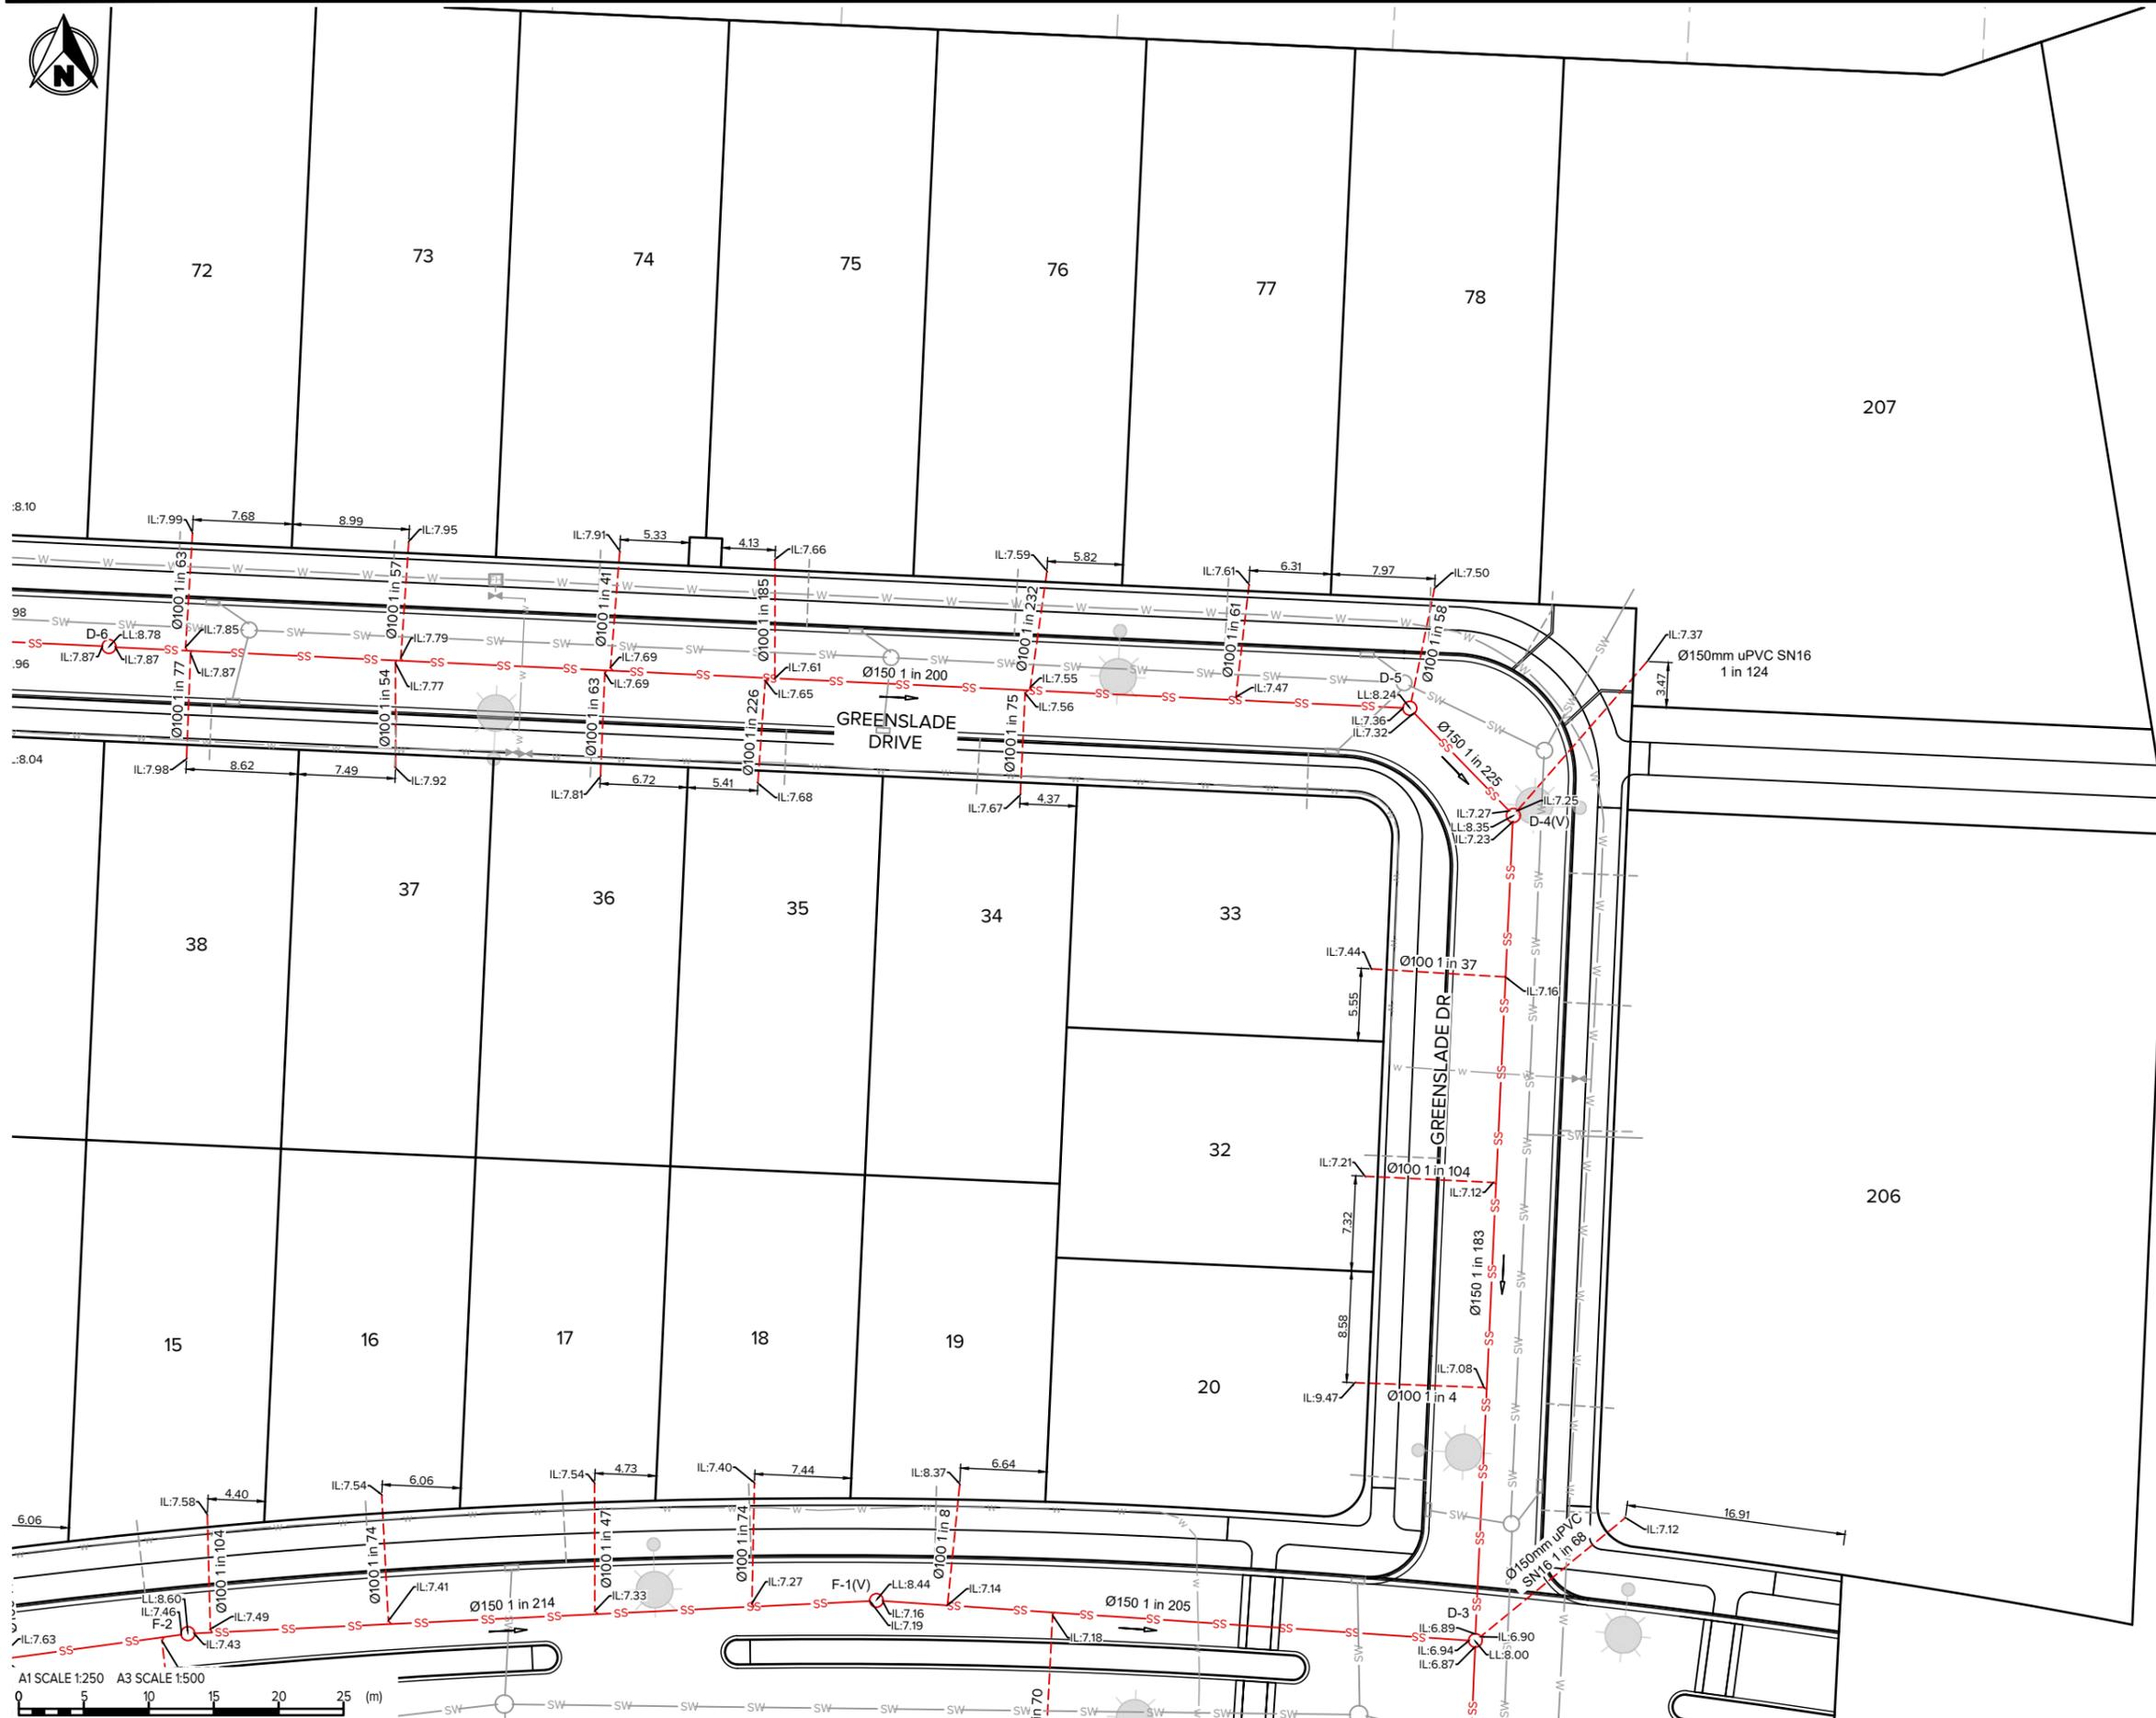

- LEGEND**
- SITE BOUNDARIES
 - SS SS WASTE WATER MAIN
 - SS WASTE WATER LATERAL
 - ★ STREET LIGHT



A1 SCALE 1:250 A3 SCALE 1:500
 0 5 10 15 20 25 (m)

Rev#	Description	Drawn	Date



Level 1, 93 Manchester St, Christchurch 8022
 Ph. 03 377 3290
 Level 1, Shed 19, Princess Wharf, Auckland 1010
 Ph. 09 600 1099
 www.inovo.nz

Scale A1
1:250
 Scale A3
1:500
 DO NOT SCALE FROM DRAWING


Drawn
AMcC
 Approved
TMCL
 Date
28.08.25



Client
EARLSBROOK LINCOLN
 Project
EARLSBROOK RESIDENTIAL SUBDIVISION STAGE 1


Drawing Title
WASTEWATER AS-BUILT STAGE 1 SHEET 4

Status
AS-BUILT AUG 2025
 Drawing No.
15721-S1-AB-5003 Rev
0

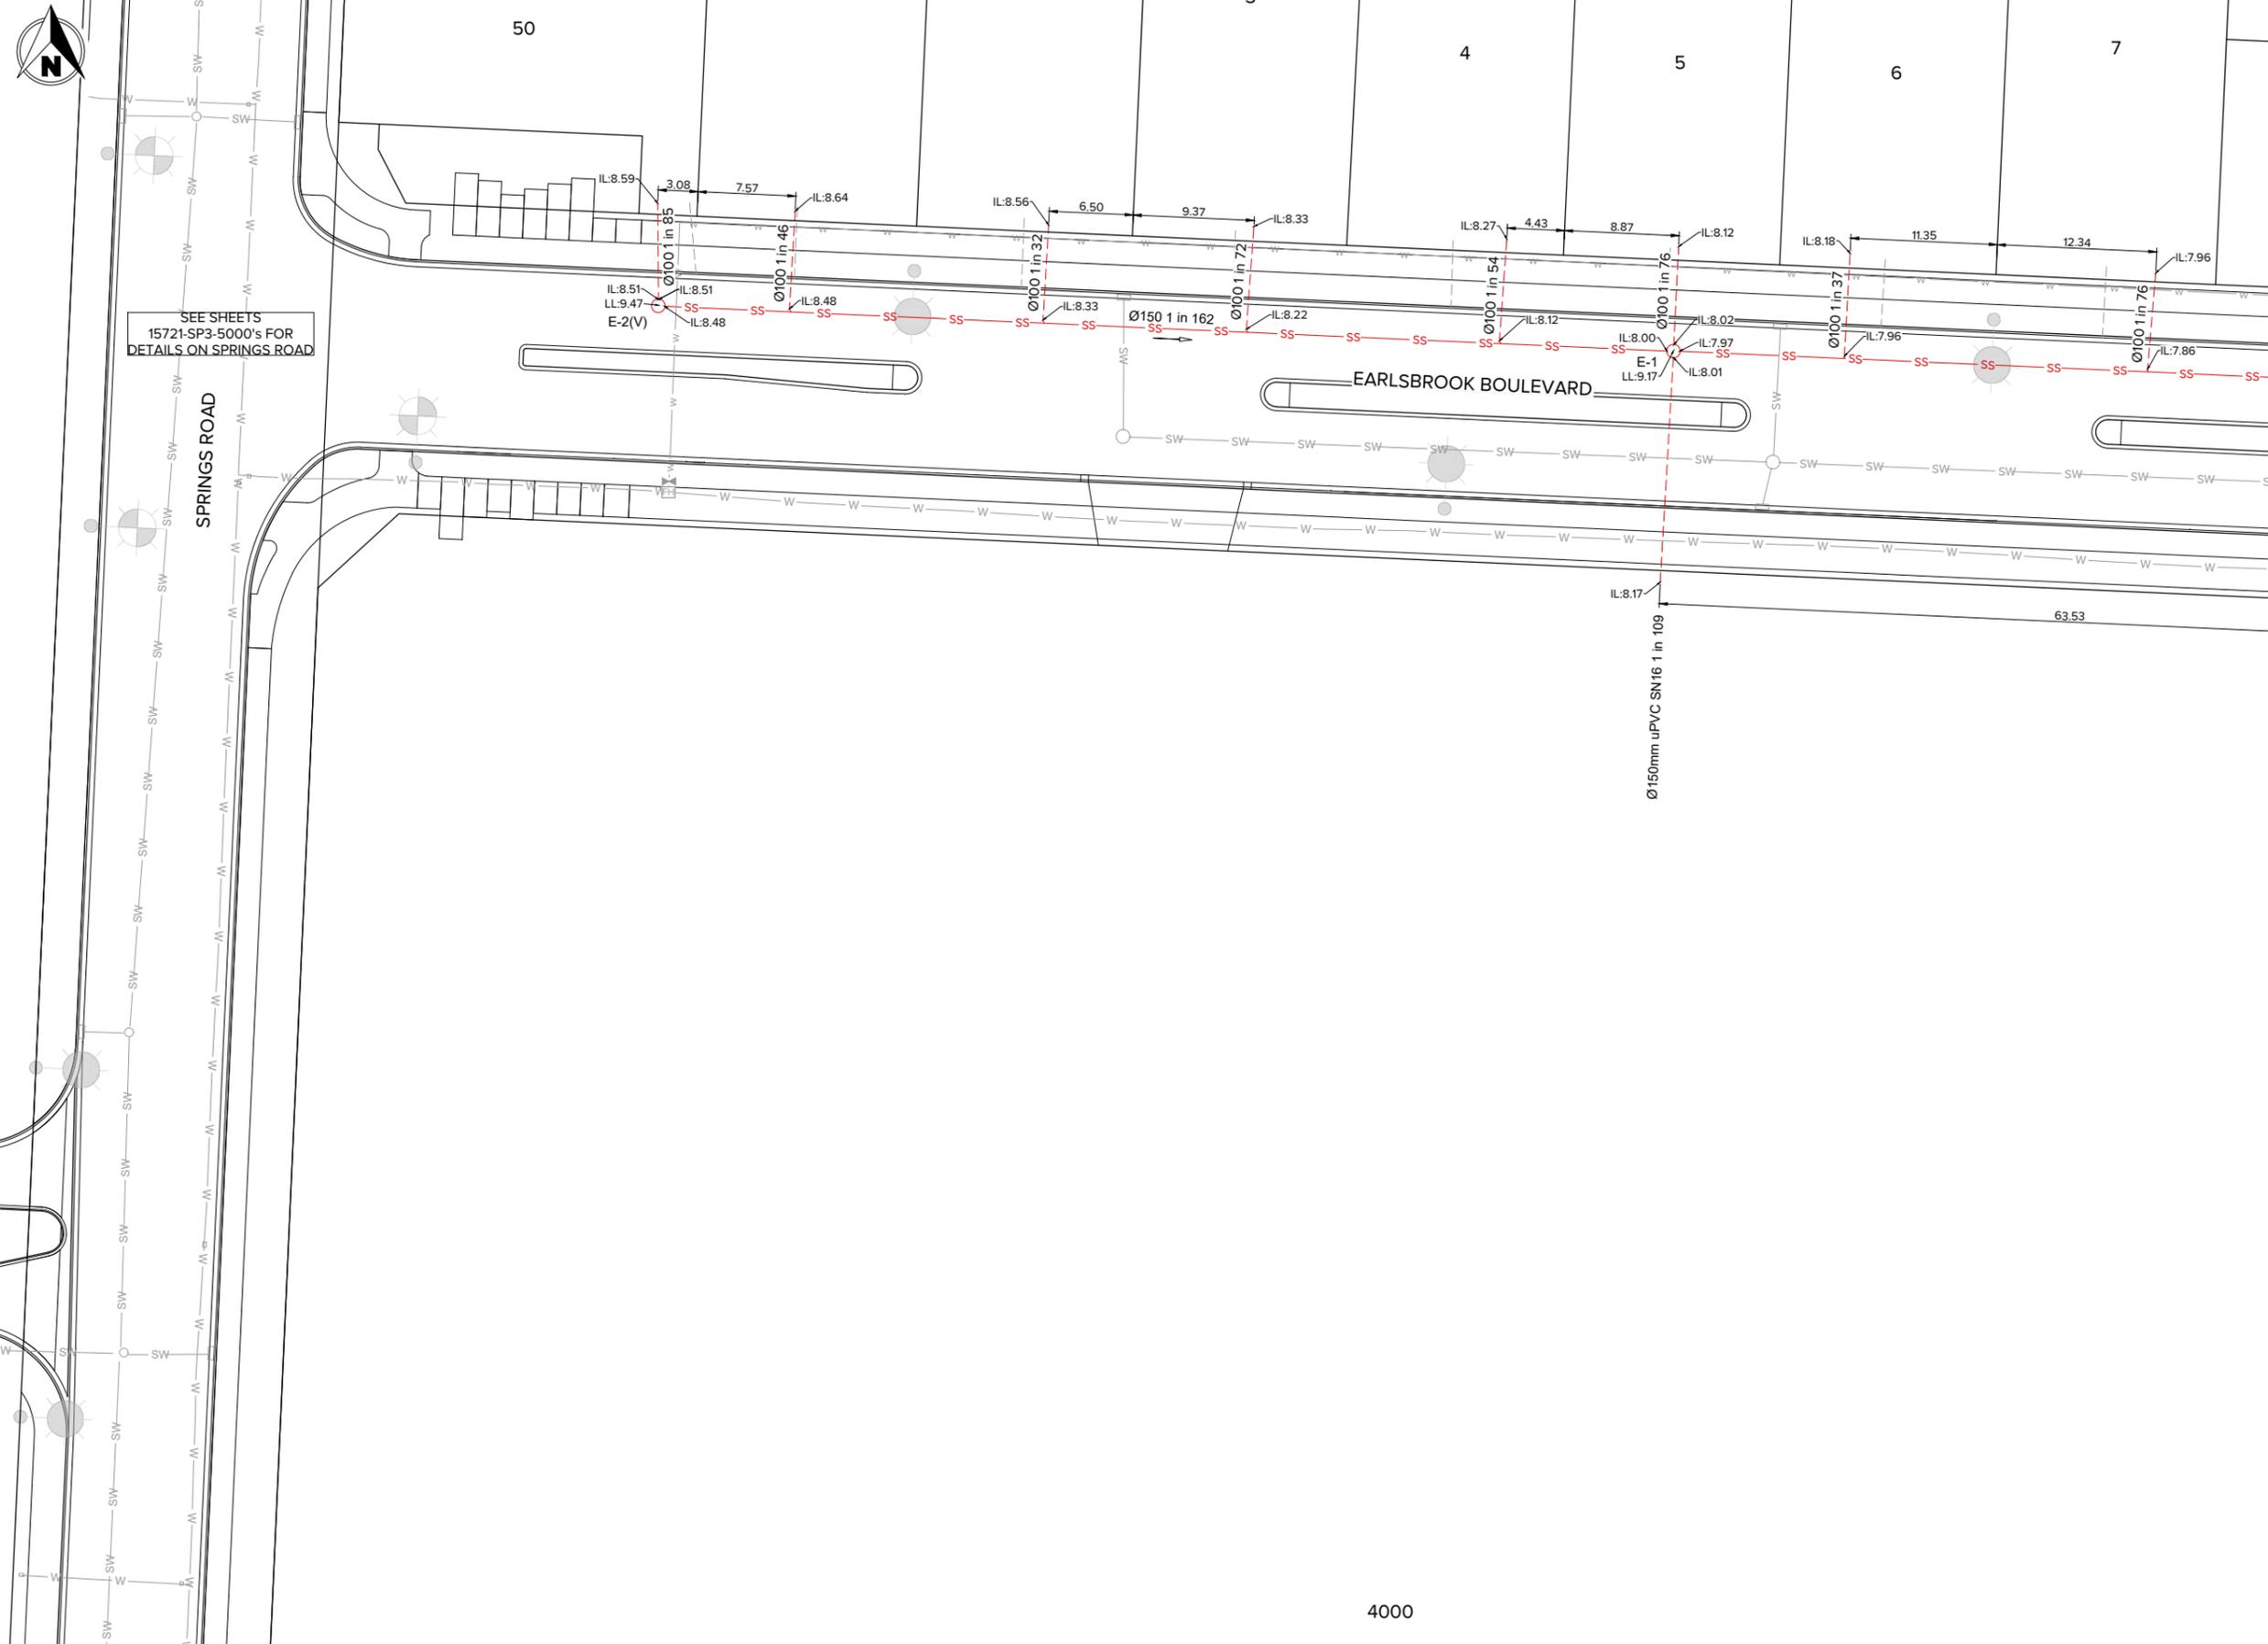

- NOTES**
1. CO-ORDINATES ARE IN TERMS OF NEW ZEALAND TRANSVERSE MERCATOR 2000 PROJECTION (NZTM2000).
 2. HEIGHTS ARE IN TERMS OF NEW ZEALAND VERTICAL DATUM 2016 (NZVD2016).
 3. AS-BUILT DATA CARRIED OUT BY MAUGERS CONTRACTING LTD AND SUPPLIED TO INOVO PROJECTS LTD.
 4. PROPOSED BOUNDARIES ARE SUBJECT TO FINAL SURVEY.
 5. EXISTING BOUNDARIES SOURCED FROM LINZ DATA SERVICE AND IS TO BE USED IN ACCORDANCE WITH THE INTERNATIONAL CREATIVE COMMONS LICENCE 4.
 6. ALL DIMENSIONS ARE IN METRES UNLESS STATED.

- LEGEND**
- SITE BOUNDARIES
 - SS--- SS--- WASTE WATER MAIN
 - WASTE WATER LATERAL
 - STREET LIGHT

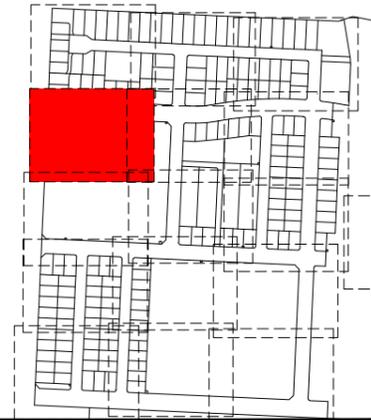

SEE SHEETS
15721-SP3-5000's FOR
DETAILS ON SPRINGS ROAD

A1 SCALE 1:250 A3 SCALE 1:500
0 5 10 15 20 25 (m)

Rev#	Description	Drawn	Date
0	FOR AS-BUILT	IAMcC	28.08.25

INOVO
Level 1, 93 Manchester St, Christchurch 8022
Ph. 03 377 3290
Level 1, Shed 19, Princess Wharf, Auckland 1010
Ph. 09 600 1099
www.inovo.nz

Scale A1
1:250
Scale A3
1:500
DO NOT SCALE FROM DRAWING


Drawn
AMcC
Approved
TMcL
Date
28.08.25

Client
EARLSBROOK
LINCOLN

Project
**EARLSBROOK
RESIDENTIAL SUBDIVISION
STAGE 1**

Drawing Title
**WASTEWATER AS-BUILT
STAGE 1
SHEET 5**

Status
**AS-BUILT
AUG 2025**
Drawing No.
15721-S1-AB-5004 Rev
0

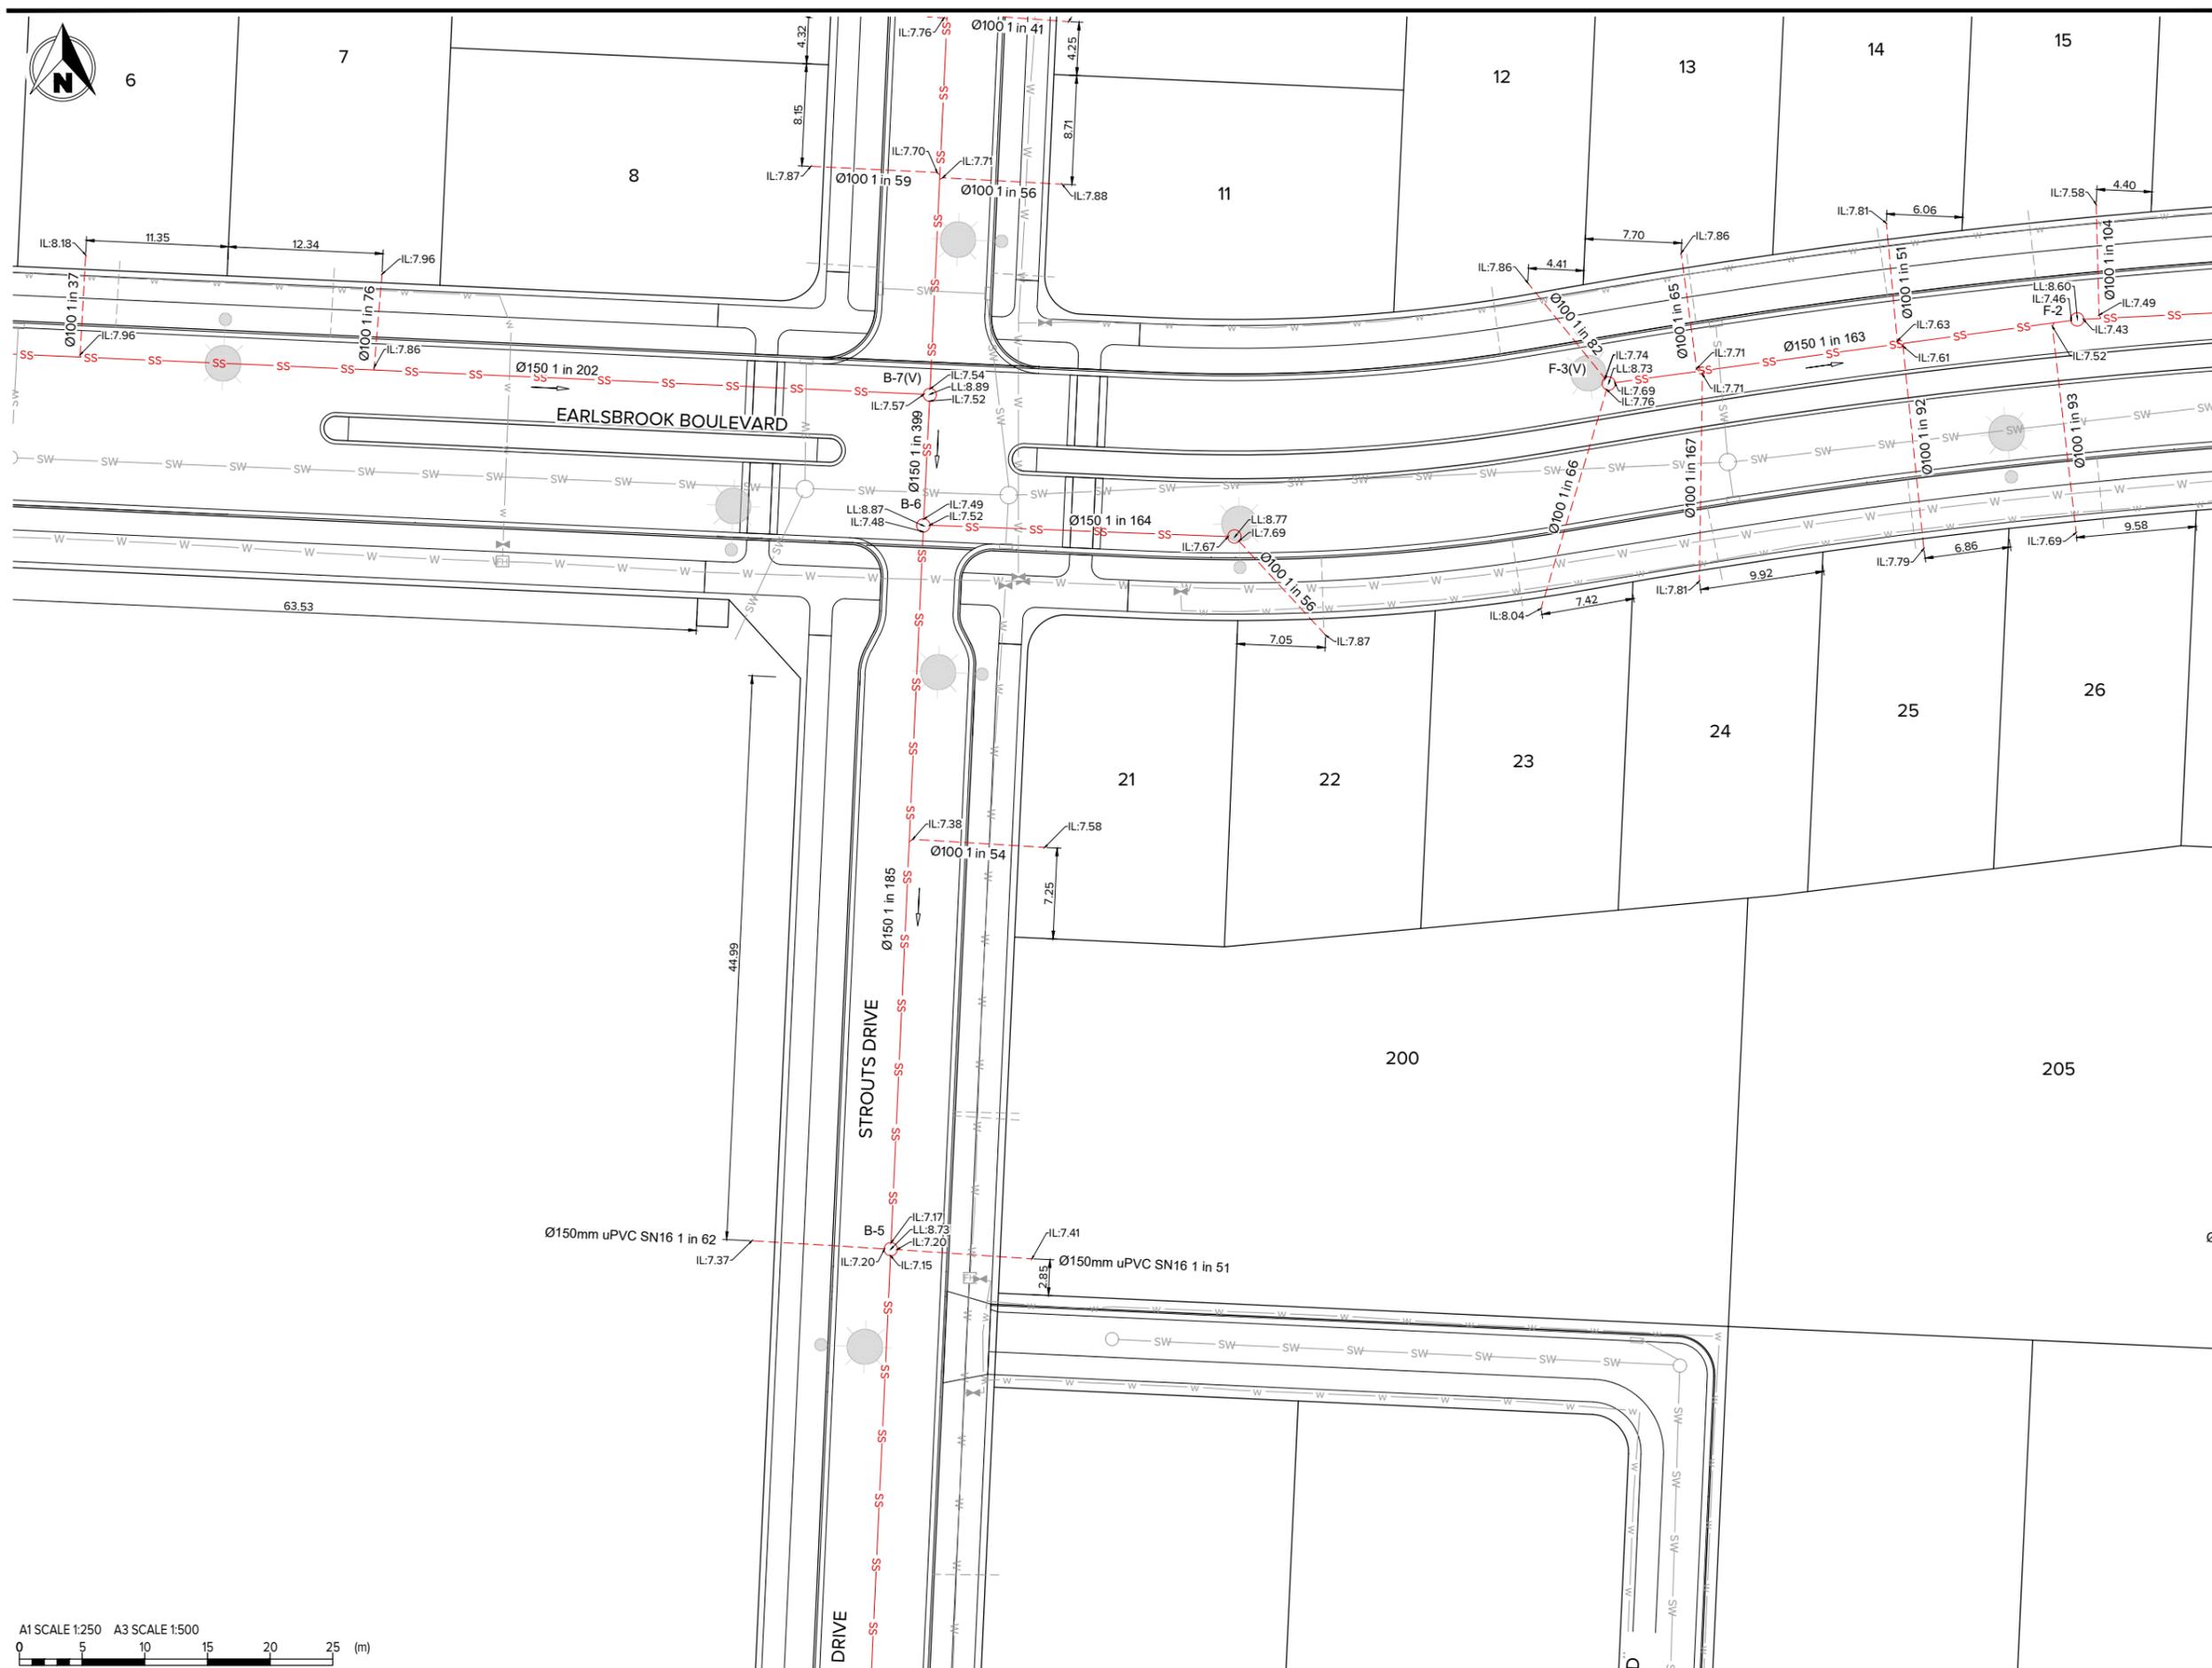

- NOTES**
1. CO-ORDINATES ARE IN TERMS OF NEW ZEALAND TRANSVERSE MERCATOR 2000 PROJECTION (NZTM2000).
 2. HEIGHTS ARE IN TERMS OF NEW ZEALAND VERTICAL DATUM 2016 (NZVD2016).
 3. AS-BUILT DATA CARRIED OUT BY MAUGERS CONTRACTING LTD AND SUPPLIED TO INOVO PROJECTS LTD.
 4. PROPOSED BOUNDARIES ARE SUBJECT TO FINAL SURVEY.
 5. EXISTING BOUNDARIES SOURCED FROM LINZ DATA SERVICE AND IS TO BE USED IN ACCORDANCE WITH THE INTERNATIONAL CREATIVE COMMONS LICENCE 4.
 6. ALL DIMENSIONS ARE IN METRES UNLESS STATED.

- LEGEND**
- SITE BOUNDARIES
 - SS WASTE WATER MAIN
 - WASTE WATER LATERAL
 - STREET LIGHT



Rev#	Description	Drawn	Date
0	FOR AS-BUILT	IAMcC	28.08.25

INOVO
 Level 1, 93 Manchester St, Christchurch 8022
 Ph. 03 377 3290
 Level 1, Shed 19, Princess Wharf, Auckland 1010
 Ph. 09 600 1099
 www.inovo.nz

Scale A1
1:250
Scale A3
1:500
DO NOT SCALE FROM DRAWING

Drawn
AMcC
Approved
TMcL
Date
28.08.25

Client
EARLSBROOK
LINCOLN


Project
EARLSBROOK
RESIDENTIAL SUBDIVISION
STAGE 1

Drawing Title
WASTEWATER AS-BUILT
STAGE 1
SHEET 6

Status
AS-BUILT
AUG 2025

Drawing No.
15721-S1-AB-5005


Rev
0

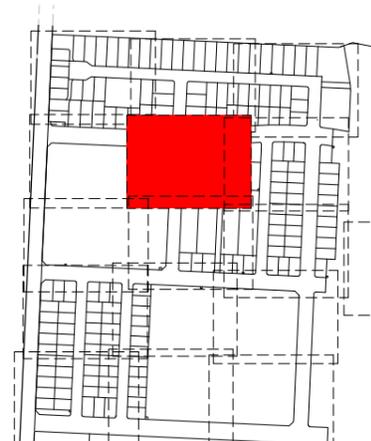



- NOTES**
1. CO-ORDINATES ARE IN TERMS OF NEW ZEALAND TRANSVERSE MERCATOR 2000 PROJECTION (NZTM2000).
 2. HEIGHTS ARE IN TERMS OF NEW ZEALAND VERTICAL DATUM 2016 (NZVD2016).
 3. AS-BUILT DATA CARRIED OUT BY MAUGERS CONTRACTING LTD AND SUPPLIED TO INOVO PROJECTS LTD.
 4. PROPOSED BOUNDARIES ARE SUBJECT TO FINAL SURVEY.
 5. EXISTING BOUNDARIES SOURCED FROM LINZ DATA SERVICE AND IS TO BE USED IN ACCORDANCE WITH THE INTERNATIONAL CREATIVE COMMONS LICENCE 4.
 6. ALL DIMENSIONS ARE IN METRES UNLESS STATED.

- LEGEND**
- SITE BOUNDARIES
 - SS WASTE WATER MAIN
 - - - WASTE WATER LATERAL
 - ☼ STREET LIGHT

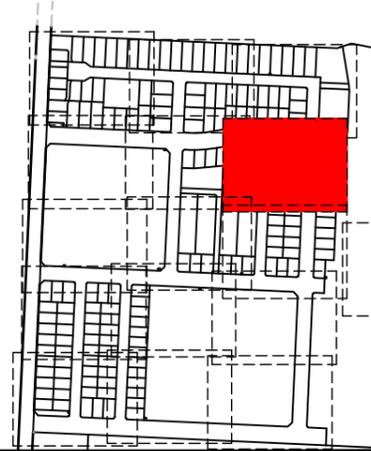

A1 SCALE 1:250 A3 SCALE 1:500
 0 5 10 15 20 25 (m)

Rev#	Description	Drawn	Date
0	FOR AS-BUILT	AMcC	28.08.25



Level 1, 93 Manchester St, Christchurch 8022
 Ph. 03 377 3290
 Level 1, Shed 19, Princess Wharf, Auckland 1010
 Ph. 09 600 1099
 www.inovo.nz

Scale A1
1:250
Scale A3
1:500
DO NOT SCALE FROM DRAWING

Drawn
AMcC
Approved
TMCL
Date
28.08.25



Project
**EARLSBROOK
RESIDENTIAL SUBDIVISION
STAGE 1**

Drawing Title
**WASTEWATER AS-BUILT
STAGE 1
SHEET 7**



Status
**AS-BUILT
AUG 2025**
 Drawing No.
15721-S1-AB-5006 Rev
0



4000

- NOTES**
1. CO-ORDINATES ARE IN TERMS OF NEW ZEALAND TRANSVERSE MERCATOR 2000 PROJECTION (NZTM2000).
 2. HEIGHTS ARE IN TERMS OF NEW ZEALAND VERTICAL DATUM 2016 (NZVD2016).
 3. AS-BUILT DATA CARRIED OUT BY MAUGERS CONTRACTING LTD AND SUPPLIED TO INOVO PROJECTS LTD.
 4. PROPOSED BOUNDARIES ARE SUBJECT TO FINAL SURVEY.
 5. EXISTING BOUNDARIES SOURCED FROM LINZ DATA SERVICE AND IS TO BE USED IN ACCORDANCE WITH THE INTERNATIONAL CREATIVE COMMONS LICENCE 4.
 6. ALL DIMENSIONS ARE IN METRES UNLESS STATED.

- LEGEND**
- SITE BOUNDARIES
 - SS --- WASTE WATER MAIN
 - WASTE WATER LATERAL
 - STREET LIGHT

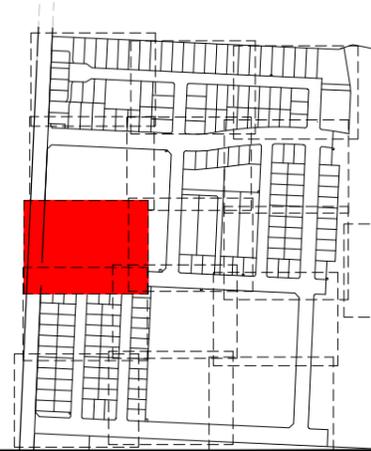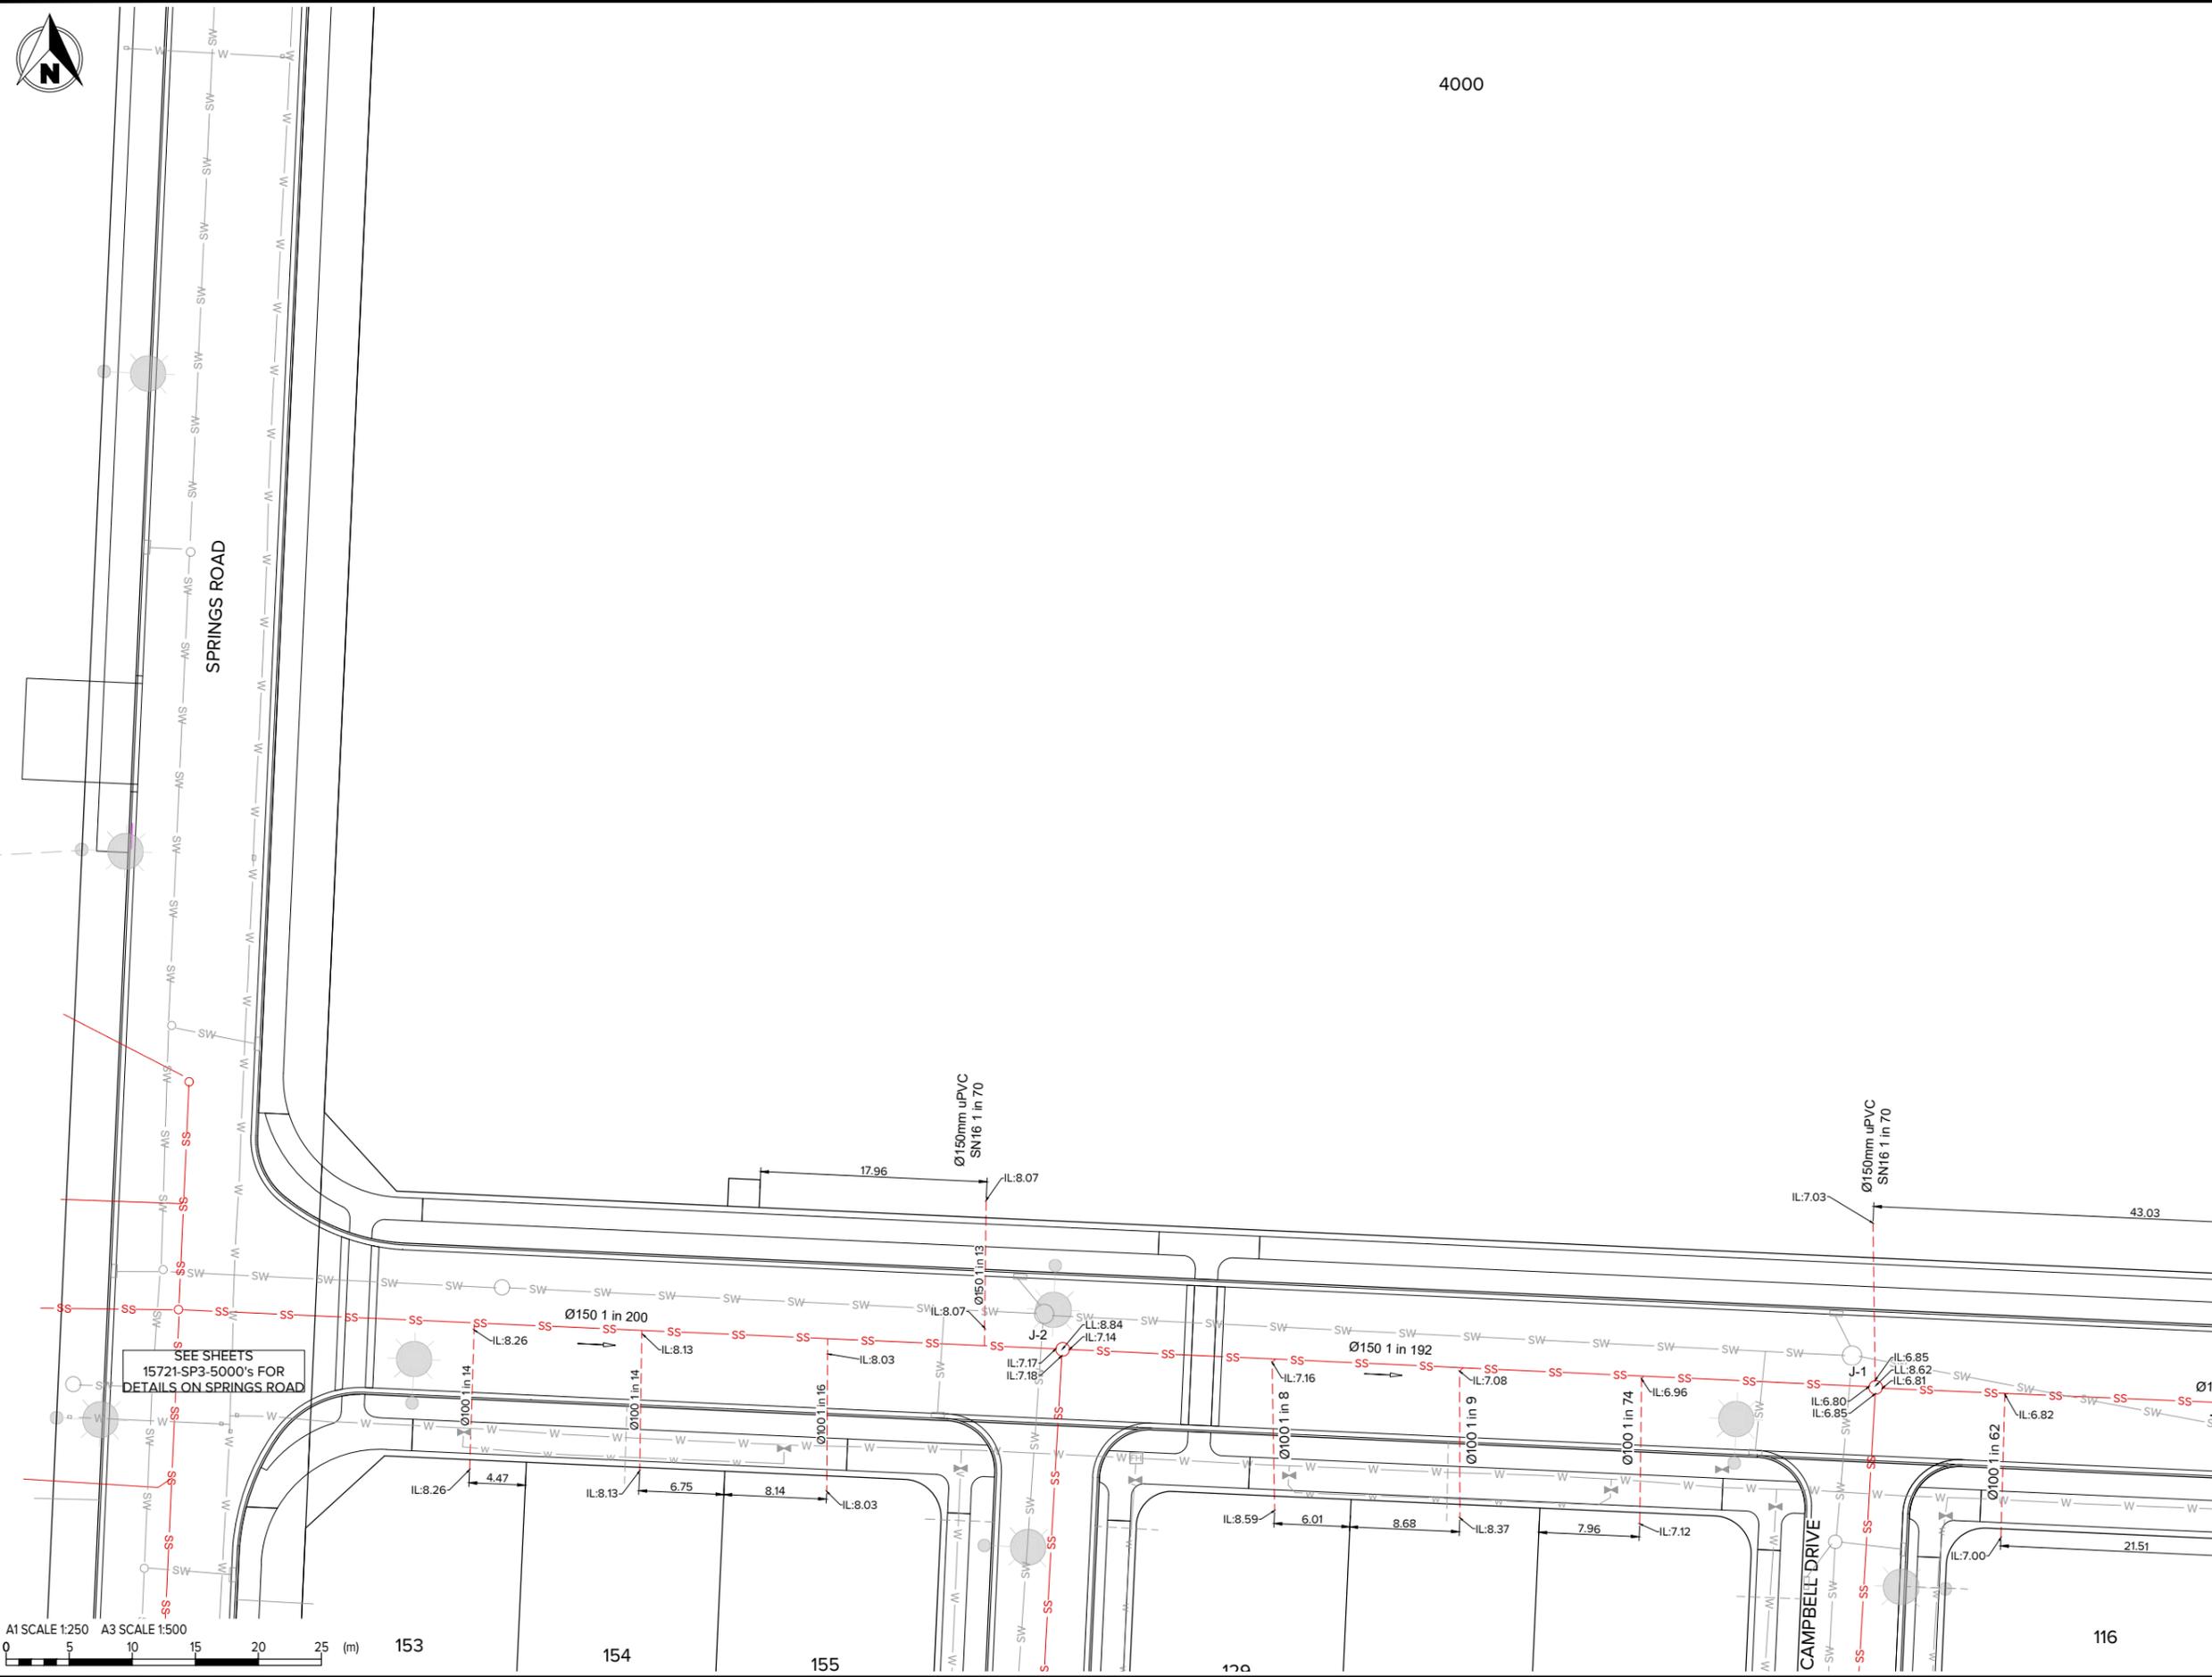

A1 SCALE 1:250 A3 SCALE 1:500
 0 5 10 15 20 25 (m) 153 154 155 120 116

Rev#	Description	Drawn	Date
0	FOR AS-BUILT	IAMcC	28.08.25

INOVO
 Level 1, 93 Manchester St, Christchurch 8022
 Ph. 03 377 3290
 Level 1, Shed 19, Princess Wharf, Auckland 1010
 Ph. 09 600 1099
 www.inovo.nz

Scale A1 1:250
 Scale A3 1:500
 DO NOT SCALE FROM DRAWING

Drawn AMcC
 Approved TMcL
 Date 28.08.25

Client **EARLSBROOK LINCOLN**

Project **EARLSBROOK RESIDENTIAL SUBDIVISION STAGE 1**

Drawing Title **WASTEWATER AS-BUILT STAGE 1 SHEET 8**

Status **AS-BUILT AUG 2025**

Drawing No. **15721-S1-AB-5007** Rev 0





NOTES

1. CO-ORDINATES ARE IN TERMS OF NEW ZEALAND TRANSVERSE MERCATOR 2000 PROJECTION (NZTM2000).
2. HEIGHTS ARE IN TERMS OF NEW ZEALAND VERTICAL DATUM 2016 (NZVD2016).
3. AS-BUILT DATA CARRIED OUT BY MAUGERS CONTRACTING LTD AND SUPPLIED TO INOVO PROJECTS LTD.
4. PROPOSED BOUNDARIES ARE SUBJECT TO FINAL SURVEY.
5. EXISTING BOUNDARIES SOURCED FROM LINZ DATA SERVICE AND IS TO BE USED IN ACCORDANCE WITH THE INTERNATIONAL CREATIVE COMMONS LICENCE 4.
6. ALL DIMENSIONS ARE IN METRES UNLESS STATED.

LEGEND

- - - - - SITE BOUNDARIES
- SS-SS- WASTE WATER MAIN
- - - - - WASTE WATER LATERAL
- ⊙ STREET LIGHT

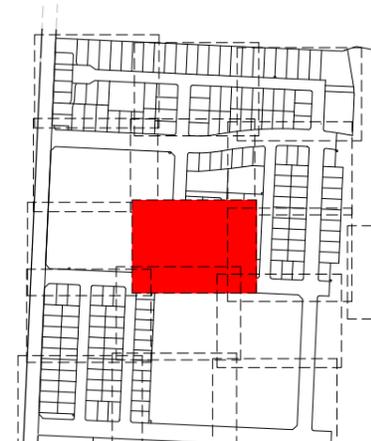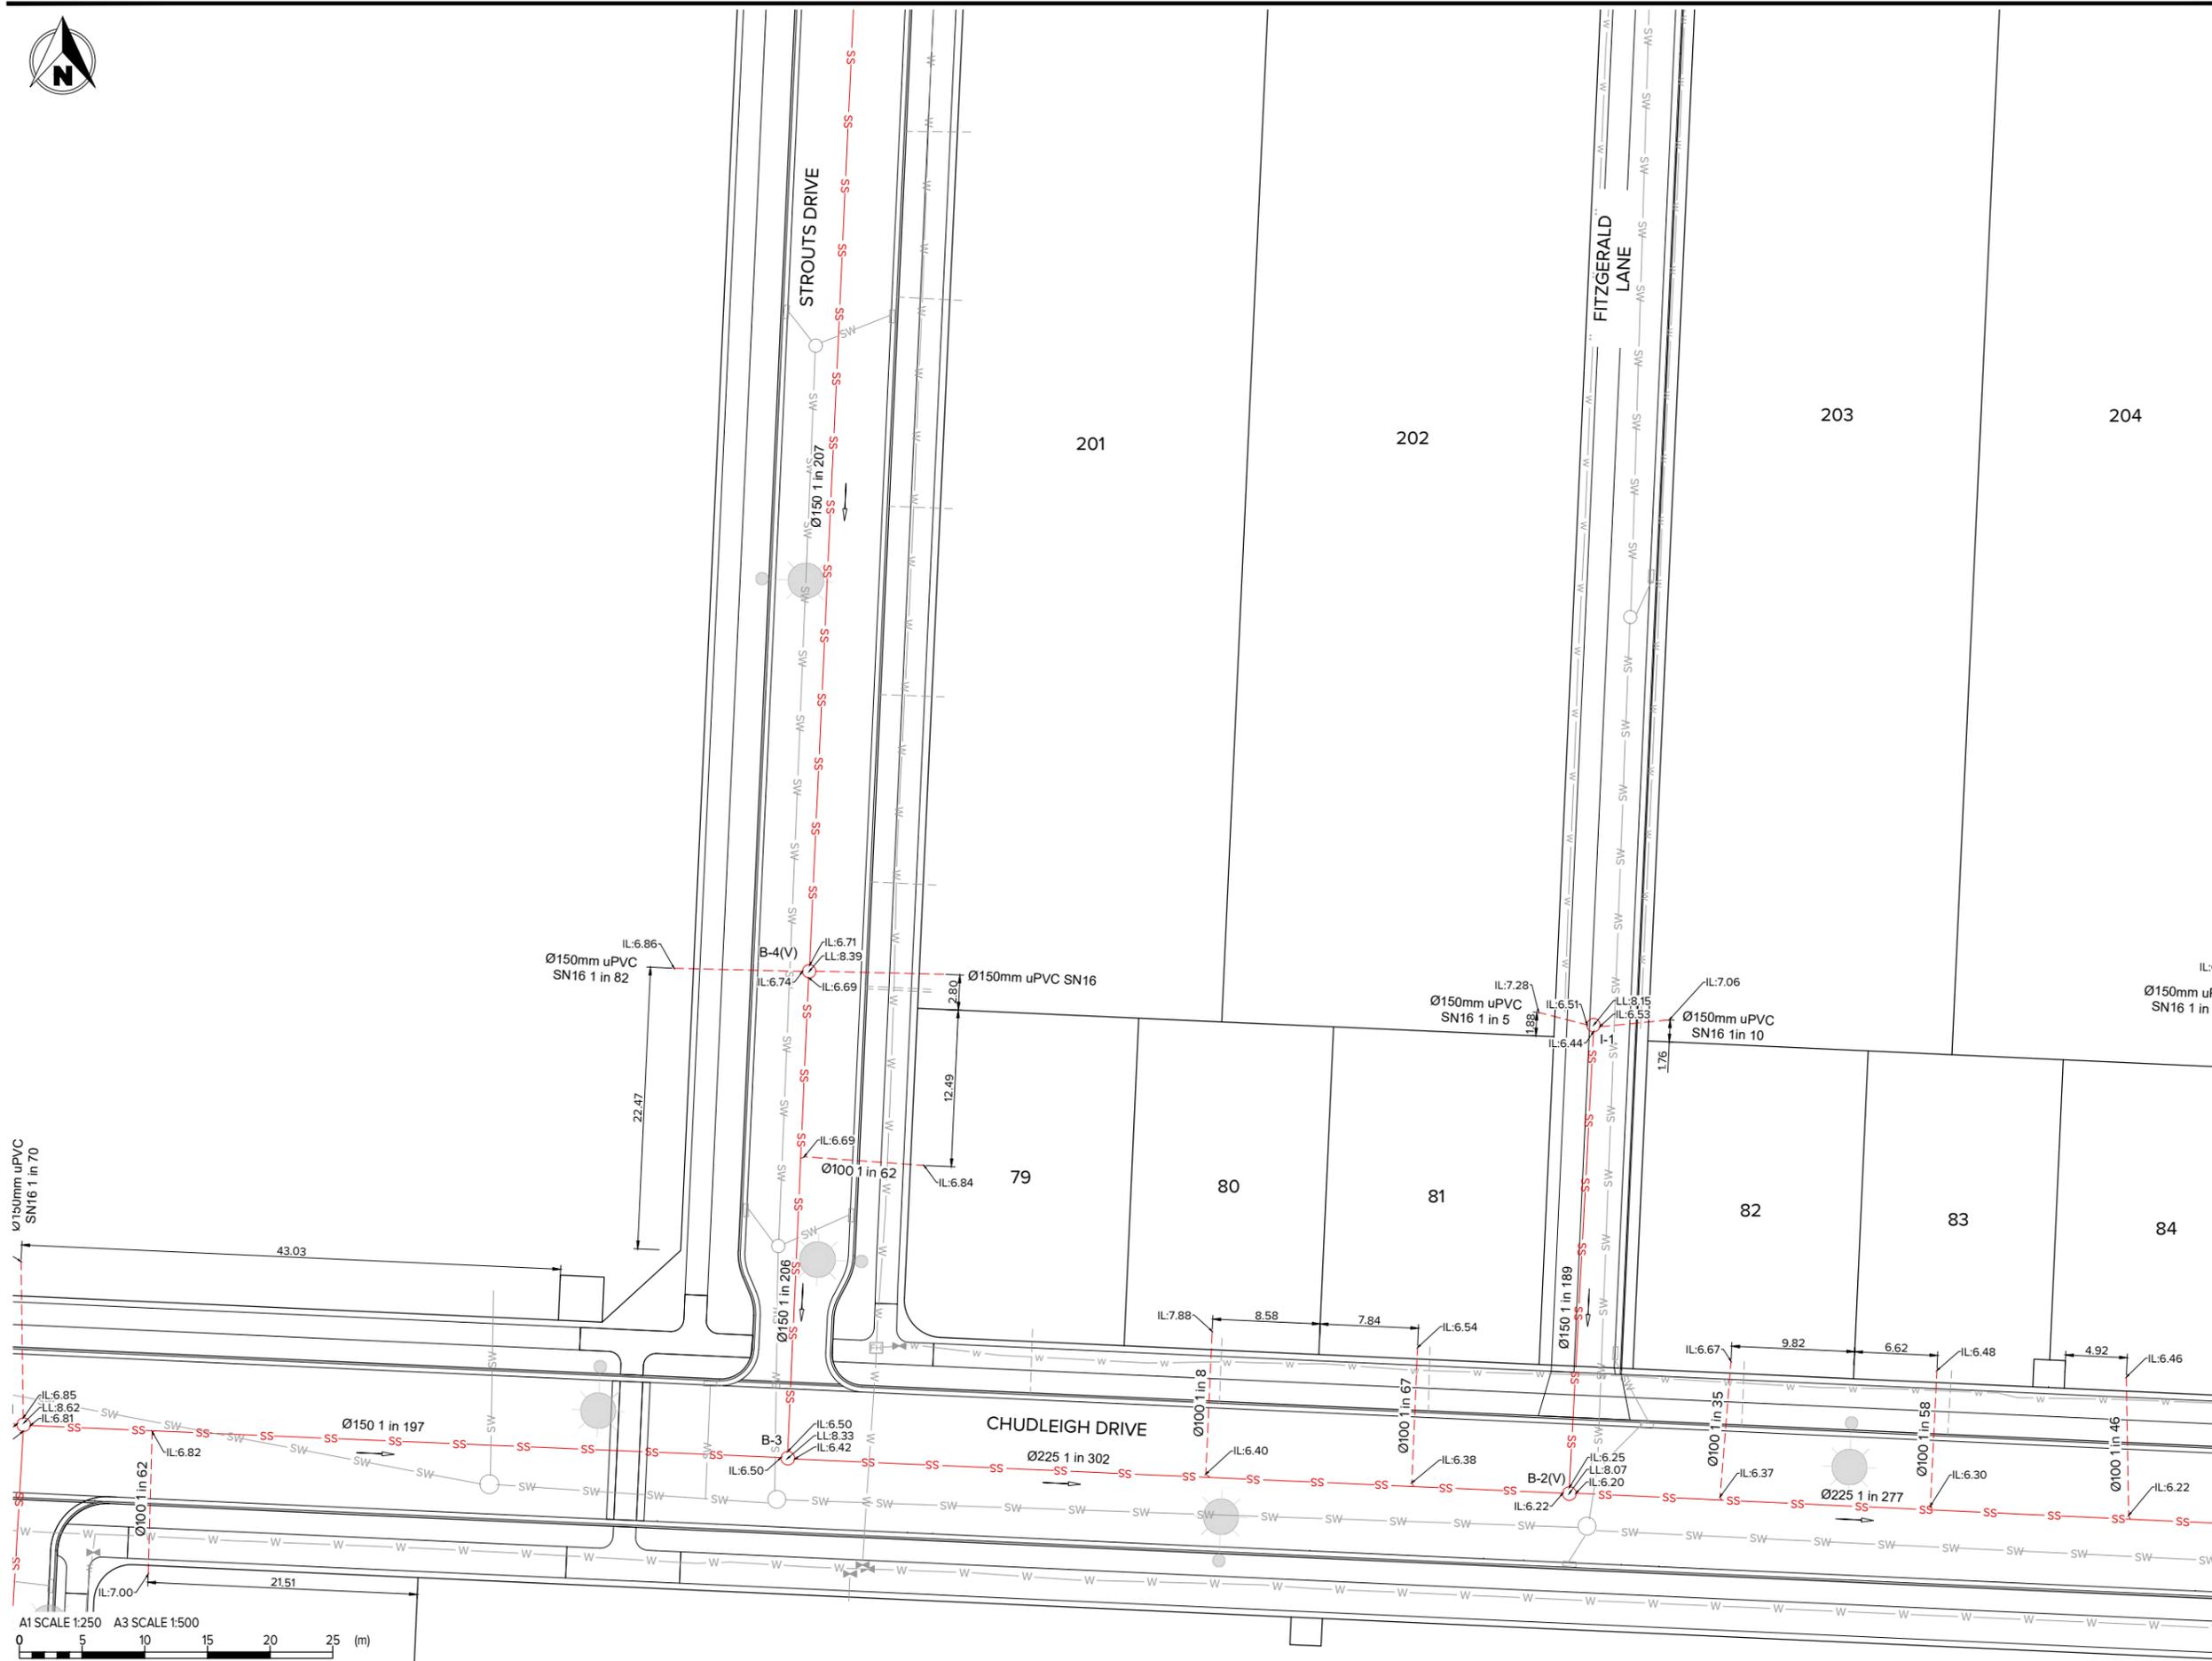

Rev#	Description	Drawn	Date
0	FOR AS-BUILT	IAMcC	28.08.25



Scale A1
1:250
Scale A3
1:500
DO NOT SCALE FROM DRAWING

Drawn
AMcC
Approved
TMcL
Date
28.08.25

Client
EARLSBROOK
LINCOLN

Project
**EARLSBROOK
RESIDENTIAL SUBDIVISION
STAGE 1**

Drawing Title
**WASTEWATER AS-BUILT
STAGE 1
SHEET 9**

Status
**AS-BUILT
AUG 2025**

Drawing No.
15721-S1-AB-5008

Rev
0



203

204



- NOTES**
1. CO-ORDINATES ARE IN TERMS OF NEW ZEALAND TRANSVERSE MERCATOR 2000 PROJECTION (NZTM2000).
 2. HEIGHTS ARE IN TERMS OF NEW ZEALAND VERTICAL DATUM 2016 (NZVD2016).
 3. AS-BUILT DATA CARRIED OUT BY MAUGERS CONTRACTING LTD AND SUPPLIED TO INOVO PROJECTS LTD.
 4. PROPOSED BOUNDARIES ARE SUBJECT TO FINAL SURVEY.
 5. EXISTING BOUNDARIES SOURCED FROM LINZ DATA SERVICE AND IS TO BE USED IN ACCORDANCE WITH THE INTERNATIONAL CREATIVE COMMONS LICENCE 4.
 6. ALL DIMENSIONS ARE IN METRES UNLESS STATED.

- LEGEND**
- SITE BOUNDARIES
 - SS SS WASTE WATER MAIN
 - WASTE WATER LATERAL
 - ☼ STREET LIGHT

L:7.06
 0mm uPVC
 116 1in 10



Rev#	Description	Drawn	Date

INOVO
 Level 1, 93 Manchester St, Christchurch 8022
 Ph. 03 377 3290
 Level 1, Shed 19, Princess Wharf, Auckland 1010
 Ph. 09 600 1099
 www.inovo.nz

Scale A1
 1:250
 Scale A3
 1:500
 DO NOT SCALE FROM DRAWING

Drawn
 AMcC
 Approved
 TMcL
 Date
 28.08.25

Client
EARLSBROOK
 LINCOLN


Project
EARLSBROOK
RESIDENTIAL SUBDIVISION
STAGE 1


Drawing Title
WASTEWATER AS-BUILT
STAGE 1
SHEET 10

Status
AS-BUILT
AUG 2025

Drawing No.
15721-S1-AB-5009

Rev
0

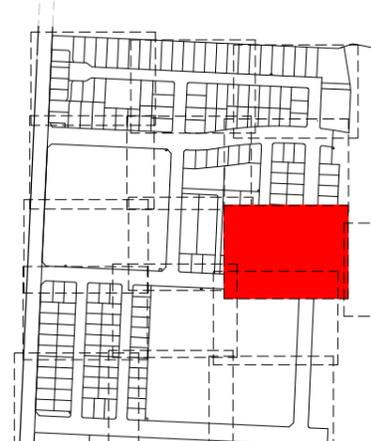

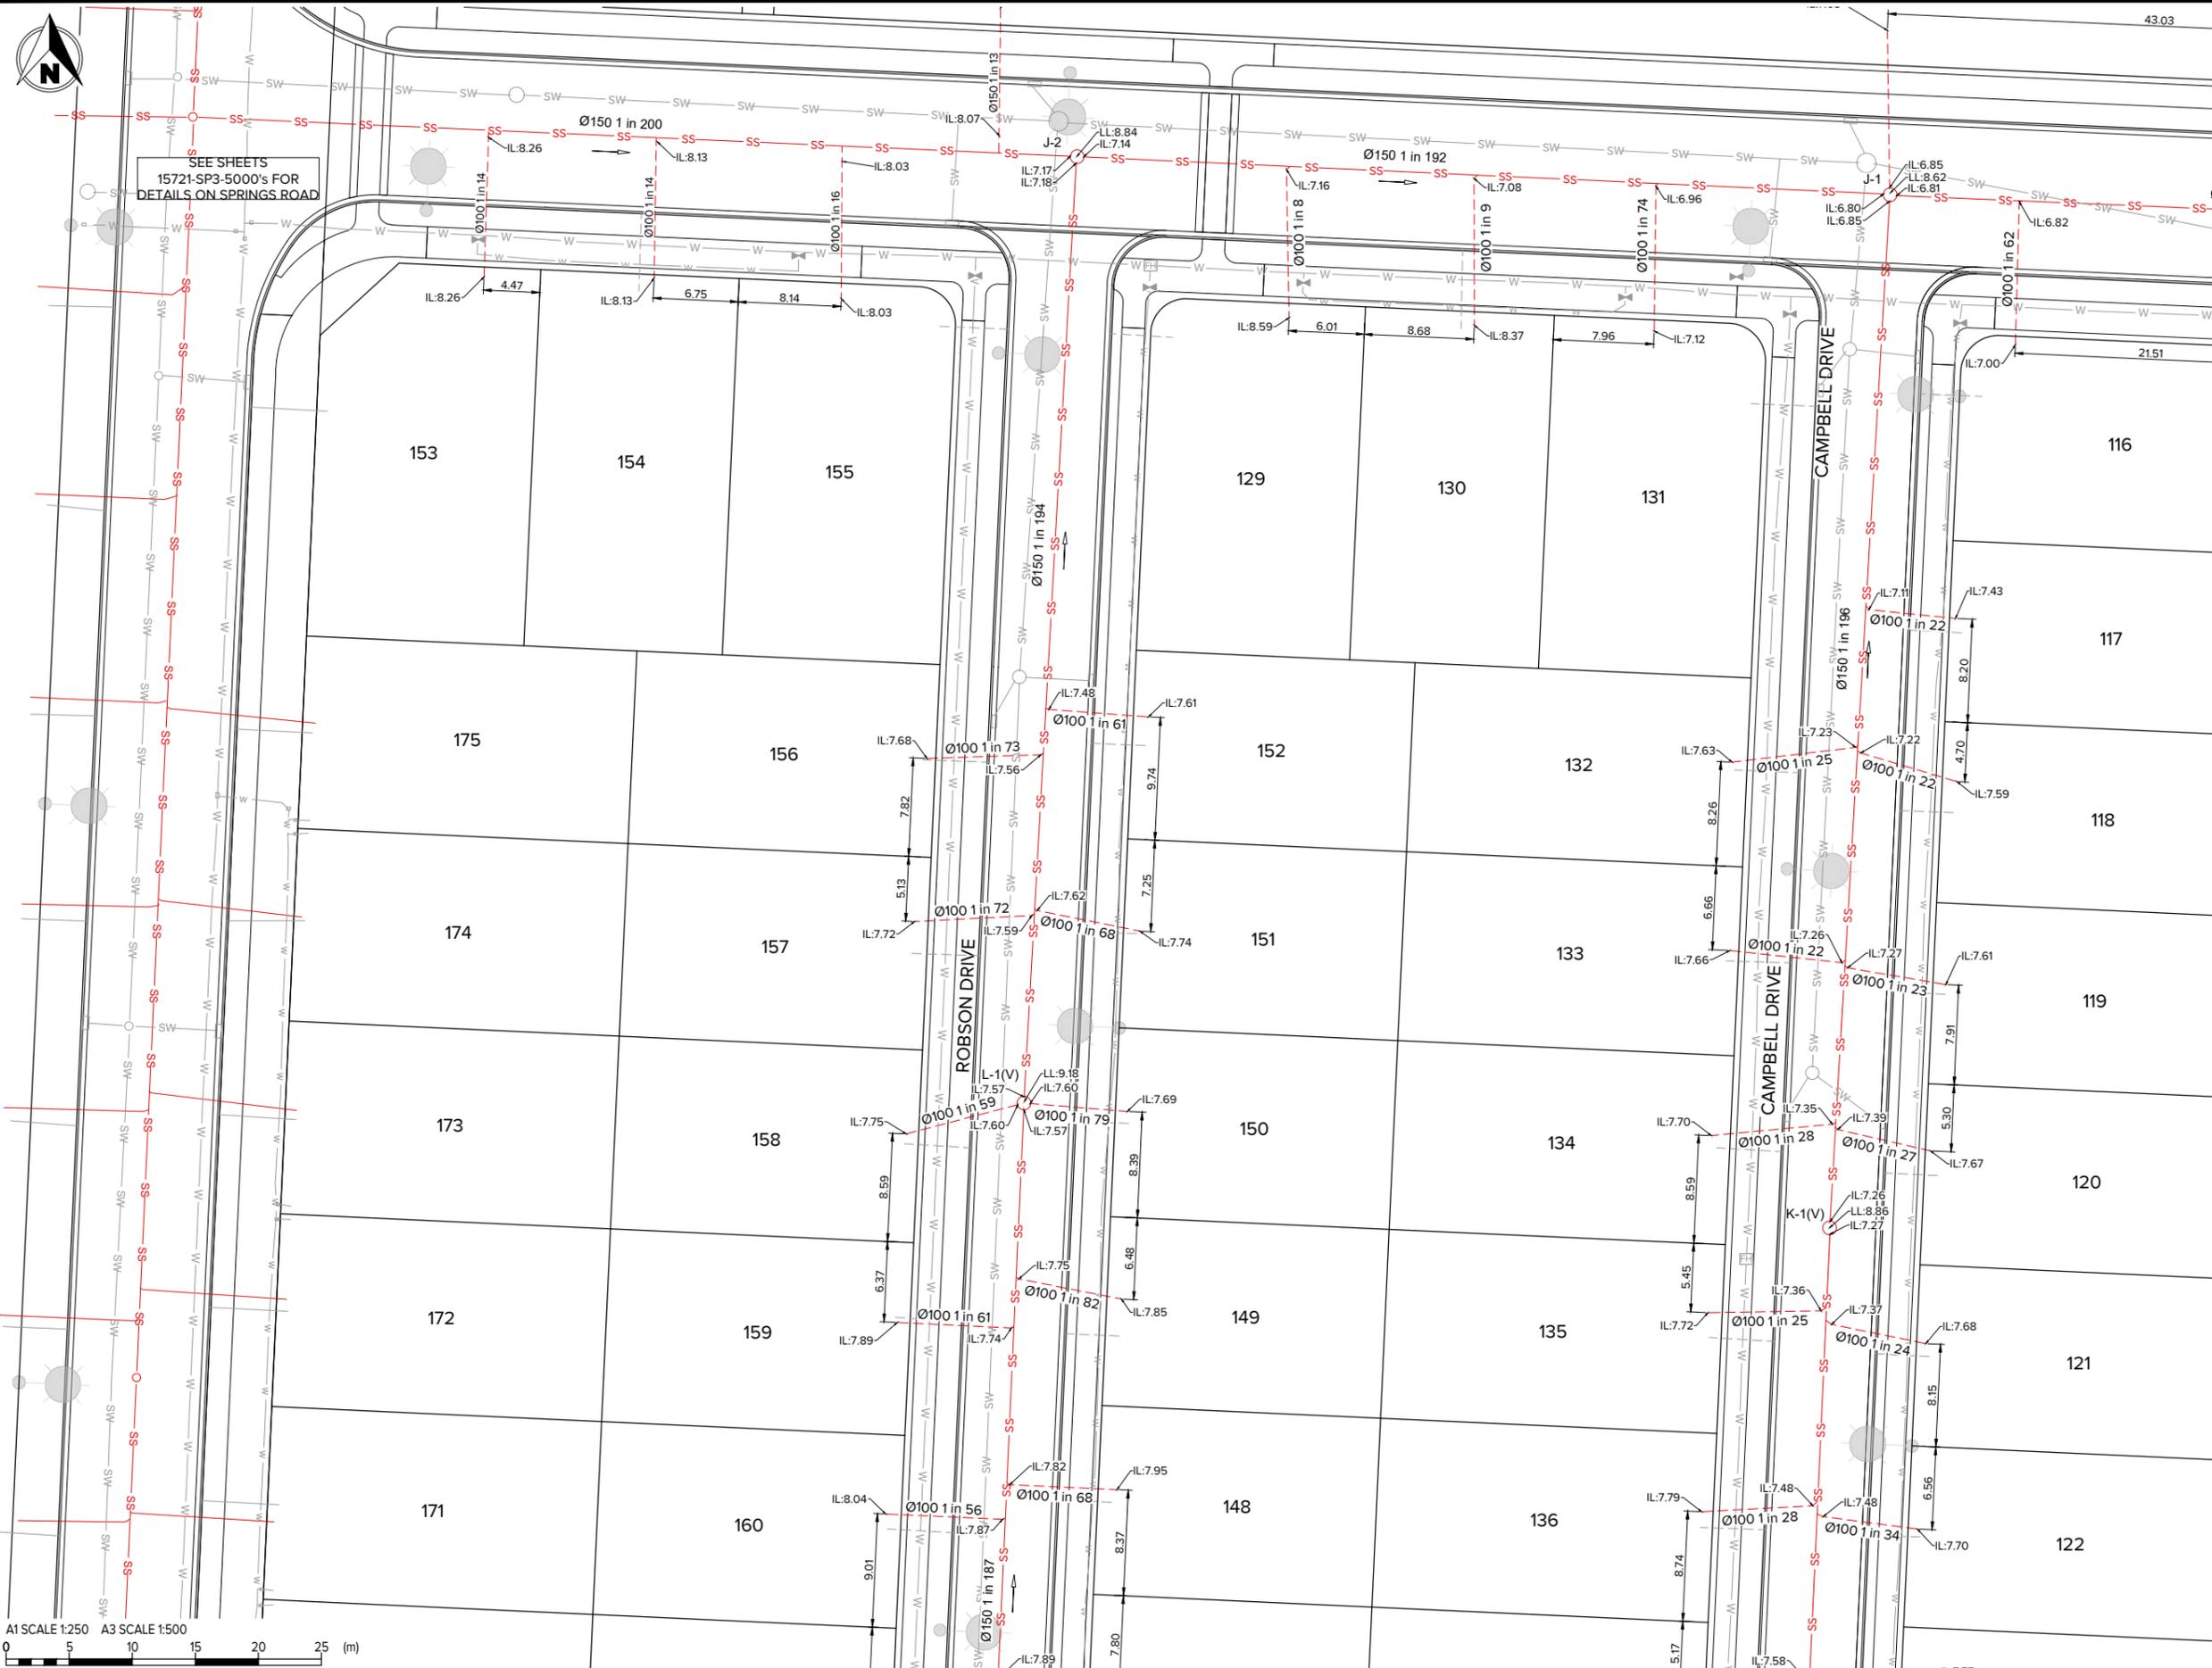


SEE SHEETS
15721-SP3-5000's FOR
DETAILS ON SPRINGS ROAD

A1 SCALE 1:250 A3 SCALE 1:500
0 5 10 15 20 25 (m)

- NOTES**
1. CO-ORDINATES ARE IN TERMS OF NEW ZEALAND TRANSVERSE MERCATOR 2000 PROJECTION (NZTM2000).
 2. HEIGHTS ARE IN TERMS OF NEW ZEALAND VERTICAL DATUM 2016 (NZVD2016).
 3. AS-BUILT DATA CARRIED OUT BY MAUGERS CONTRACTING LTD AND SUPPLIED TO INOVO PROJECTS LTD.
 4. PROPOSED BOUNDARIES ARE SUBJECT TO FINAL SURVEY.
 5. EXISTING BOUNDARIES SOURCED FROM LINZ DATA SERVICE AND IS TO BE USED IN ACCORDANCE WITH THE INTERNATIONAL CREATIVE COMMONS LICENCE 4.
 6. ALL DIMENSIONS ARE IN METRES UNLESS STATED.

- LEGEND**
- SITE BOUNDARIES
 - SS SS WASTE WATER MAIN
 - WASTE WATER LATERAL
 - STREET LIGHT

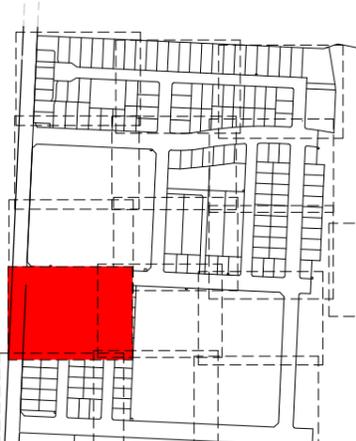

Rev#	Description	Drawn	Date

INOVO
Level 1, 93 Manchester St, Christchurch 8022
Ph. 03 377 3290
Level 1, Shed 19, Princess Wharf, Auckland 1010
Ph. 09 600 1099
www.inovo.nz

Scale A1
1:250
Scale A3
1:500
DO NOT SCALE FROM DRAWING

Drawn
AMcC
Approved
TMcL
Date
28.08.25

Client
EARLSBROOK
LINCOLN


Project
**EARLSBROOK
RESIDENTIAL SUBDIVISION
STAGE 1**

Drawing Title
**WASTEWATER AS-BUILT
STAGE 1
SHEET 11**

Status
**AS-BUILT
AUG 2025**



Drawing No.
15721-S1-AB-5010

Rev
0

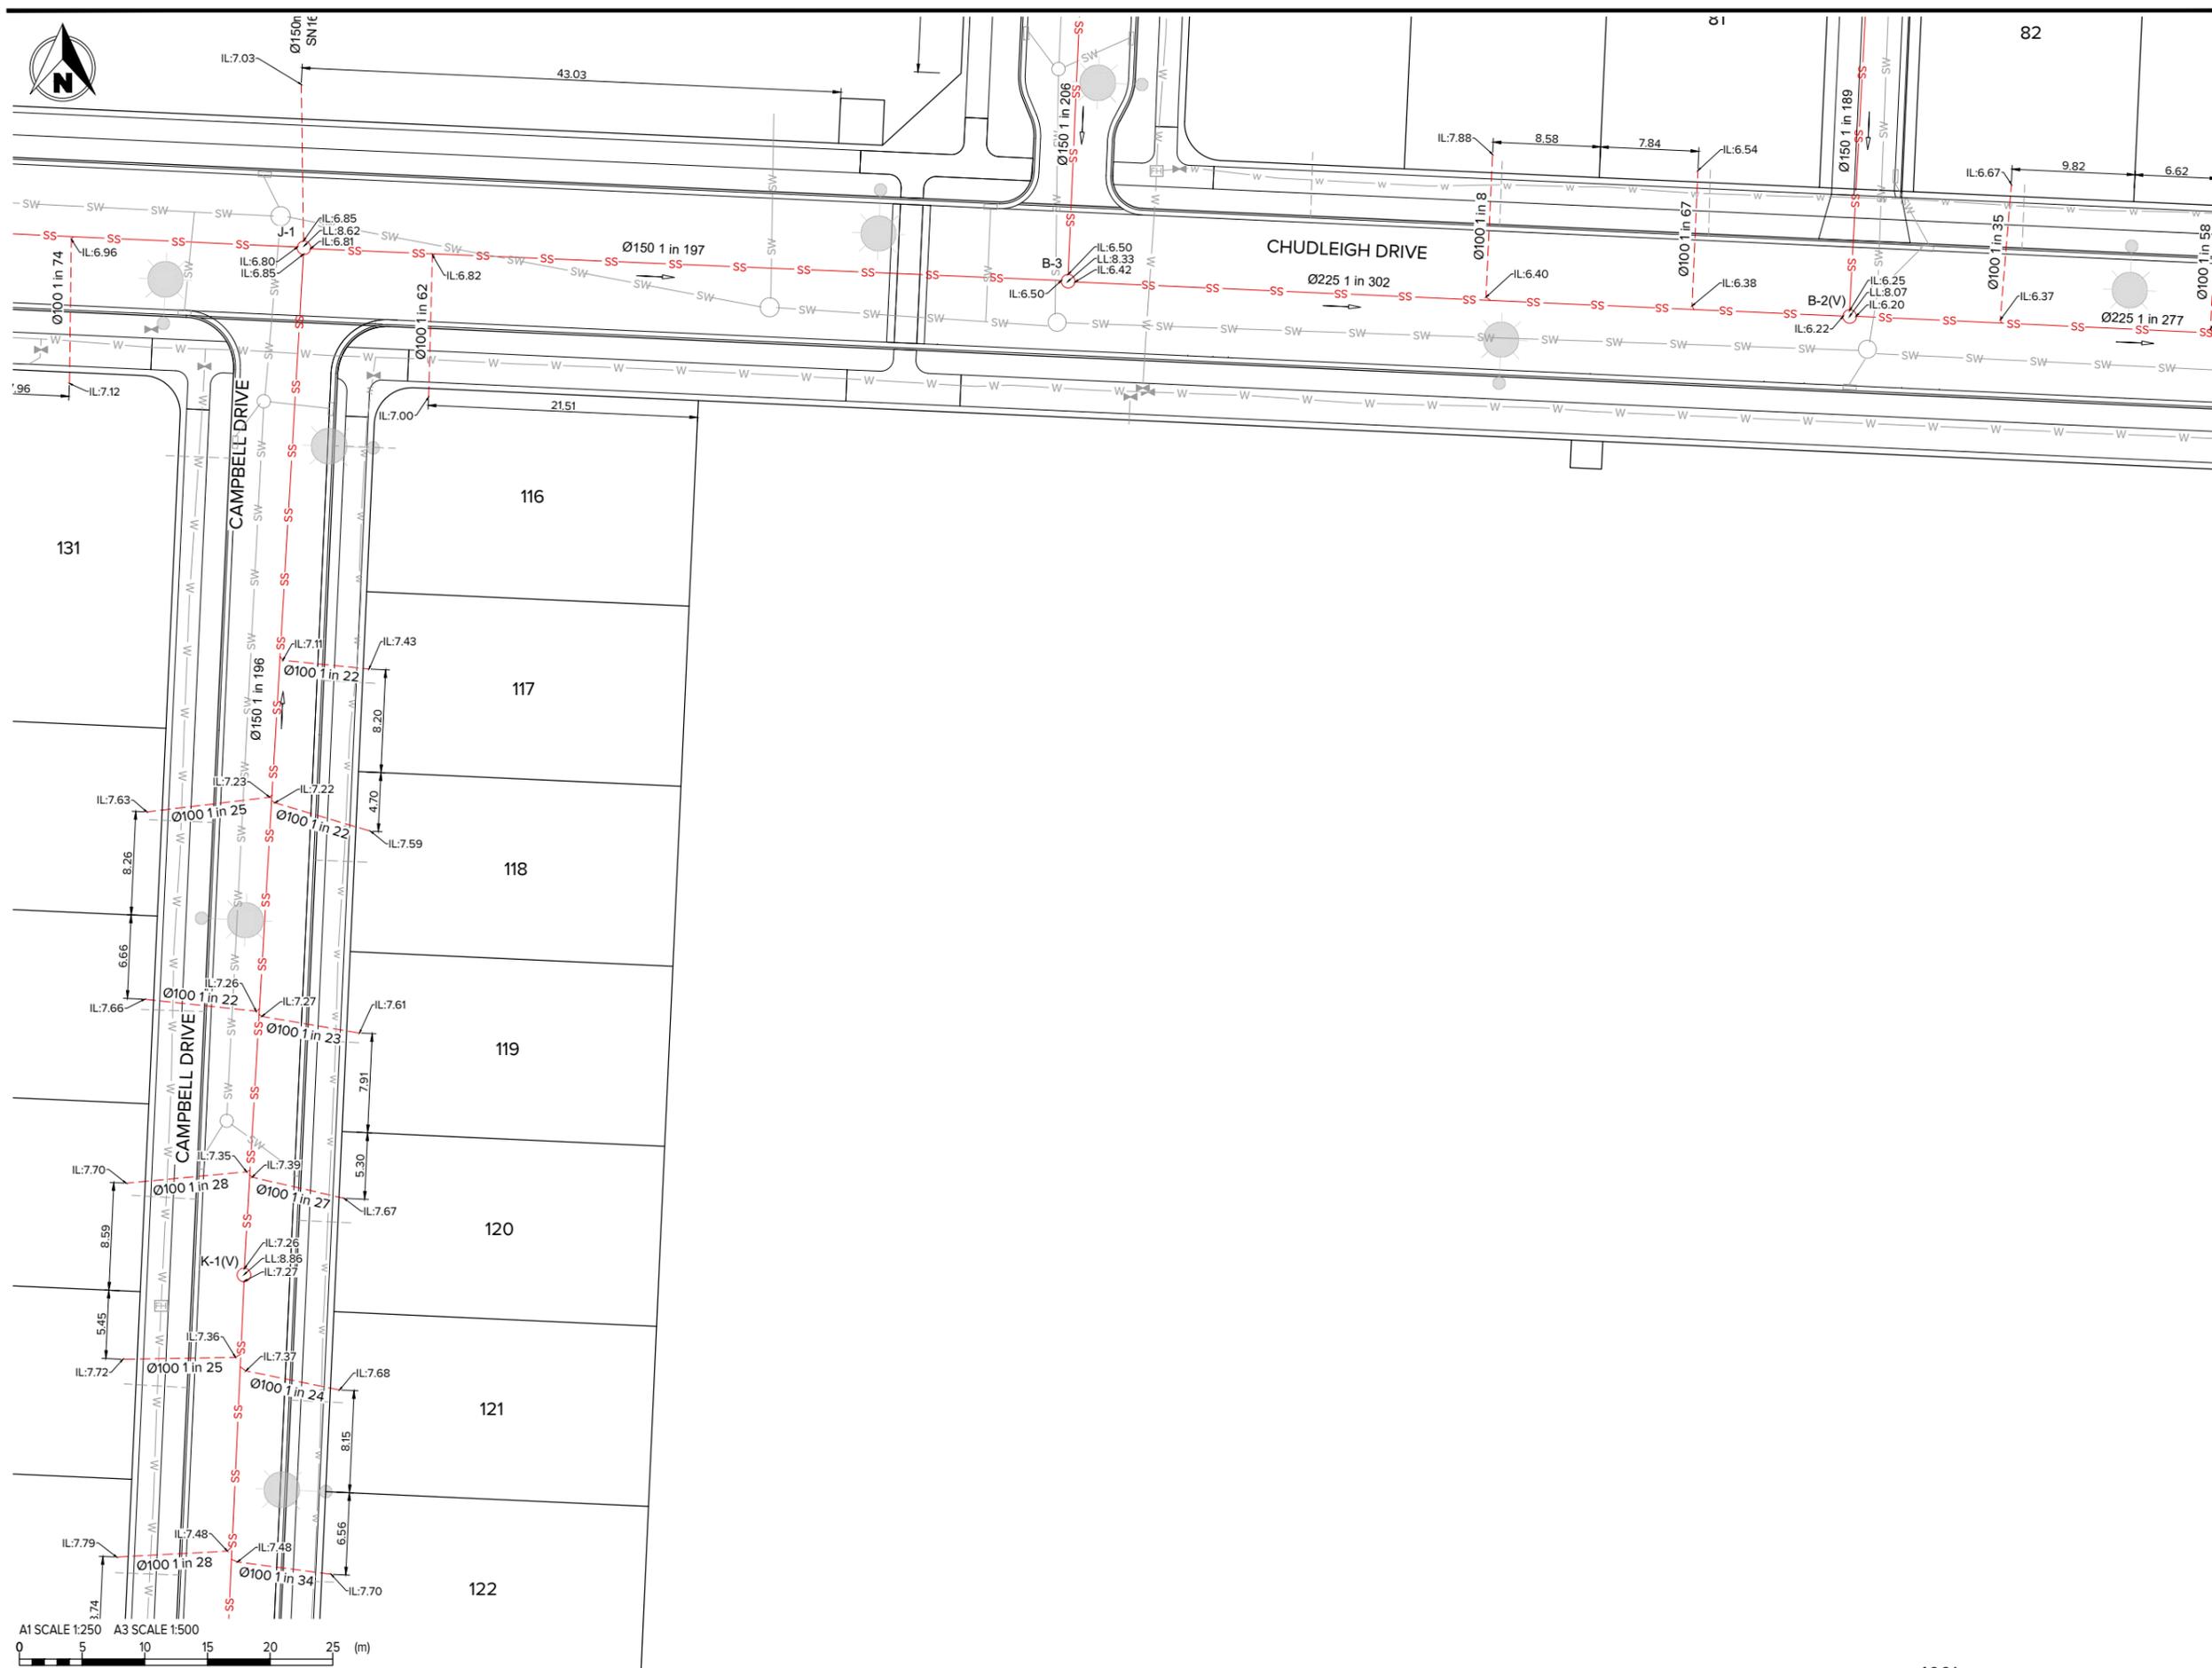

- NOTES**
1. CO-ORDINATES ARE IN TERMS OF NEW ZEALAND TRANSVERSE MERCATOR 2000 PROJECTION (NZTM2000).
 2. HEIGHTS ARE IN TERMS OF NEW ZEALAND VERTICAL DATUM 2016 (NZVD2016).
 3. AS-BUILT DATA CARRIED OUT BY MAUGERS CONTRACTING LTD AND SUPPLIED TO INOVO PROJECTS LTD.
 4. PROPOSED BOUNDARIES ARE SUBJECT TO FINAL SURVEY.
 5. EXISTING BOUNDARIES SOURCED FROM LINZ DATA SERVICE AND IS TO BE USED IN ACCORDANCE WITH THE INTERNATIONAL CREATIVE COMMONS LICENCE 4.
 6. ALL DIMENSIONS ARE IN METRES UNLESS STATED.

- LEGEND**
- SITE BOUNDARIES
 - SS--- WASTE WATER MAIN
 - WASTE WATER LATERAL
 - STREET LIGHT

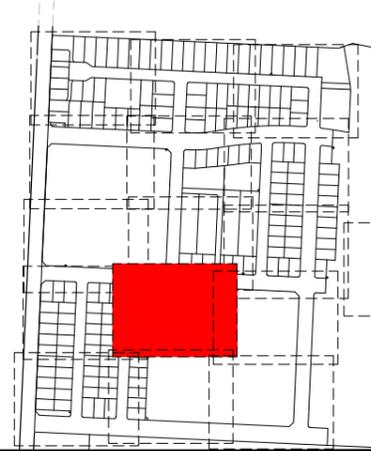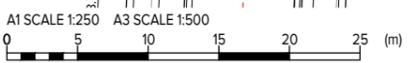

Rev#	Description	Drawn	Date

INOVO
 Level 1, 93 Manchester St, Christchurch 8022
 Ph. 03 377 3290
 Level 1, Shed 19, Princess Wharf, Auckland 1010
 Ph. 09 600 1099
 www.inovo.nz

Scale A1
1:250
 Scale A3
1:500
 DO NOT SCALE FROM DRAWING

Drawn
AMcC
 Approved
TMcL
 Date
28.08.25

Client
EARLSBROOK
 LINCOLN


Project
**EARLSBROOK
 RESIDENTIAL SUBDIVISION
 STAGE 1**

Drawing Title
**WASTEWATER AS-BUILT
 STAGE 1
 SHEET 12**

Status
**AS-BUILT
 AUG 2025**


Drawing No.
15721-S1-AB-5011

Rev
0

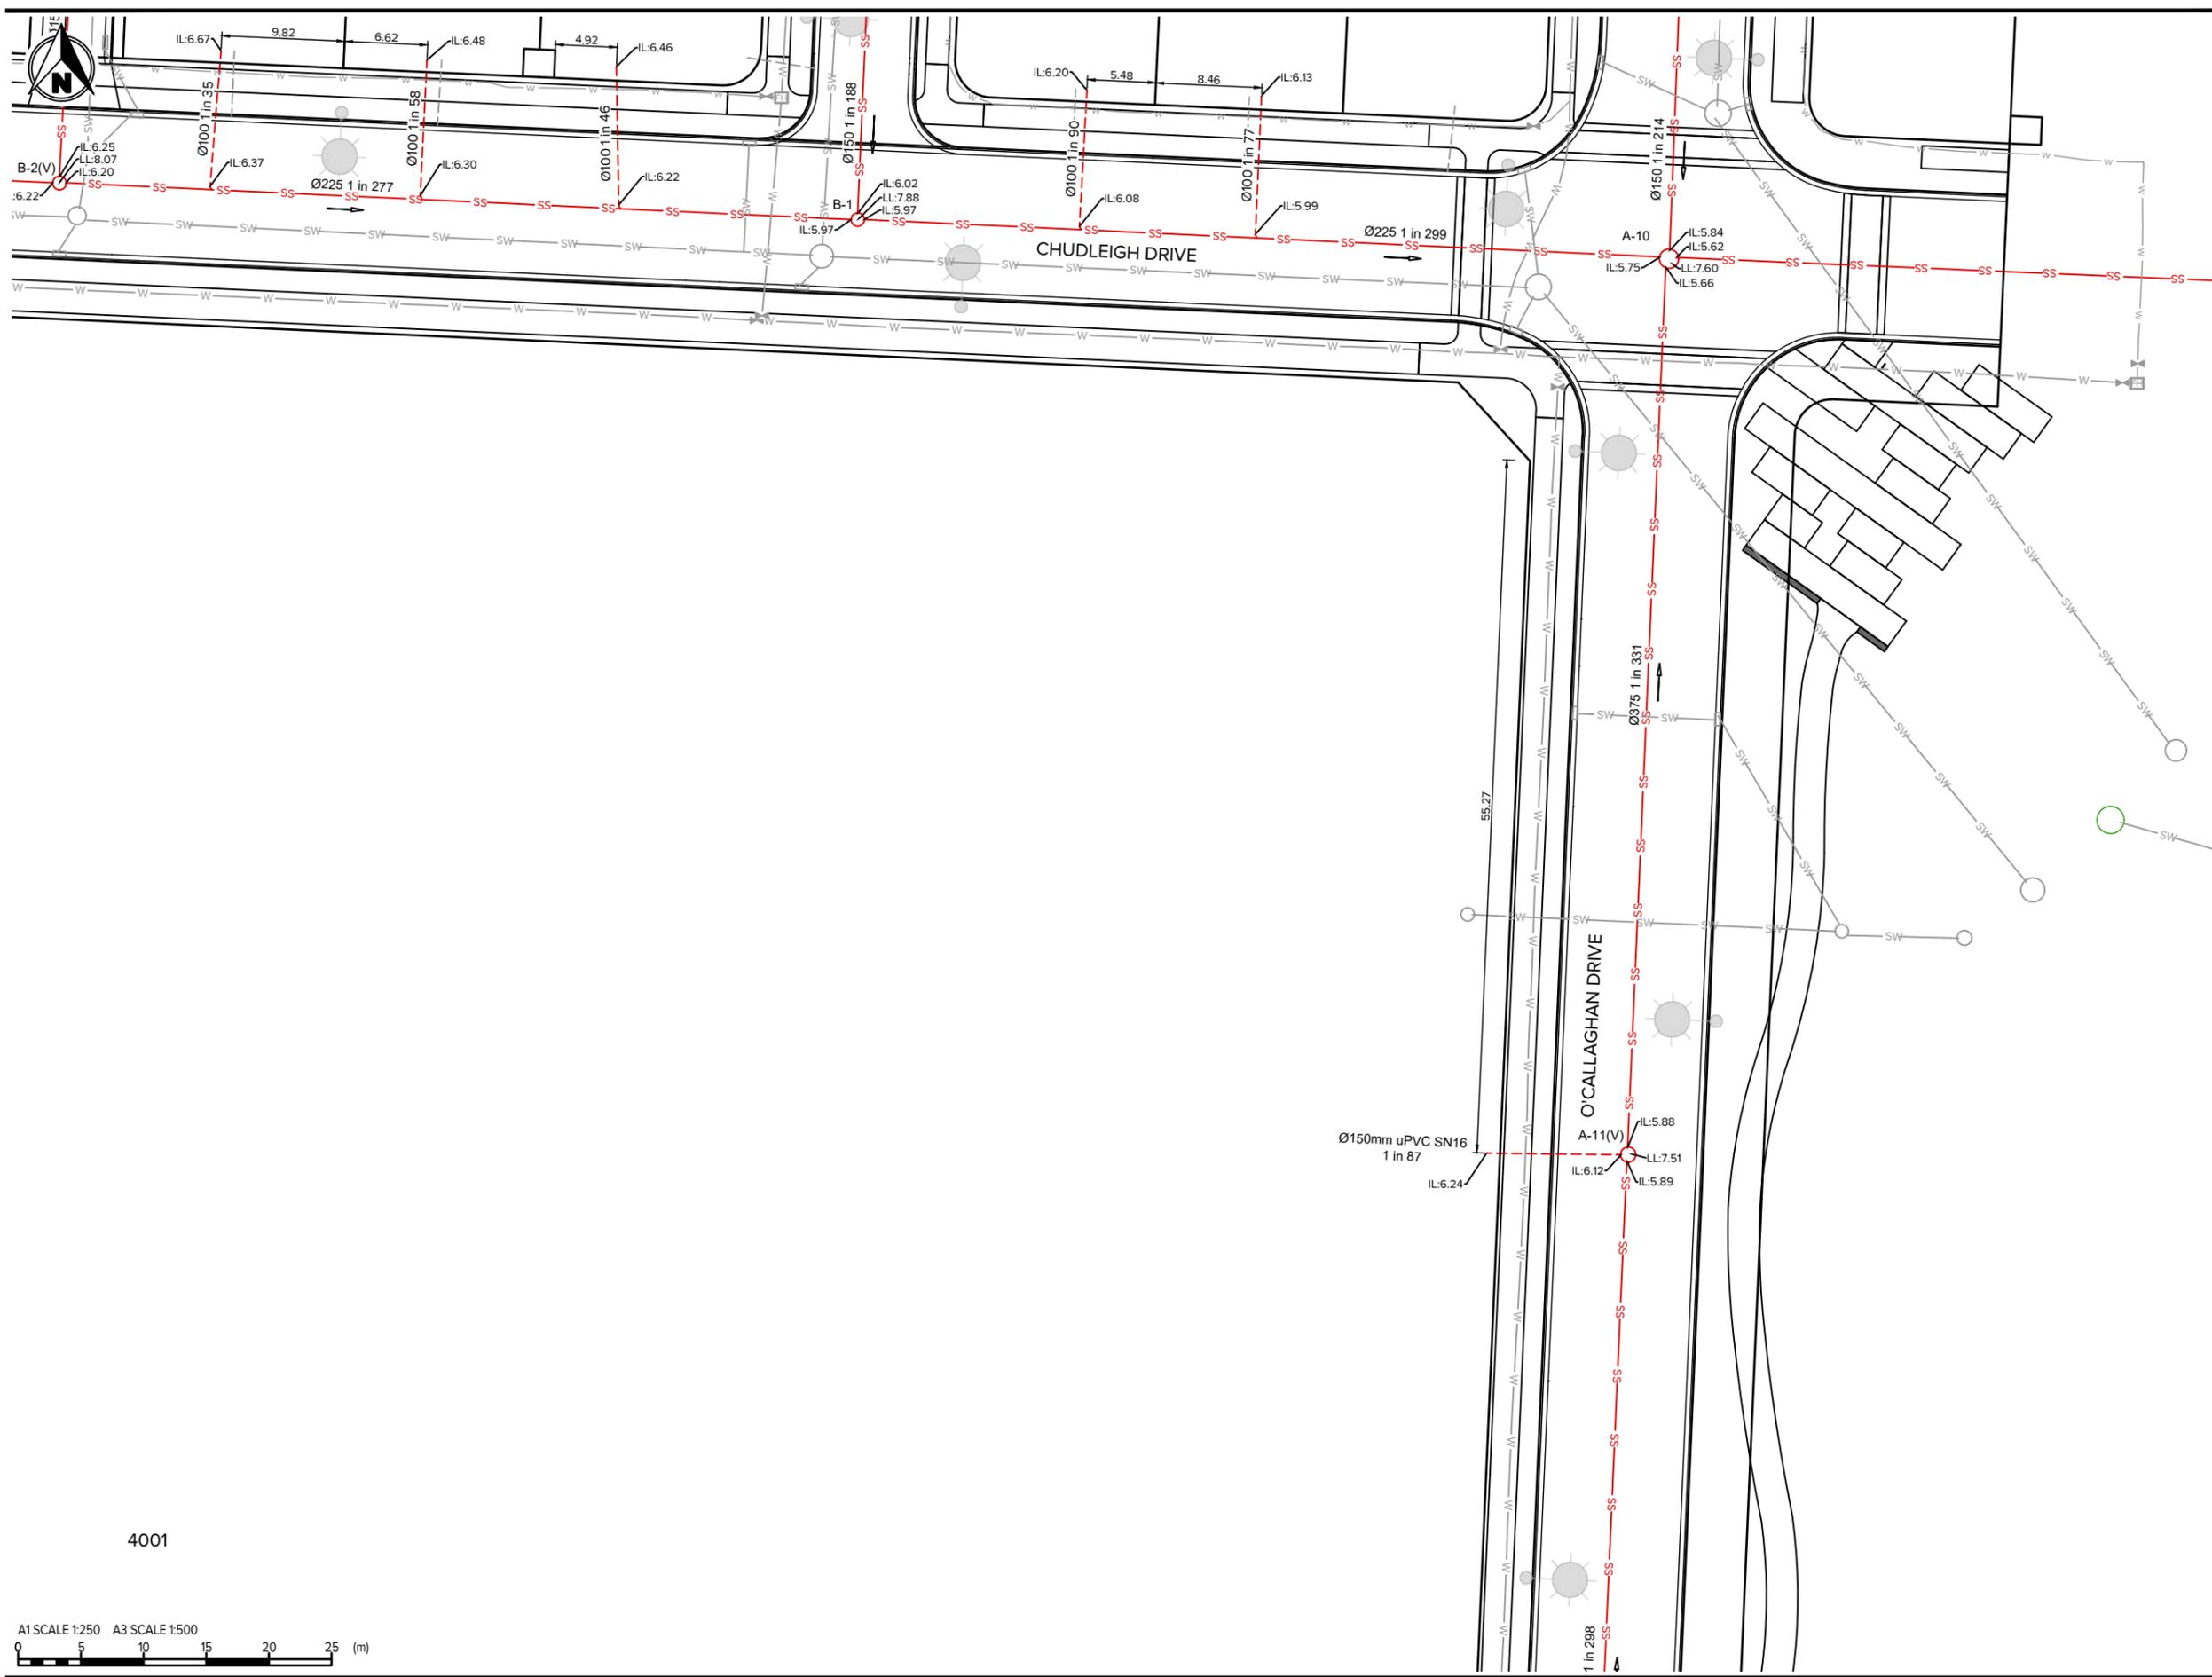


- NOTES**
1. CO-ORDINATES ARE IN TERMS OF NEW ZEALAND TRANSVERSE MERCATOR 2000 PROJECTION (NZTM2000).
 2. HEIGHTS ARE IN TERMS OF NEW ZEALAND VERTICAL DATUM 2016 (NZVD2016).
 3. AS-BUILT DATA CARRIED OUT BY MAUGERS CONTRACTING LTD AND SUPPLIED TO INOVO PROJECTS LTD.
 4. PROPOSED BOUNDARIES ARE SUBJECT TO FINAL SURVEY.
 5. EXISTING BOUNDARIES SOURCED FROM LINZ DATA SERVICE AND IS TO BE USED IN ACCORDANCE WITH THE INTERNATIONAL CREATIVE COMMONS LICENCE 4.
 6. ALL DIMENSIONS ARE IN METRES UNLESS STATED.

- LEGEND**
- SITE BOUNDARIES
 - SS SS WASTE WATER MAIN
 - WASTE WATER LATERAL
 - * STREET LIGHT

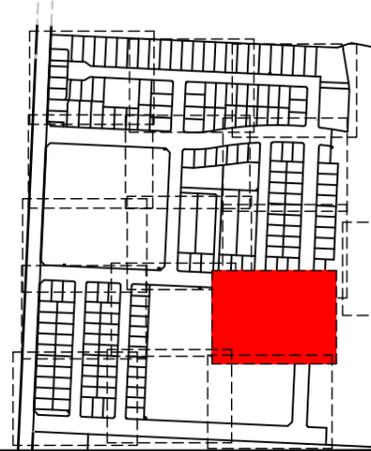

4001

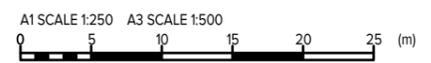

Rev#	Description	Drawn	Date
0	FOR AS-BUILT	AMcC	28.08.25



Level 1, 93 Manchester St, Christchurch 8022
Ph. 03 377 3290
Level 1, Shed 19, Princess Wharf, Auckland 1010
Ph. 09 600 1099
www.inovo.nz

Scale A1
1:250
Scale A3
1:500
DO NOT SCALE FROM DRAWING

Drawn
AMcC
Approved
TMcL
Date
28.08.25



Project
**EARLSBROOK
RESIDENTIAL SUBDIVISION
STAGE 1**

Drawing Title
**WASTEWATER AS-BUILT
STAGE 1
SHEET 13**


Status
**AS-BUILT
AUG 2025**
Drawing No.
15721-S1-AB-5012 Rev
0



- NOTES**
1. CO-ORDINATES ARE IN TERMS OF NEW ZEALAND TRANSVERSE MERCATOR 2000 PROJECTION (NZTM2000).
 2. HEIGHTS ARE IN TERMS OF NEW ZEALAND VERTICAL DATUM 2016 (NZVD2016).
 3. AS-BUILT DATA CARRIED OUT BY MAUGERS CONTRACTING LTD AND SUPPLIED TO INOVO PROJECTS LTD.
 4. PROPOSED BOUNDARIES ARE SUBJECT TO FINAL SURVEY.
 5. EXISTING BOUNDARIES SOURCED FROM LINZ DATA SERVICE AND IS TO BE USED IN ACCORDANCE WITH THE INTERNATIONAL CREATIVE COMMONS LICENCE 4.
 6. ALL DIMENSIONS ARE IN METRES UNLESS STATED.

- LEGEND**
- SITE BOUNDARIES
 - SS SS WASTE WATER MAIN
 - - - - WASTE WATER LATERAL
 - STREET LIGHT

SEE SHEETS
15721-SP3-5000's FOR
DETAILS ON SPRINGS ROAD

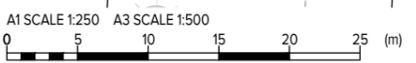

Rev#	Description	Drawn	Date

INOVO
Level 1, 93 Manchester St, Christchurch 8022
Ph. 03 377 3290
Level 1, Shed 19, Princess Wharf, Auckland 1010
Ph. 09 600 1099
www.inovo.nz

Scale A1
1:250
Scale A3
1:500
DO NOT SCALE FROM DRAWING

Drawn
AMCC
Approved
TMCL
Date
28.08.25




Project
**EARLSBROOK
RESIDENTIAL SUBDIVISION
STAGE 1**

Drawing Title
**WASTEWATER AS-BUILT
STAGE 1
SHEET 14**

Status
**AS-BUILT
AUG 2025**

Drawing No.
15721-S1-AB-5013


Rev
0

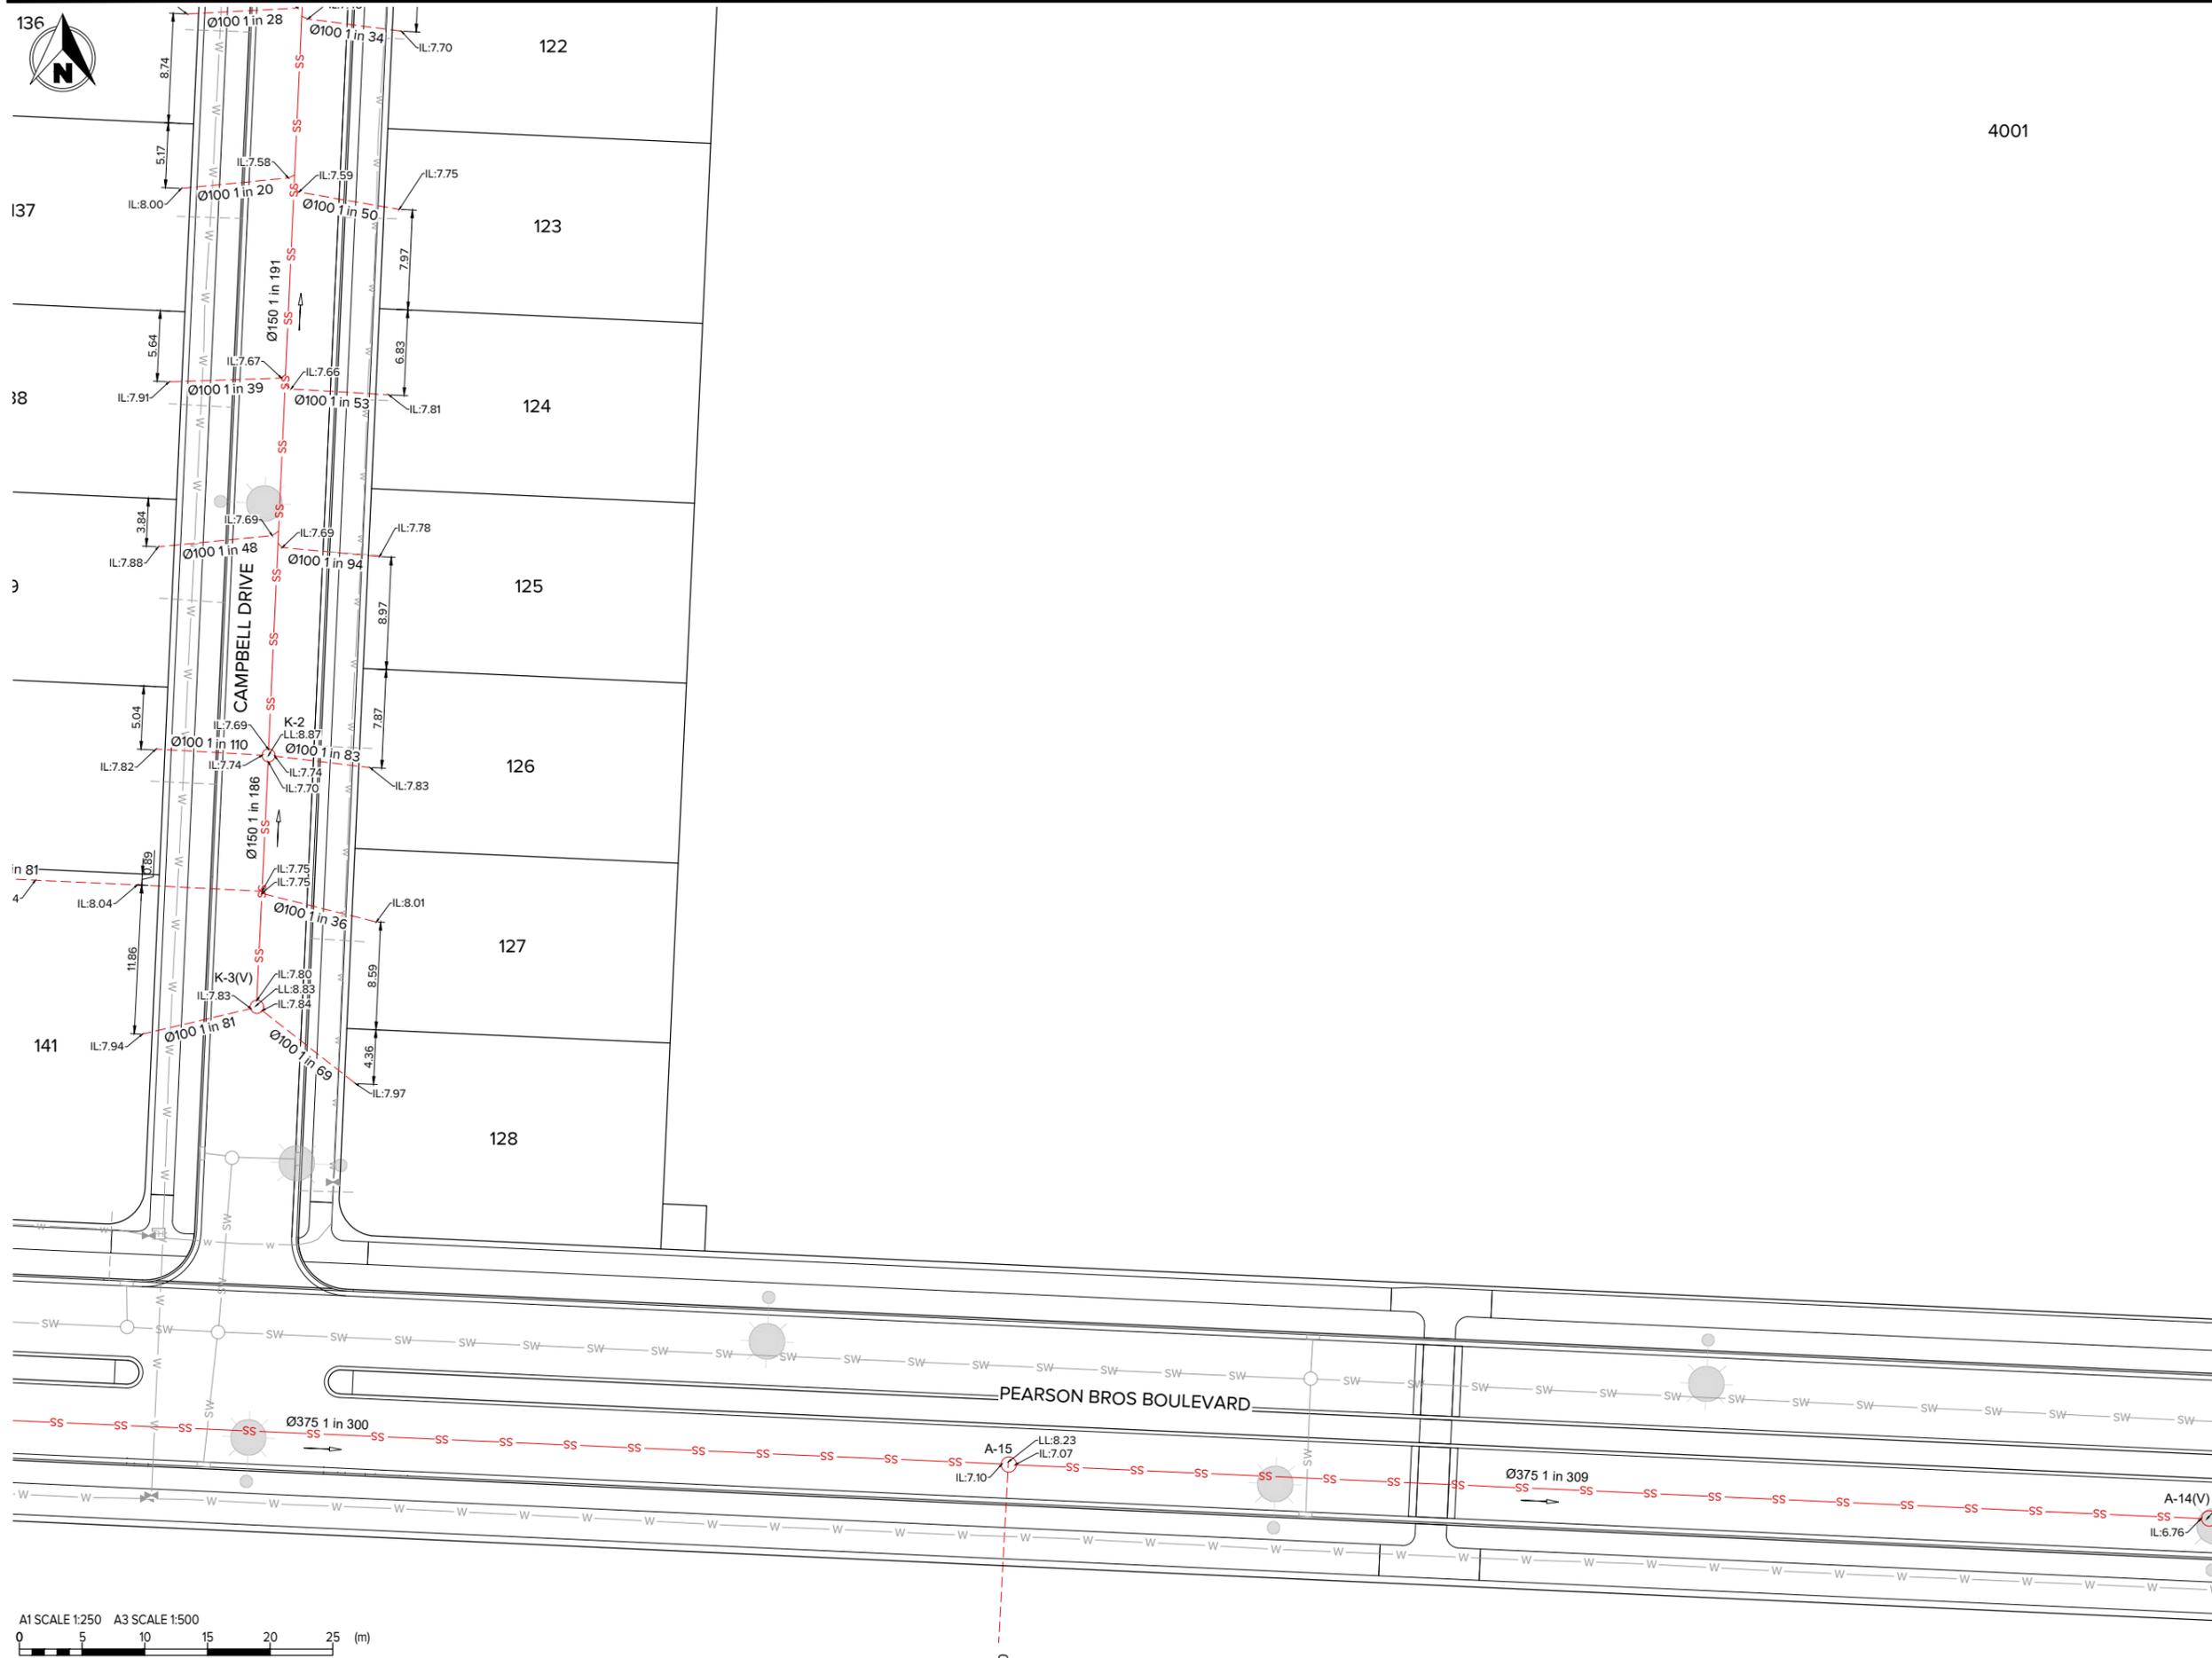

4001

- NOTES**
1. CO-ORDINATES ARE IN TERMS OF NEW ZEALAND TRANSVERSE MERCATOR 2000 PROJECTION (NZTM2000).
 2. HEIGHTS ARE IN TERMS OF NEW ZEALAND VERTICAL DATUM 2016 (NZVD2016).
 3. AS-BUILT DATA CARRIED OUT BY MAUGERS CONTRACTING LTD AND SUPPLIED TO INOVO PROJECTS LTD.
 4. PROPOSED BOUNDARIES ARE SUBJECT TO FINAL SURVEY.
 5. EXISTING BOUNDARIES SOURCED FROM LINZ DATA SERVICE AND IS TO BE USED IN ACCORDANCE WITH THE INTERNATIONAL CREATIVE COMMONS LICENCE 4.
 6. ALL DIMENSIONS ARE IN METRES UNLESS STATED.

- LEGEND**
- SITE BOUNDARIES
 - SS--- SS--- WASTE WATER MAIN
 - WASTE WATER LATERAL
 - STREET LIGHT

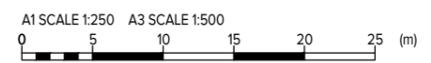

Rev#	Description	Drawn	Date
0	FOR AS-BUILT	AMcC	28.08.25

INOVO
 Level 1, 93 Manchester St, Christchurch 8022
 Ph. 03 377 3290
 Level 1, Shed 19, Princess Wharf, Auckland 1010
 Ph. 09 600 1099
 www.inovo.nz

Scale A1
1:250
 Scale A3
1:500
 DO NOT SCALE FROM DRAWING

Drawn
AMcC
 Approved
TMcL
 Date
28.08.25

Client
EARLSBROOK
LINCOLN


Project
**EARLSBROOK
RESIDENTIAL SUBDIVISION
STAGE 1**

Drawing Title
**WASTEWATER AS-BUILT
STAGE 1
SHEET 15**

Status
**AS-BUILT
AUG 2025**

Drawing No.
15721-S1-AB-5014

Rev
 0

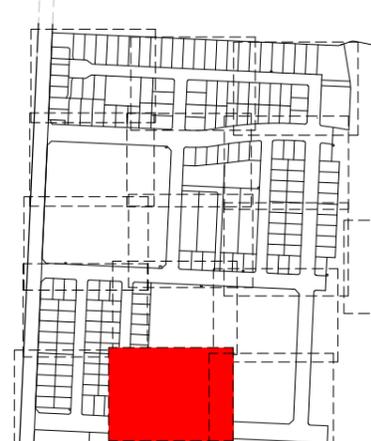





4001

NOTES

1. CO-ORDINATES ARE IN TERMS OF NEW ZEALAND TRANSVERSE MERCATOR 2000 PROJECTION (NZTM2000).
2. HEIGHTS ARE IN TERMS OF NEW ZEALAND VERTICAL DATUM 2016 (NZVD2016).
3. AS-BUILT DATA CARRIED OUT BY MAUGERS CONTRACTING LTD AND SUPPLIED TO INOVO PROJECTS LTD.
4. PROPOSED BOUNDARIES ARE SUBJECT TO FINAL SURVEY.
5. EXISTING BOUNDARIES SOURCED FROM LINZ DATA SERVICE AND IS TO BE USED IN ACCORDANCE WITH THE INTERNATIONAL CREATIVE COMMONS LICENCE 4.
6. ALL DIMENSIONS ARE IN METRES UNLESS STATED.

LEGEND

- SITE BOUNDARIES
- WASTE WATER MAIN
- WASTE WATER LATERAL
- STREET LIGHT

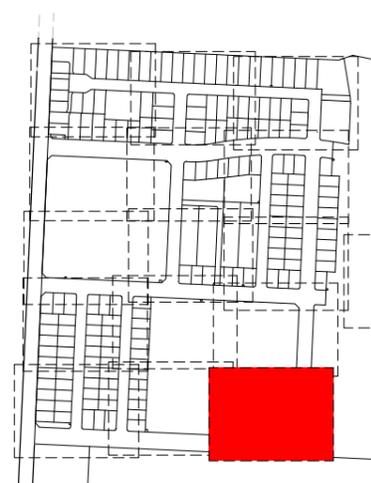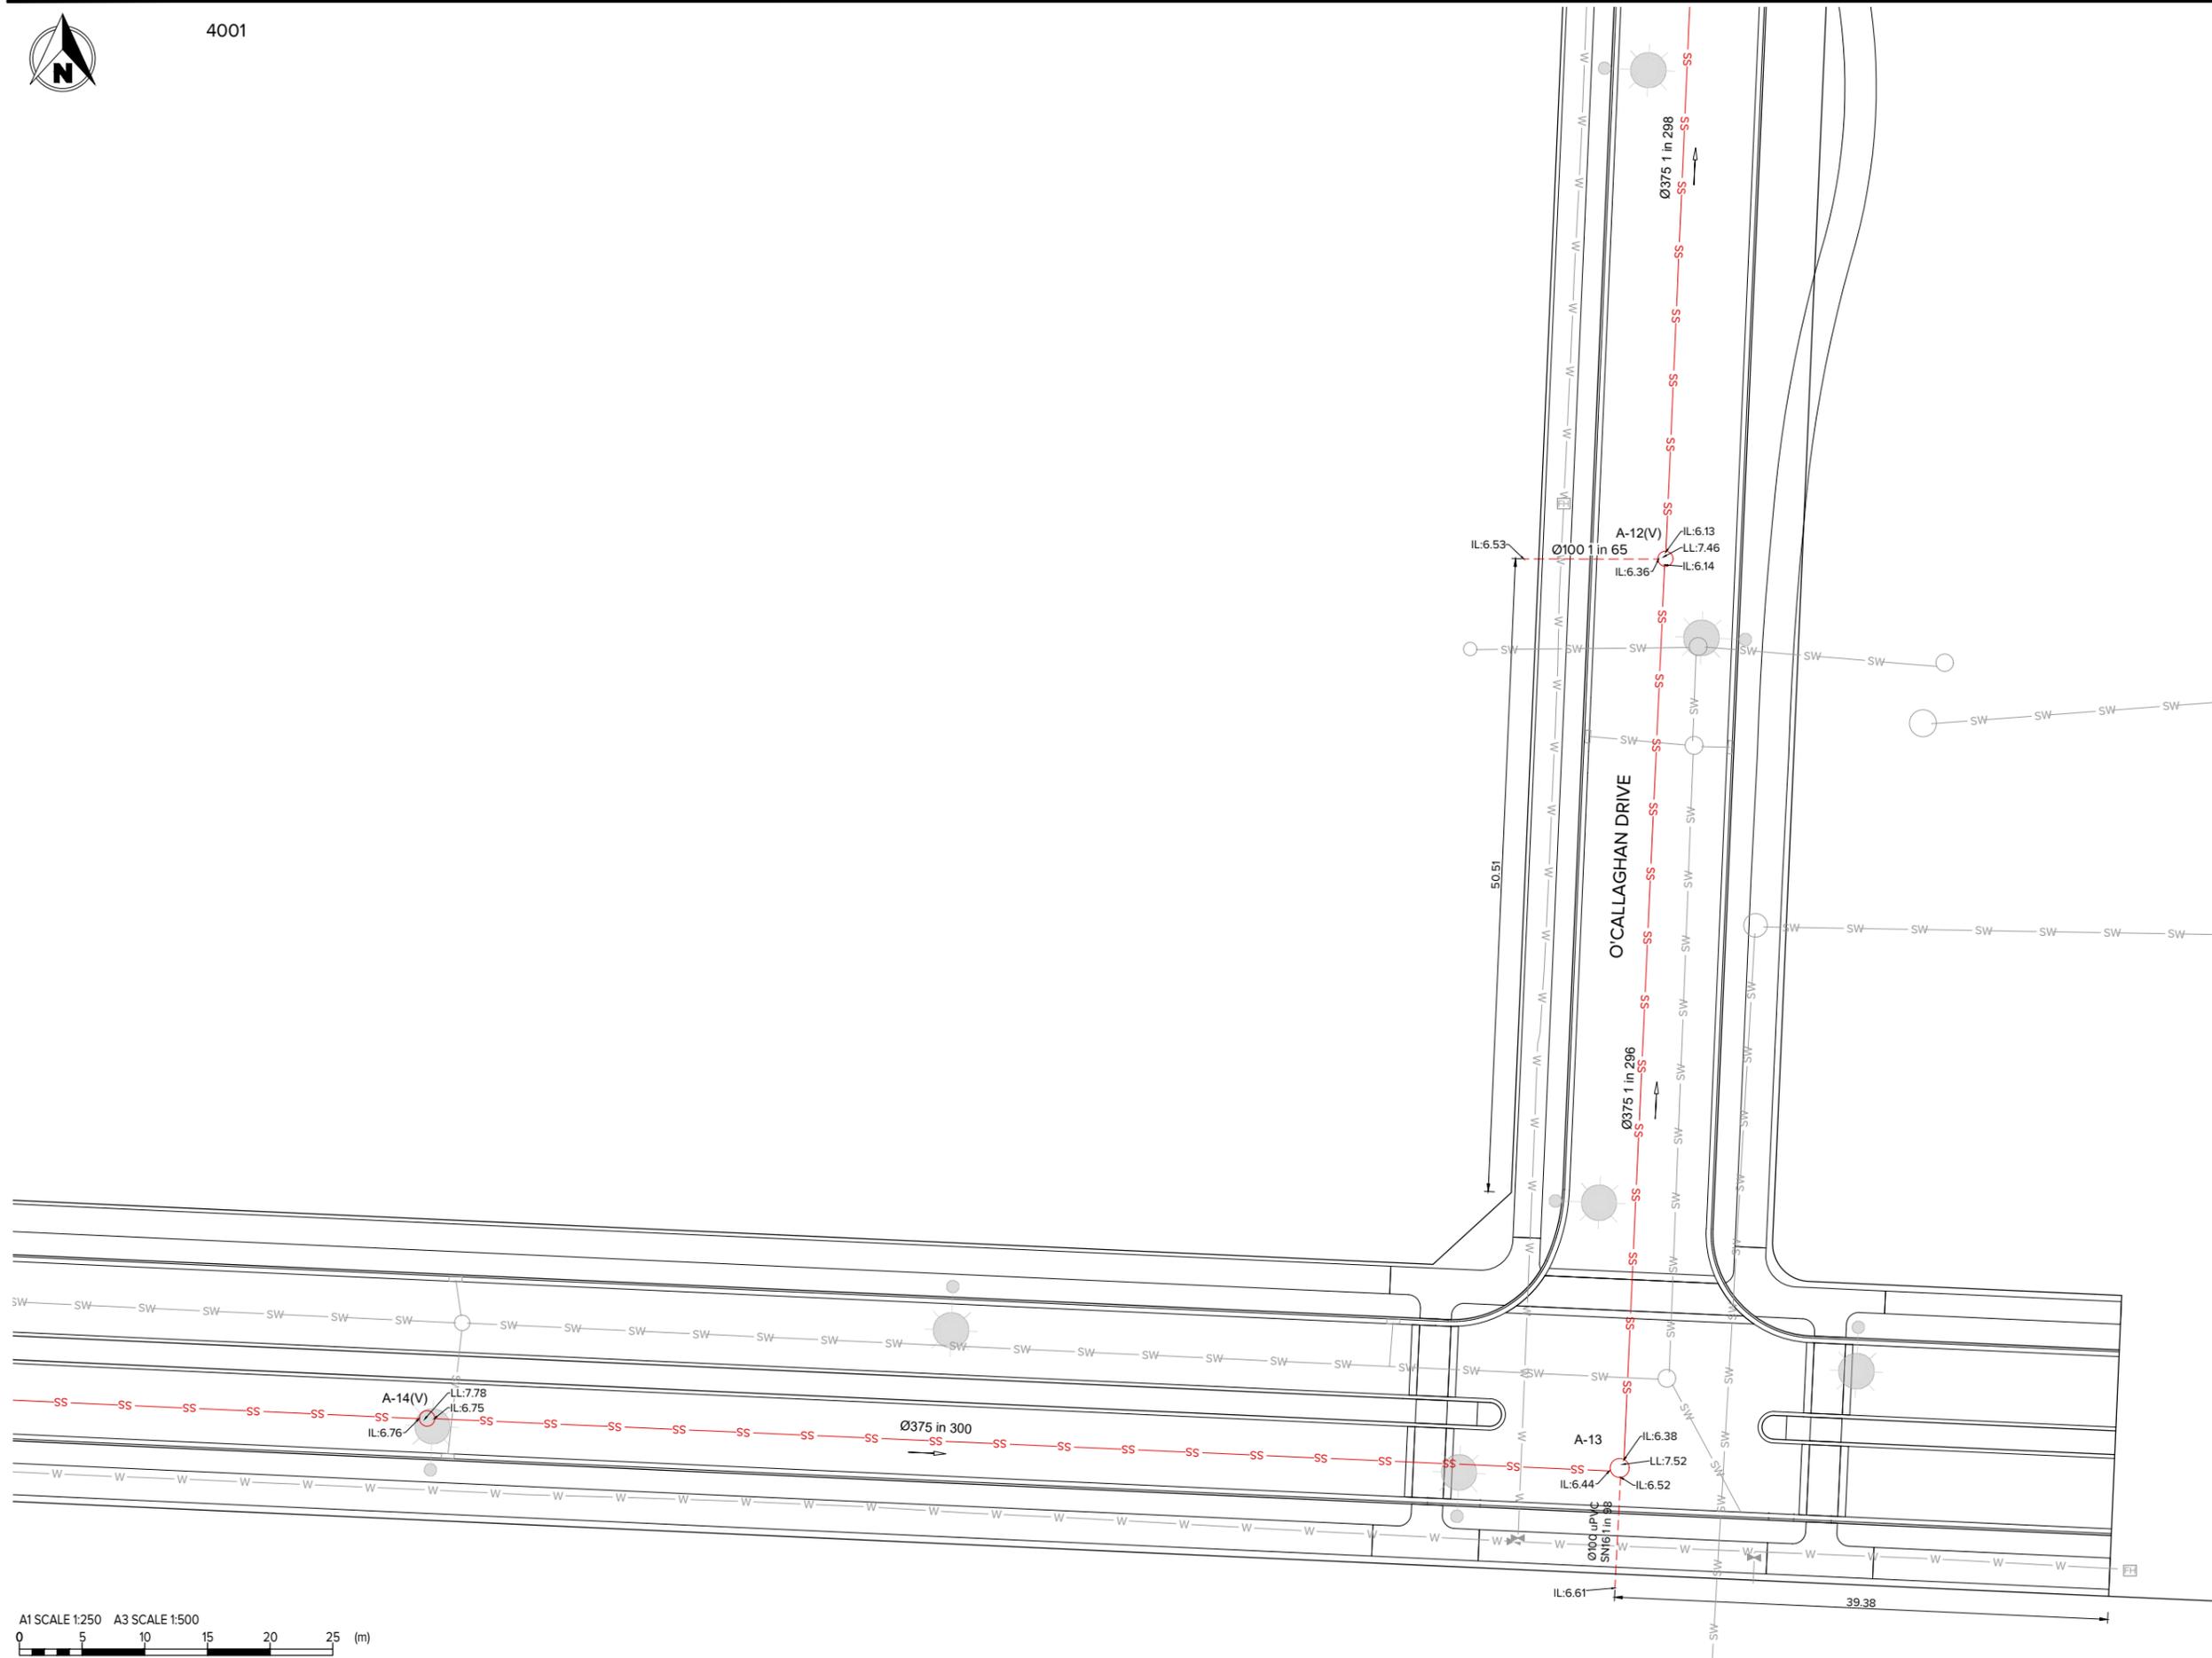

Rev#	Description	Drawn	Date
0	FOR AS-BUILT	IAMcC	28.08.25

INOVO
 Level 1, 93 Manchester St, Christchurch 8022
 Ph. 03 377 3290
 Level 1, Shed 19, Princess Wharf, Auckland 1010
 Ph. 09 600 1099
 www.inovo.nz

Scale A1
1:250
 Scale A3
1:500
 DO NOT SCALE FROM DRAWING

Drawn
AMcC
 Approved
TMcL
 Date
28.08.25

Client
EARLSBROOK
 LINCOLN

Project
**EARLSBROOK
 RESIDENTIAL SUBDIVISION
 STAGE 1**

Drawing Title
**WASTEWATER AS-BUILT
 STAGE 1
 SHEET 16**

Status
**AS-BUILT
 AUG 2025**

Drawing No.
15721-S1-AB-5015

Rev
 0





NOTES

1. CO-ORDINATES ARE IN TERMS OF NEW ZEALAND TRANSVERSE MERCATOR 2000 PROJECTION (NZTM2000).
2. HEIGHTS ARE IN TERMS OF NEW ZEALAND VERTICAL DATUM 2016 (NZVD2016).
3. AS-BUILT DATA CARRIED OUT BY MAUGERS CONTRACTING LTD AND SUPPLIED TO INOVO PROJECTS LTD.
4. PROPOSED BOUNDARIES ARE SUBJECT TO FINAL SURVEY.
5. EXISTING BOUNDARIES SOURCED FROM LINZ DATA SERVICE AND IS TO BE USED IN ACCORDANCE WITH THE INTERNATIONAL CREATIVE COMMONS LICENCE 4.
6. ALL DIMENSIONS ARE IN METRES UNLESS STATED.

LEGEND

- SITE BOUNDARIES
- WASTE WATER MAIN
- WASTE WATER LATERAL
- STREET LIGHT

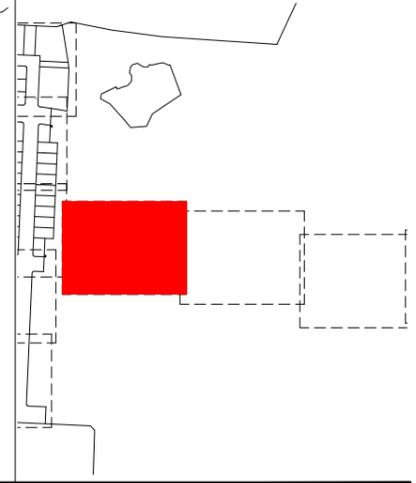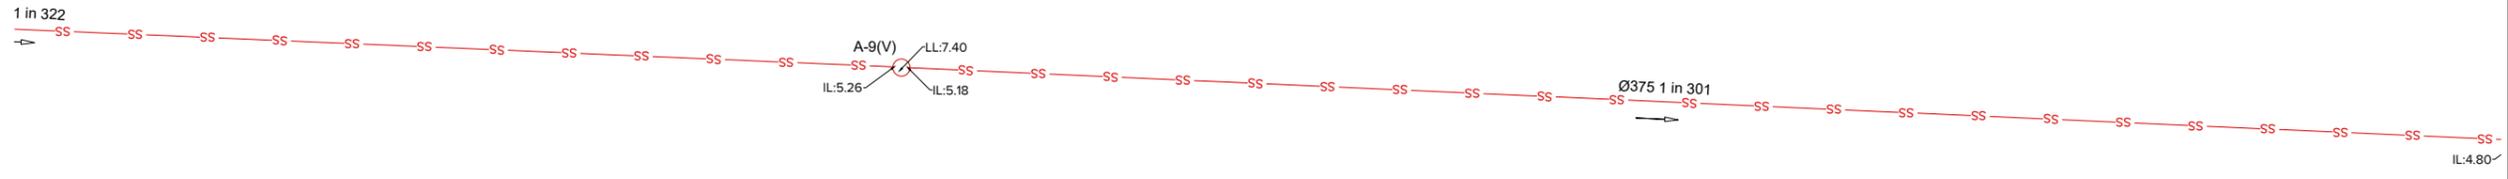

Rev#	Description	Drawn	Date
0	FOR AS-BUILT	AMcC	28.08.25

INOVO
 Level 1, 93 Manchester St, Christchurch 8022
 Ph. 03 377 3290
 Level 1, Shed 19, Princess Wharf, Auckland 1010
 Ph. 09 600 1099
 www.inovo.nz

Scale A1
1:250
 Scale A3
1:500
 DO NOT SCALE FROM DRAWING

Drawn
AMcC
 Approved
TMcL
 Date
28.08.25

Client
EARLSBROOK
 LINCOLN

Project
EARLSBROOK
RESIDENTIAL SUBDIVISION
STAGE 1

Drawing Title
WASTEWATER AS-BUILT
STAGE 1
SHEET 17

Status
AS-BUILT
AUG 2025
 Drawing No.
15721-S1-AB-5016 Rev
 0





NOTES

1. CO-ORDINATES ARE IN TERMS OF NEW ZEALAND TRANSVERSE MERCATOR 2000 PROJECTION (NZTM2000).
2. HEIGHTS ARE IN TERMS OF NEW ZEALAND VERTICAL DATUM 2016 (NZVD2016).
3. AS-BUILT DATA CARRIED OUT BY MAUGERS CONTRACTING LTD AND SUPPLIED TO INOVO PROJECTS LTD.
4. PROPOSED BOUNDARIES ARE SUBJECT TO FINAL SURVEY.
5. EXISTING BOUNDARIES SOURCED FROM LINZ DATA SERVICE AND IS TO BE USED IN ACCORDANCE WITH THE INTERNATIONAL CREATIVE COMMONS LICENCE 4.
6. ALL DIMENSIONS ARE IN METRES UNLESS STATED.

LEGEND

- SITE BOUNDARIES
- WASTE WATER MAIN
- WASTE WATER LATERAL
- STREET LIGHT

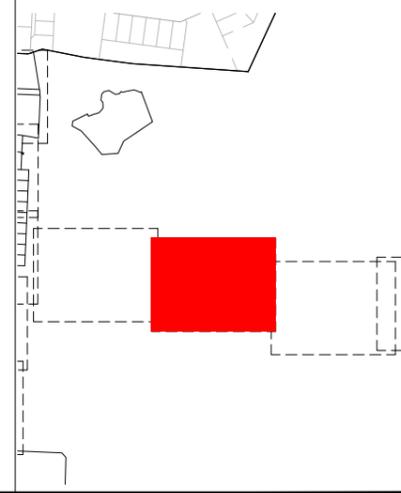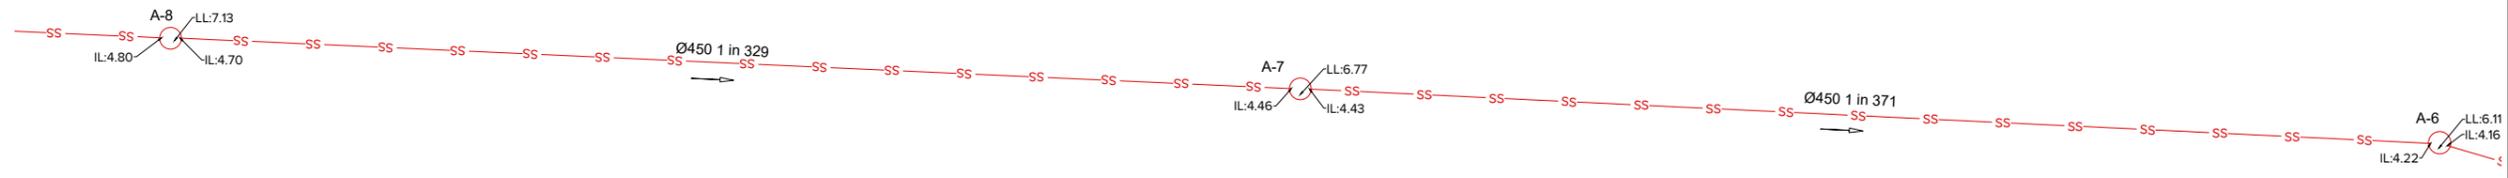

Rev#	Description	Drawn	Date
0	FOR AS-BUILT	IAMcC	28.08.25

INOVO
 Level 1, 93 Manchester St, Christchurch 8022
 Ph. 03 377 3290
 Level 1, Shed 19, Princess Wharf, Auckland 1010
 Ph. 09 600 1099
 www.inovo.nz

Scale A1
1:250
 Scale A3
1:500
 DO NOT SCALE FROM DRAWING

Drawn
AMcC
 Approved
TMcL
 Date
28.08.25

Client
EARLSBROOK
 LINCOLN

Project
EARLSBROOK
RESIDENTIAL SUBDIVISION
STAGE 1

Drawing Title
WASTEWATER AS-BUILT
STAGE 1
SHEET 18

Status
AS-BUILT
AUG 2025
 Drawing No.
15721-S1-AB-5017 Rev
 0





NOTES

1. CO-ORDINATES ARE IN TERMS OF NEW ZEALAND TRANSVERSE MERCATOR 2000 PROJECTION (NZTM2000).
2. HEIGHTS ARE IN TERMS OF NEW ZEALAND VERTICAL DATUM 2016 (NZVD2016).
3. AS-BUILT DATA CARRIED OUT BY MAUGERS CONTRACTING LTD AND SUPPLIED TO INOVO PROJECTS LTD.
4. PROPOSED BOUNDARIES ARE SUBJECT TO FINAL SURVEY.
5. EXISTING BOUNDARIES SOURCED FROM LINZ DATA SERVICE AND IS TO BE USED IN ACCORDANCE WITH THE INTERNATIONAL CREATIVE COMMONS LICENCE 4.
6. ALL DIMENSIONS ARE IN METRES UNLESS STATED.

LEGEND

- SITE BOUNDARIES
- WASTE WATER MAIN
- WASTE WATER LATERAL
- STREET LIGHT

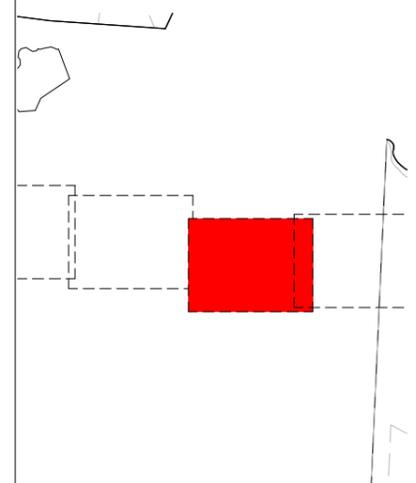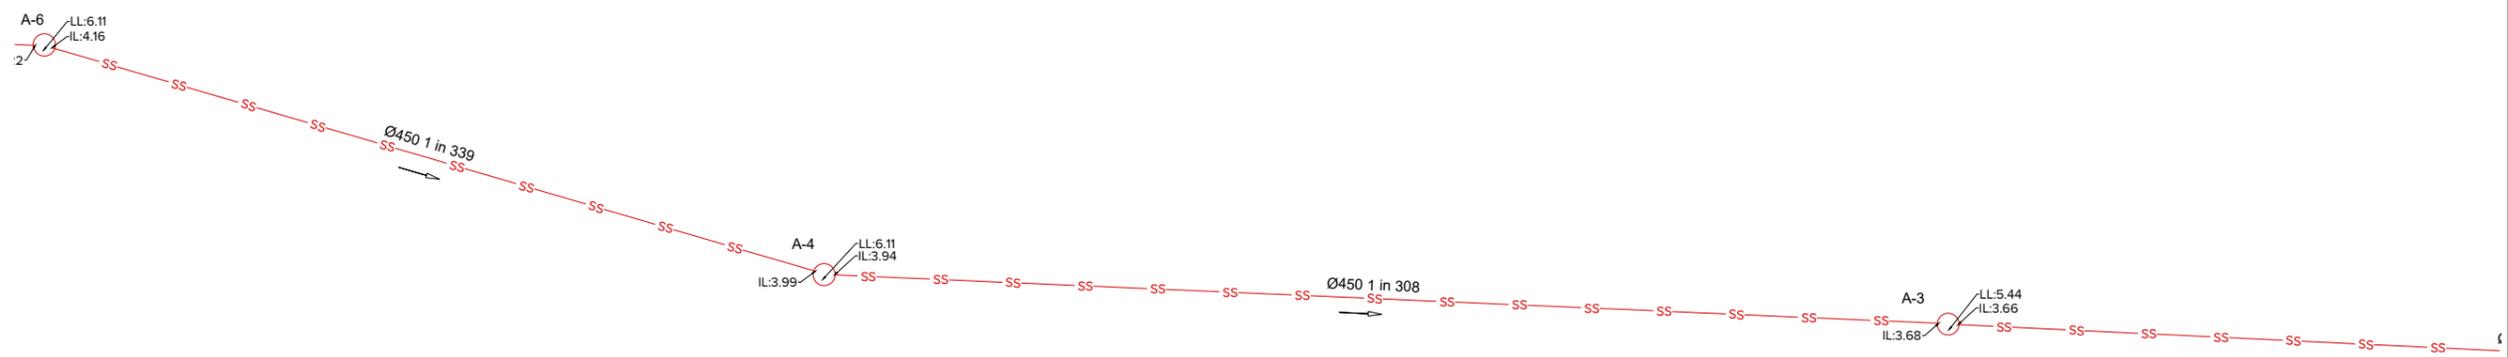

Rev#	Description	Drawn	Date
0	FOR AS-BUILT	IAMcC	28.08.25

INOVO
 Level 1, 93 Manchester St, Christchurch 8022
 Ph. 03 377 3290
 Level 1, Shed 19, Princess Wharf, Auckland 1010
 Ph. 09 600 1099
 www.inovo.nz

Scale A1
1:250
 Scale A3
1:500
 DO NOT SCALE FROM DRAWING

Client

EARLSBROOK
 LINCOLN

Project
EARLSBROOK
RESIDENTIAL SUBDIVISION
STAGE 1

Drawing Title
WASTEWATER AS-BUILT
STAGE 1
SHEET 19

Status
AS-BUILT
AUG 2025
 Drawing No.
15721-S1-AB-5018 Rev
 0




NOTES

1. CO-ORDINATES ARE IN TERMS OF NEW ZEALAND TRANSVERSE MERCATOR 2000 PROJECTION (NZTM2000).
2. HEIGHTS ARE IN TERMS OF NEW ZEALAND VERTICAL DATUM 2016 (NZVD2016).
3. AS-BUILT DATA CARRIED OUT BY MAUGERS CONTRACTING LTD AND SUPPLIED TO INOVO PROJECTS LTD.
4. PROPOSED BOUNDARIES ARE SUBJECT TO FINAL SURVEY.
5. EXISTING BOUNDARIES SOURCED FROM LINZ DATA SERVICE AND IS TO BE USED IN ACCORDANCE WITH THE INTERNATIONAL CREATIVE COMMONS LICENCE 4.
6. ALL DIMENSIONS ARE IN METRES UNLESS STATED.

LEGEND

- SITE BOUNDARIES
- WASTE WATER MAIN
- WASTE WATER LATERAL
- STREET LIGHT

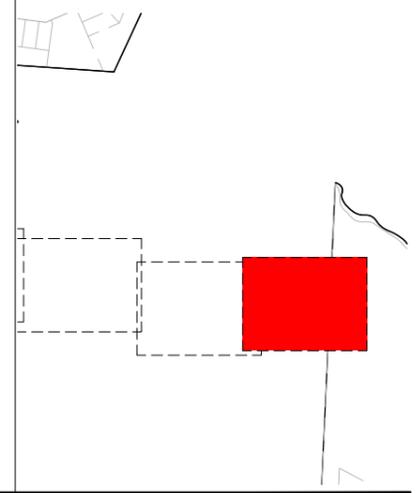

Rev#	Description	Drawn	Date
0	FOR AS-BUILT	AMcC	28.08.25

INOVO
 Level 1, 93 Manchester St, Christchurch 8022
 Ph. 03 377 3290
 Level 1, Shed 19, Princess Wharf, Auckland 1010
 Ph. 09 600 1099
 www.inovo.nz

Scale A1
1:250
Scale A3
1:500
DO NOT SCALE FROM DRAWING

Drawn
AMcC
Approved
TMcL
Date
28.08.25

Client
 EARLSBROOK
LINCOLN

Project
**EARLSBROOK
RESIDENTIAL SUBDIVISION
STAGE 1**

Drawing Title
**WASTEWATER AS-BUILT
STAGE 1
SHEET 20**


Status
**AS-BUILT
AUG 2025**

Drawing No. **15721-S1-AB-5019** Rev **0**



- NOTES**
- AS-BUILT SERVICES DATA HAS BEEN CAPTURED BY GPS SURVEY PRIOR TO BACKFILLING & TRACING OF SERVICES FROM UAV IMAGERY CAPTURED DURING CONSTRUCTION BY MAUGERS CONTRACTING LTD.
 - ALL BURIED SERVICES MUST BE POSITIVELY IDENTIFIED USING CABLE LOCATORS, GROUND PENETRATING RADAR EQUIPMENT OR POT-HOLING BY HYDRO-EXCAVATION BEFORE ANY HAND OR MECHANICAL EXCAVATIONS ARE UNDERTAKEN. THESE PLANS SHOULD NOT BE RELIED ON FOR LOCATION OF SERVICES OR SERVICE TYPE.
 - NOT ALL BURIED SERVICES ARE SHOWN OR IDENTIFIED.
 - DN REFERS TO NOMINAL INTERNAL PIPE DIAMETER (e.g., DN150mm). OD REFERS TO OUTSIDE DIAMETER FOR HDPE PIPE.
 - PROPOSED LOT BOUNDARIES ARE SUBJECT TO FINAL SURVEY. EXISTING LOT BOUNDARIES ARE SOURCED FROM LINZ DATA SERVICE AND USED IN ACCORDANCE WITH THE INTERNATIONAL CREATIVE COMMONS LICENCE 4.0.
 - ALL DIMENSIONS ARE IN METRES UNLESS STATED OTHERWISE.

- LEGEND**
- WATER MAIN DN150 (OD180)
 - WATER MAIN DN200 (OD250)
 - WATER MAIN DN375 (OD450)
 - WATER SUBMAIN (OD63)
 - WATER LATERAL
 - FIRE HYDRANT
 - VALVE
 - WATER METER
 - STREET LIGHT
 - STORMWATER MAIN
 - STORMWATER LATERAL
 - STORMWATER MANHOLE
 - STORMWATER SUMP
 - WASTE WATER MAIN
 - WASTE WATER LATERAL
 - WASTE WATER MANHOLE

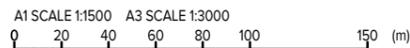

Rev#	Description	Drawn	Date
1	UPDATED INFORMATION ADDED	LB	24.09.25
0	FOR AS-BUILT	AMcC	04.09.25

INOVO
 Level 1, 93 Manchester St, Christchurch 8022
 Ph. 03 377 3290
 Level 1, Shed 19, Princess Wharf, Auckland 1010
 Ph. 09 600 1099
 www.inovo.nz

Scale A1
1:1,500
 Scale A3
1:3,000
 DO NOT SCALE FROM DRAWING

Drawn
AMcC
 Approved
TMcL
 Date
04.09.25

Client
EARLSBROOK
LINCOLN


Project
EARLSBROOK RESIDENTIAL SUBDIVISION STAGE 1

Drawing Title
WATER SERVICE AS-BUILT STAGE 1 OVERVIEW

Status
AS-BUILT SEPT 2025

Drawing No.
15721-S1-AB-6000

Rev
1

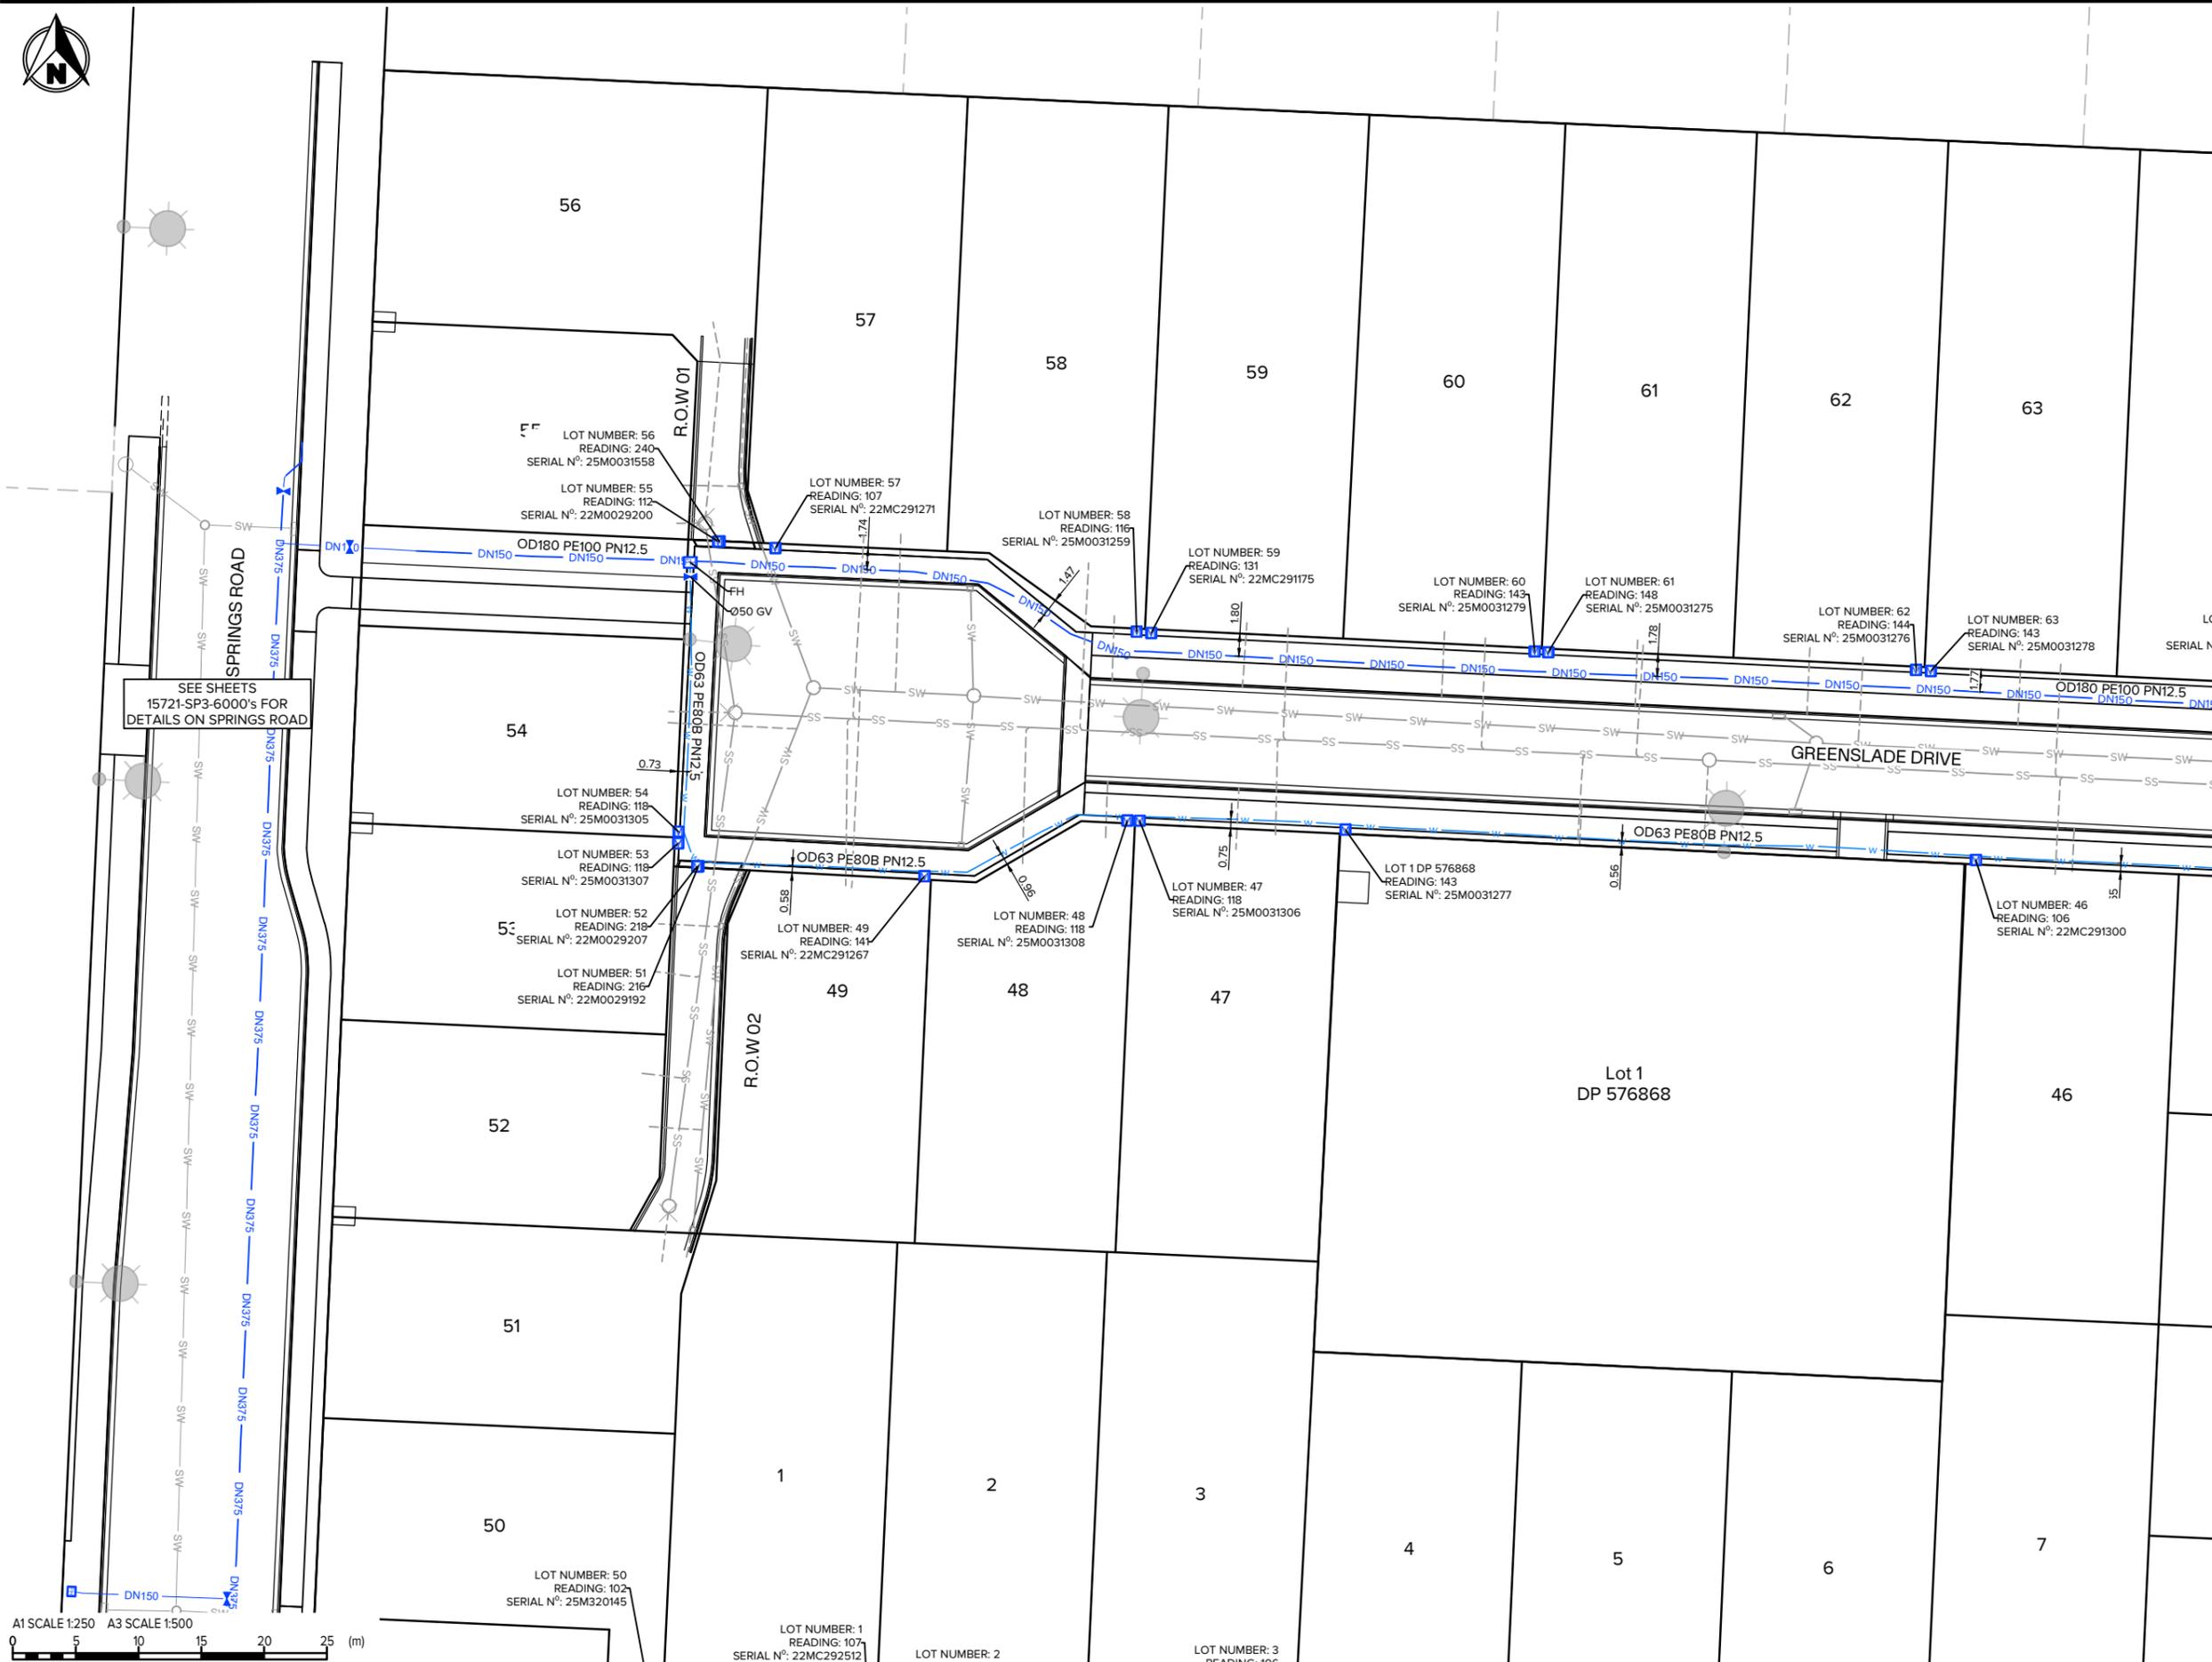

- NOTES**
- AS-BUILT SERVICES DATA HAS BEEN CAPTURED BY GPS SURVEY PRIOR TO BACKFILLING & TRACING OF SERVICES FROM UAV IMAGERY CAPTURED DURING CONSTRUCTION BY MAUGERS CONTRACTING LTD.
 - ALL BURIED SERVICES MUST BE POSITIVELY IDENTIFIED USING CABLE LOCATORS, GROUND PENETRATING RADAR EQUIPMENT OR POT-HOLING BY HYDRO-EXCAVATION BEFORE ANY HAND OR MECHANICAL EXCAVATIONS ARE UNDERTAKEN. THESE PLANS SHOULD NOT BE RELIED ON FOR LOCATION OF SERVICES OR SERVICE TYPE.
 - NOT ALL BURIED SERVICES ARE SHOWN OR IDENTIFIED.
 - DN REFERS TO NOMINAL INTERNAL PIPE DIAMETER (e.g., DN150mm). OD REFERS TO OUTSIDE DIAMETER FOR HDPE PIPE.
 - PROPOSED LOT BOUNDARIES ARE SUBJECT TO FINAL SURVEY. EXISTING LOT BOUNDARIES ARE SOURCED FROM LINZ DATA SERVICE AND USED IN ACCORDANCE WITH THE INTERNATIONAL CREATIVE COMMONS LICENCE 4.0.
 - ALL DIMENSIONS ARE IN METRES UNLESS STATED OTHERWISE.

- LEGEND**
- DN150 WATER MAIN DN150 (OD180)
 - DN200 WATER MAIN DN200 (OD250)
 - DN375 WATER MAIN DN375 (OD450)
 - w-w WATER SUBMAIN (OD63)
 - - - WATER LATERAL
 - FH FIRE HYDRANT
 - Valve symbol VALVE
 - M Water Meter symbol WATER METER
 - Street Light symbol STREET LIGHT
 - SW Stormwater Main symbol STORMWATER MAIN
 - - - Stormwater Lateral symbol STORMWATER LATERAL
 - Manhole symbol STORMWATER MANHOLE
 - Sump symbol STORMWATER SUMP
 - SS Waste Water Main symbol WASTE WATER MAIN
 - - - Waste Water Lateral symbol WASTE WATER LATERAL
 - Manhole symbol WASTE WATER MANHOLE

SEE SHEETS 15721-SP3-6000'S FOR DETAILS ON SPRINGS ROAD



Rev#	Description	Drawn	Date
1	UPDATED INFORMATION ADDED	LB	24.09.25
0	FOR AS-BUILT	AMC	04.09.25

INOVO
 Level 1, 93 Manchester St, Christchurch 8022
 Ph. 03 377 3290
 Level 1, Shed 19, Princess Wharf, Auckland 1010
 Ph. 09 600 1099
 www.inovo.nz

Scale A1 1:250
 Scale A3 1:500
 DO NOT SCALE FROM DRAWING


Client
EARLSBROOK LINCOLN

Project
EARLSBROOK RESIDENTIAL SUBDIVISION STAGE 1

Drawing Title
WATER SERVICE AS-BUILT STAGE 1 SHEET 1


Status
AS-BUILT SEPT 2025

Drawing No. **15721-S1-AB-6001** Rev **1**

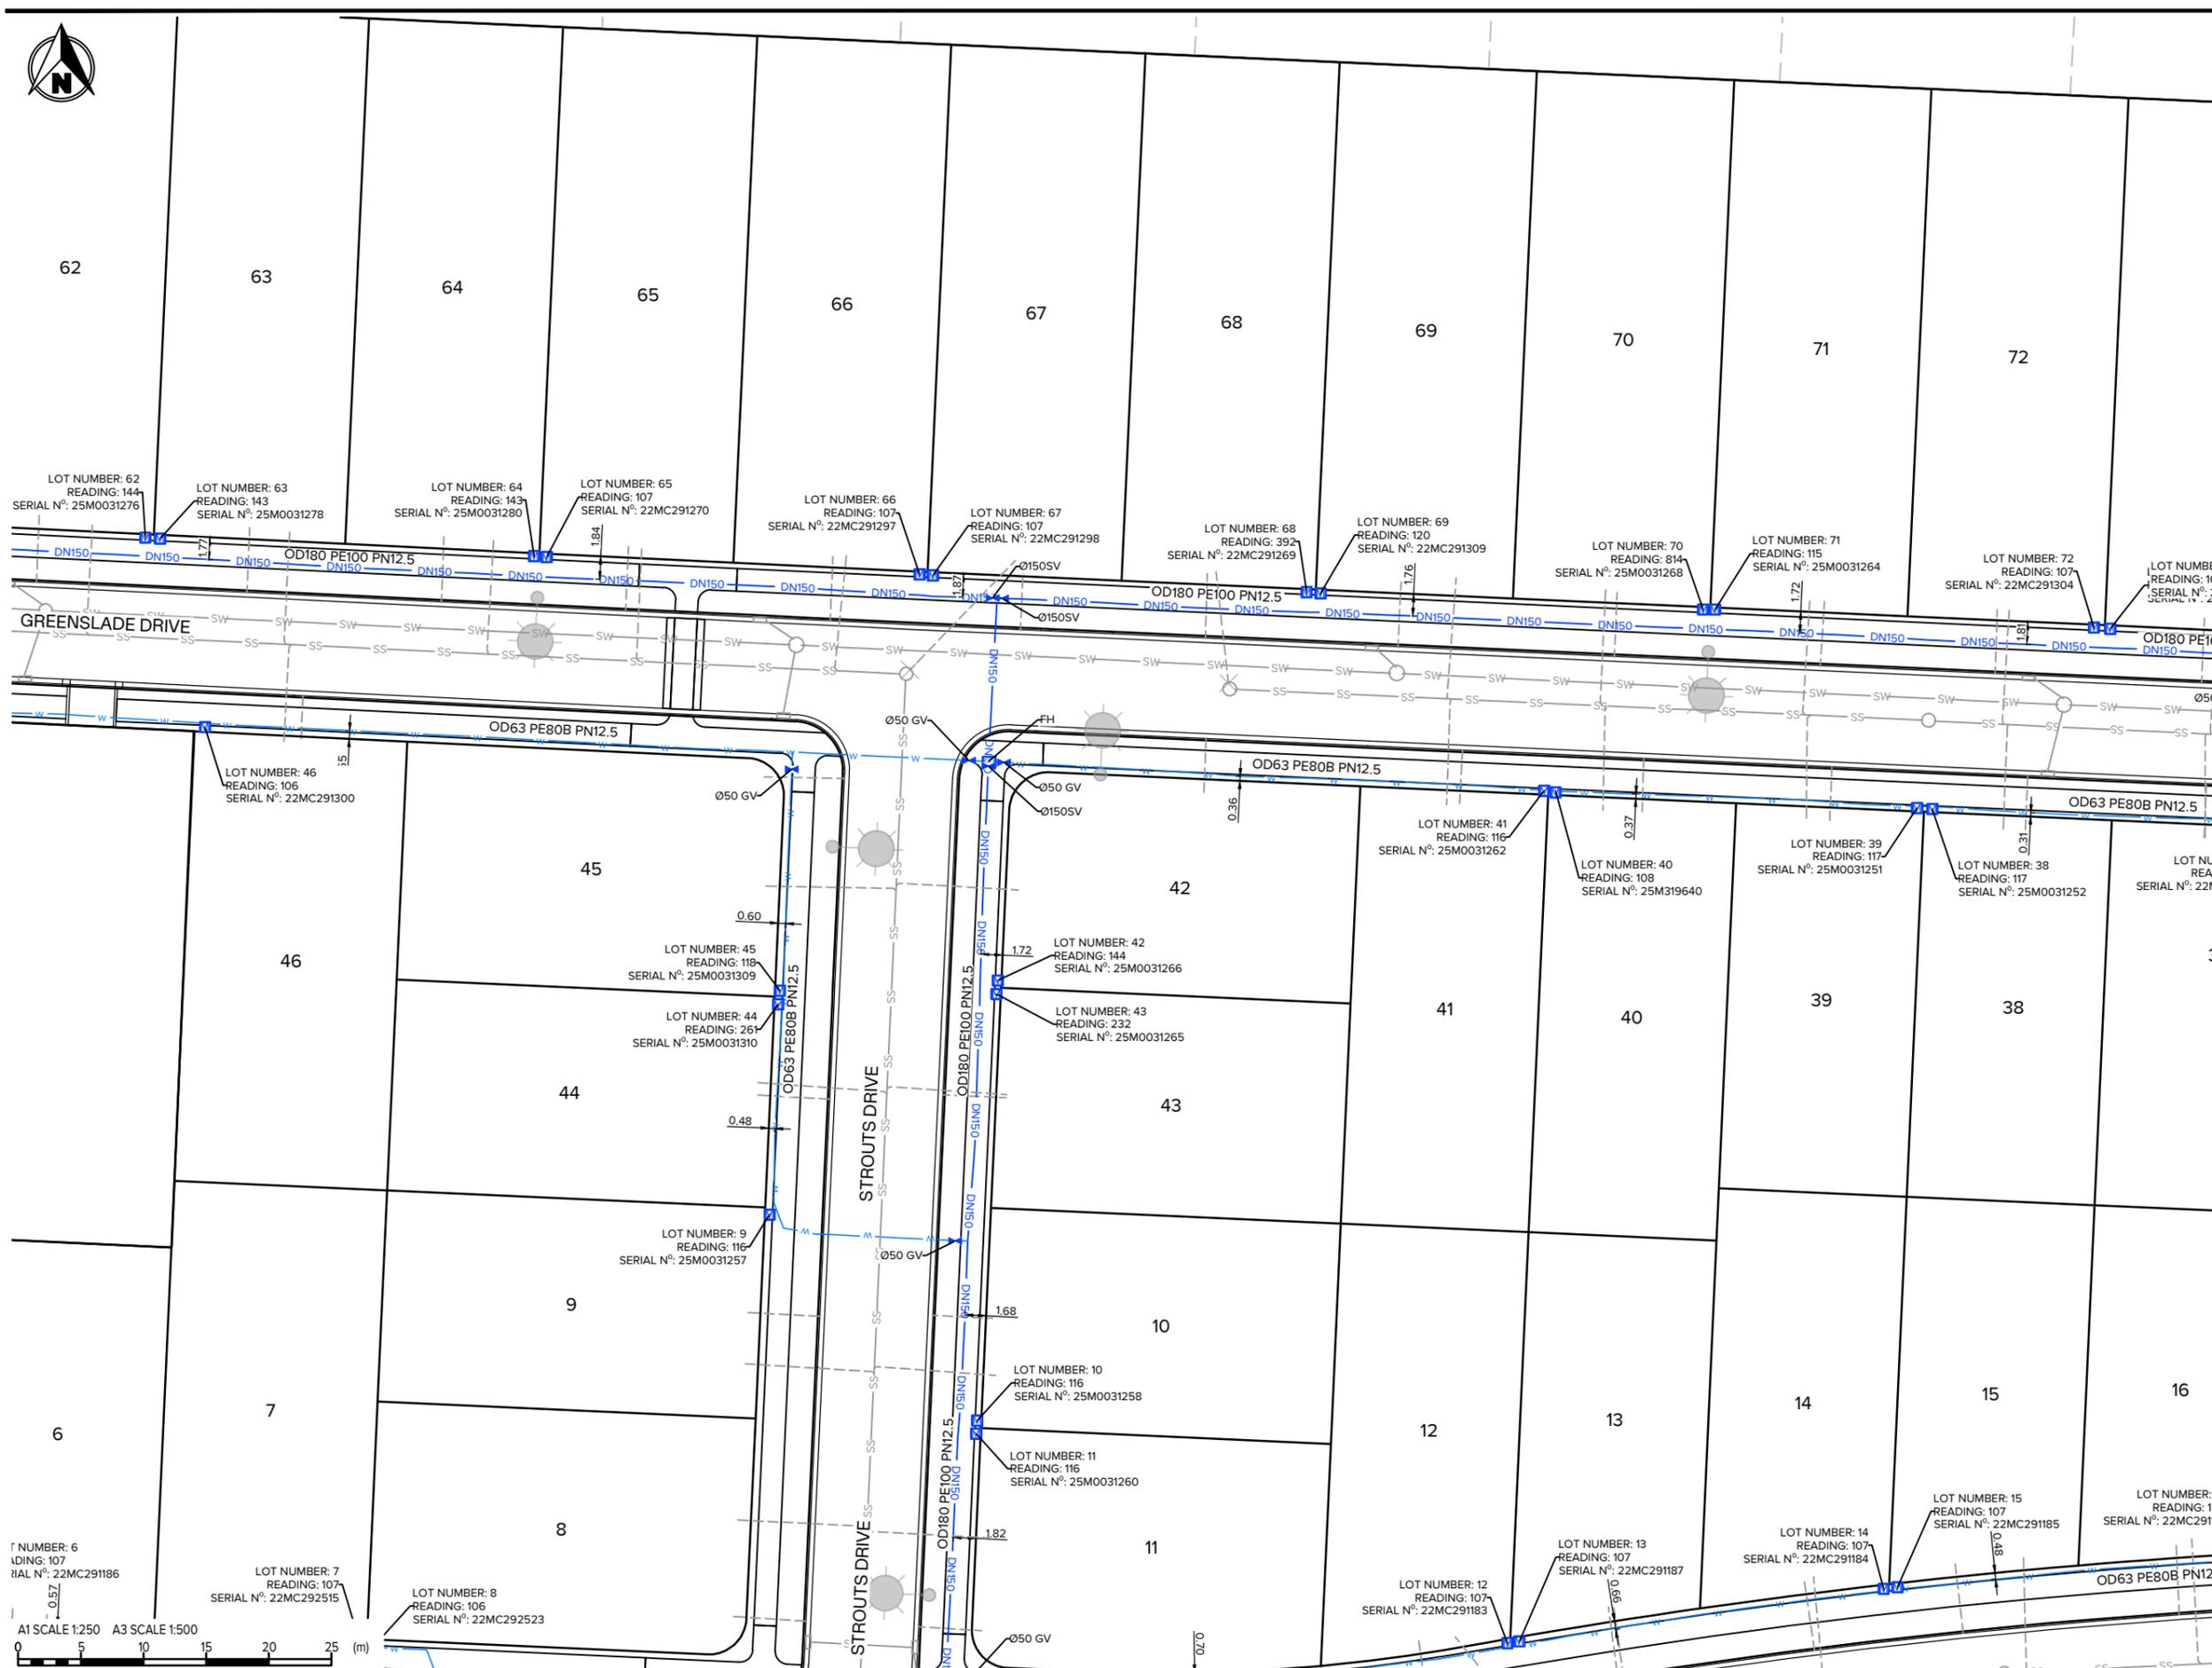

- NOTES**
- AS-BUILT SERVICES DATA HAS BEEN CAPTURED BY GPS SURVEY PRIOR TO BACKFILLING & TRACING OF SERVICES FROM UAV IMAGERY CAPTURED DURING CONSTRUCTION BY MAUGERS CONTRACTING LTD.
 - ALL BURIED SERVICES MUST BE POSITIVELY IDENTIFIED USING CABLE LOCATORS, GROUND PENETRATING RADAR EQUIPMENT OR POT-HOLING BY HYDRO-EXCAVATION BEFORE ANY HAND OR MECHANICAL EXCAVATIONS ARE UNDERTAKEN. THESE PLANS SHOULD NOT BE RELIED ON FOR LOCATION OF SERVICES OR SERVICE TYPE.
 - NOT ALL BURIED SERVICES ARE SHOWN OR IDENTIFIED.
 - DN REFERS TO NOMINAL INTERNAL PIPE DIAMETER (e.g., DN150mm). OD REFERS TO OUTSIDE DIAMETER FOR HDPE PIPE.
 - PROPOSED LOT BOUNDARIES ARE SUBJECT TO FINAL SURVEY. EXISTING LOT BOUNDARIES ARE SOURCED FROM LINZ DATA SERVICE AND USED IN ACCORDANCE WITH THE INTERNATIONAL CREATIVE COMMONS LICENCE 4.0.
 - ALL DIMENSIONS ARE IN METRES UNLESS STATED OTHERWISE.

- LEGEND**
- DN150 WATER MAIN DN150 (OD180)
 - DN200 WATER MAIN DN200 (OD250)
 - DN375 WATER MAIN DN375 (OD450)
 - W-W WATER SUBMAIN (OD63)
 - WATER LATERAL
 - FH FIRE HYDRANT
 - V VALVE
 - M WATER METER
 - SL STREET LIGHT
 - SW SW STORMWATER MAIN
 - STORMWATER LATERAL
 - STORMWATER MANHOLE
 - STORMWATER SUMP
 - SS SS WASTE WATER MAIN
 - WASTE WATER LATERAL
 - WASTE WATER MANHOLE

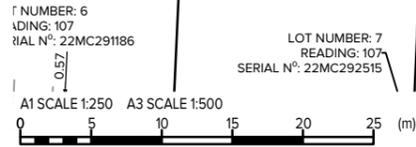

Rev#	Description	Drawn	Date
1	UPDATED INFORMATION ADDED	LB	24.09.25
0	FOR AS-BUILT	AMC	04.09.25

INOVO
 Level 1, 93 Manchester St, Christchurch 8022
 Ph. 03 377 3290
 Level 1, Shed 19, Princess Wharf, Auckland 1010
 Ph. 09 600 1099
 www.inovo.nz

Scale A1 1:250
 Scale A3 1:500
 DO NOT SCALE FROM DRAWING

Drawn AMcC
 Approved TMCL
 Date 04.09.25

Client **EARLSBROOK LINCOLN**

Project **EARLSBROOK RESIDENTIAL SUBDIVISION STAGE 1**

Drawing Title **WATER SERVICE AS-BUILT STAGE 1 SHEET 2**

Status **AS-BUILT SEPT 2025**

Drawing No. **15721-S1-AB-6002** Rev 1



- NOTES**
- AS-BUILT SERVICES DATA HAS BEEN CAPTURED BY GPS SURVEY PRIOR TO BACKFILLING & TRACING OF SERVICES FROM UAV IMAGERY CAPTURED DURING CONSTRUCTION BY MAUGERS CONTRACTING LTD.
 - ALL BURIED SERVICES MUST BE POSITIVELY IDENTIFIED USING CABLE LOCATORS, GROUND PENETRATING RADAR EQUIPMENT OR POT-HOLING BY HYDRO-EXCAVATION BEFORE ANY HAND OR MECHANICAL EXCAVATIONS ARE UNDERTAKEN. THESE PLANS SHOULD NOT BE RELIED ON FOR LOCATION OF SERVICES OR SERVICE TYPE.
 - NOT ALL BURIED SERVICES ARE SHOWN OR IDENTIFIED.
 - DN REFERS TO NOMINAL INTERNAL PIPE DIAMETER (e.g., DN150mm). OD REFERS TO OUTSIDE DIAMETER FOR HDPE PIPE.
 - PROPOSED LOT BOUNDARIES ARE SUBJECT TO FINAL SURVEY. EXISTING LOT BOUNDARIES ARE SOURCED FROM LINZ DATA SERVICE AND USED IN ACCORDANCE WITH THE INTERNATIONAL CREATIVE COMMONS LICENCE 4.0.
 - ALL DIMENSIONS ARE IN METRES UNLESS STATED OTHERWISE.

- LEGEND**
- DN150 — WATER MAIN DN150 (OD180)
 - DN200 — WATER MAIN DN200 (OD250)
 - DN375 — WATER MAIN DN375 (OD450)
 - w — w — WATER SUBMAIN (OD63)
 - - - - - WATER LATERAL
 - ⊕ FIRE HYDRANT
 - ⊕ VALVE
 - ⊕ WATER METER
 - ⊕ STREET LIGHT
 - SW — SW — STORMWATER MAIN
 - - - - - STORMWATER LATERAL
 - STORMWATER MANHOLE
 - ◻ STORMWATER SUMP
 - SS — SS — WASTE WATER MAIN
 - - - - - WASTE WATER LATERAL
 - WASTE WATER MANHOLE



Rev#	Description	Drawn	Date
1	UPDATED INFORMATION ADDED	LB	24.09.25
0	FOR AS-BUILT	AMC	04.09.25

INOVO
 Level 1, 93 Manchester St, Christchurch 8022
 Ph. 03 377 3290
 Level 1, Shed 19, Princess Wharf, Auckland 1010
 Ph. 09 600 1099
 www.inovo.nz

Scale A1
1:250
Scale A3
1:500
DO NOT SCALE FROM DRAWING


Drawn
AMC
Approved
TMCL
Date
04.09.25

Client
EARLSBROOK LINCOLN

Project
EARLSBROOK RESIDENTIAL SUBDIVISION STAGE 1


Drawing Title
WATER SERVICE AS-BUILT STAGE 1 SHEET 3

Status
AS-BUILT SEPT 2025

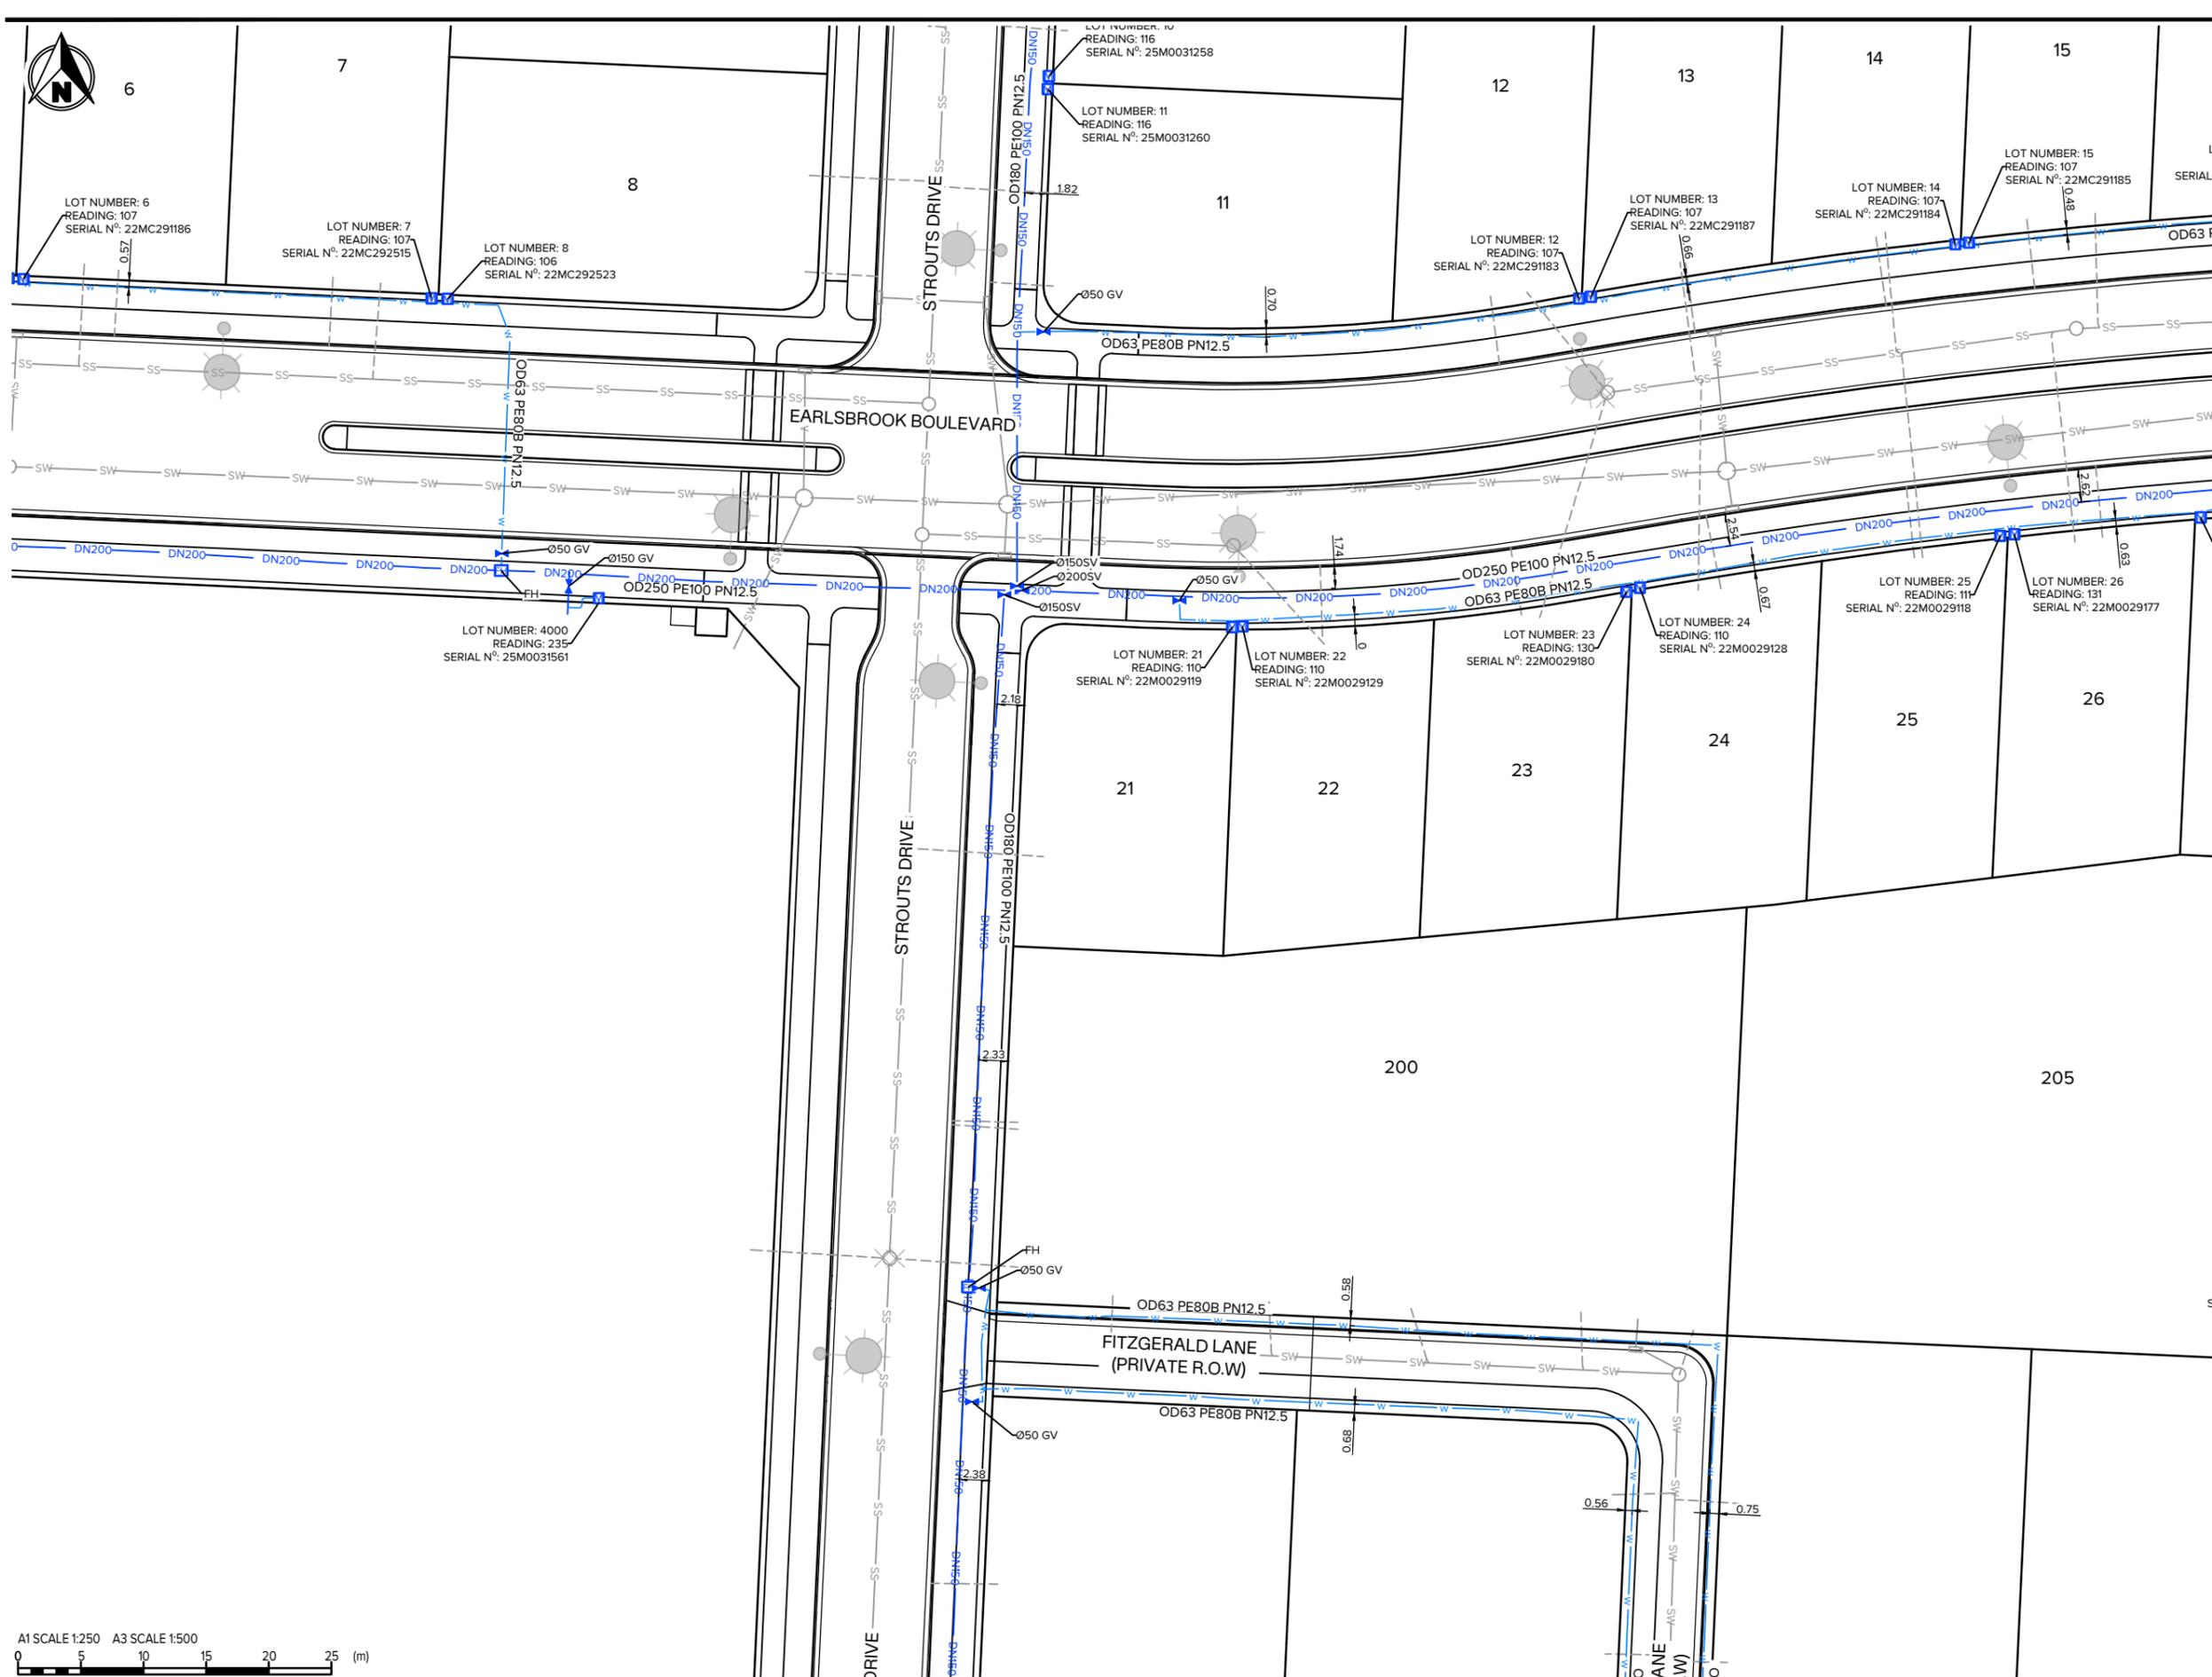

- ### NOTES
- AS-BUILT SERVICES DATA HAS BEEN CAPTURED BY GPS SURVEY PRIOR TO BACKFILLING & TRACING OF SERVICES FROM UAV IMAGERY CAPTURED DURING CONSTRUCTION BY MAUGERS CONTRACTING LTD.
 - ALL BURIED SERVICES MUST BE POSITIVELY IDENTIFIED USING CABLE LOCATORS, GROUND PENETRATING RADAR EQUIPMENT OR POT-HOLING BY HYDRO-EXCAVATION BEFORE ANY HAND OR MECHANICAL EXCAVATIONS ARE UNDERTAKEN. THESE PLANS SHOULD NOT BE RELIED ON FOR LOCATION OF SERVICES OR SERVICE TYPE.
 - NOT ALL BURIED SERVICES ARE SHOWN OR IDENTIFIED.
 - DN REFERS TO NOMINAL INTERNAL PIPE DIAMETER (e.g., DN150mm). OD REFERS TO OUTSIDE DIAMETER FOR HDPE PIPE.
 - PROPOSED LOT BOUNDARIES ARE SUBJECT TO FINAL SURVEY. EXISTING LOT BOUNDARIES ARE SOURCED FROM LINZ DATA SERVICE AND USED IN ACCORDANCE WITH THE INTERNATIONAL CREATIVE COMMONS LICENCE 4.0.
 - ALL DIMENSIONS ARE IN METRES UNLESS STATED OTHERWISE.

- ### LEGEND
- DN150 WATER MAIN DN150 (OD180)
 - DN200 WATER MAIN DN200 (OD250)
 - DN375 WATER MAIN DN375 (OD450)
 - w WATER SUBMAIN (OD63)
 - WATER LATERAL
 - FH FIRE HYDRANT
 - V VALVE
 - M WATER METER
 - SL STREET LIGHT
 - SW SW STORMWATER MAIN
 - SW STORMWATER LATERAL
 - SW STORMWATER MANHOLE
 - ◇ SW STORMWATER SUMP
 - SS SS WASTE WATER MAIN
 - SS WASTE WATER LATERAL
 - SS WASTE WATER MANHOLE

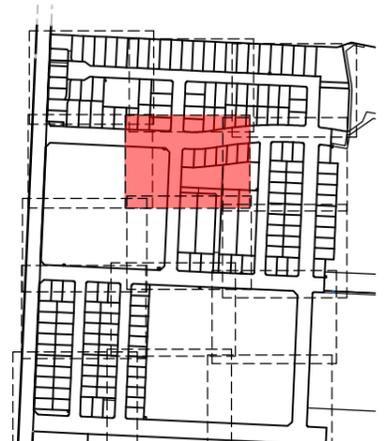

Rev#	Description	Drawn	Date
1	UPDATED INFORMATION ADDED	LB	24.09.25
0	FOR AS-BUILT	AMcC	04.09.25

INOVO
 Level 1, 93 Manchester St, Christchurch 8022
 Ph. 03 377 3290
 Level 1, Shed 19, Princess Wharf, Auckland 1010
 Ph. 09 600 1099
 www.inovo.nz

Scale A1 1:250
 Scale A3 1:500
 DO NOT SCALE FROM DRAWING

Drawn AMcC
 Approved TMCL
 Date 04.09.25


Client **EARLSBROOK LINCOLN**

Project **EARLSBROOK RESIDENTIAL SUBDIVISION STAGE 1**

Drawing Title **WATER SERVICE AS-BUILT STAGE 1 SHEET 5**


Status **AS-BUILT SEPT 2025**

Drawing No. **15721-S1-AB-6005** Rev 1

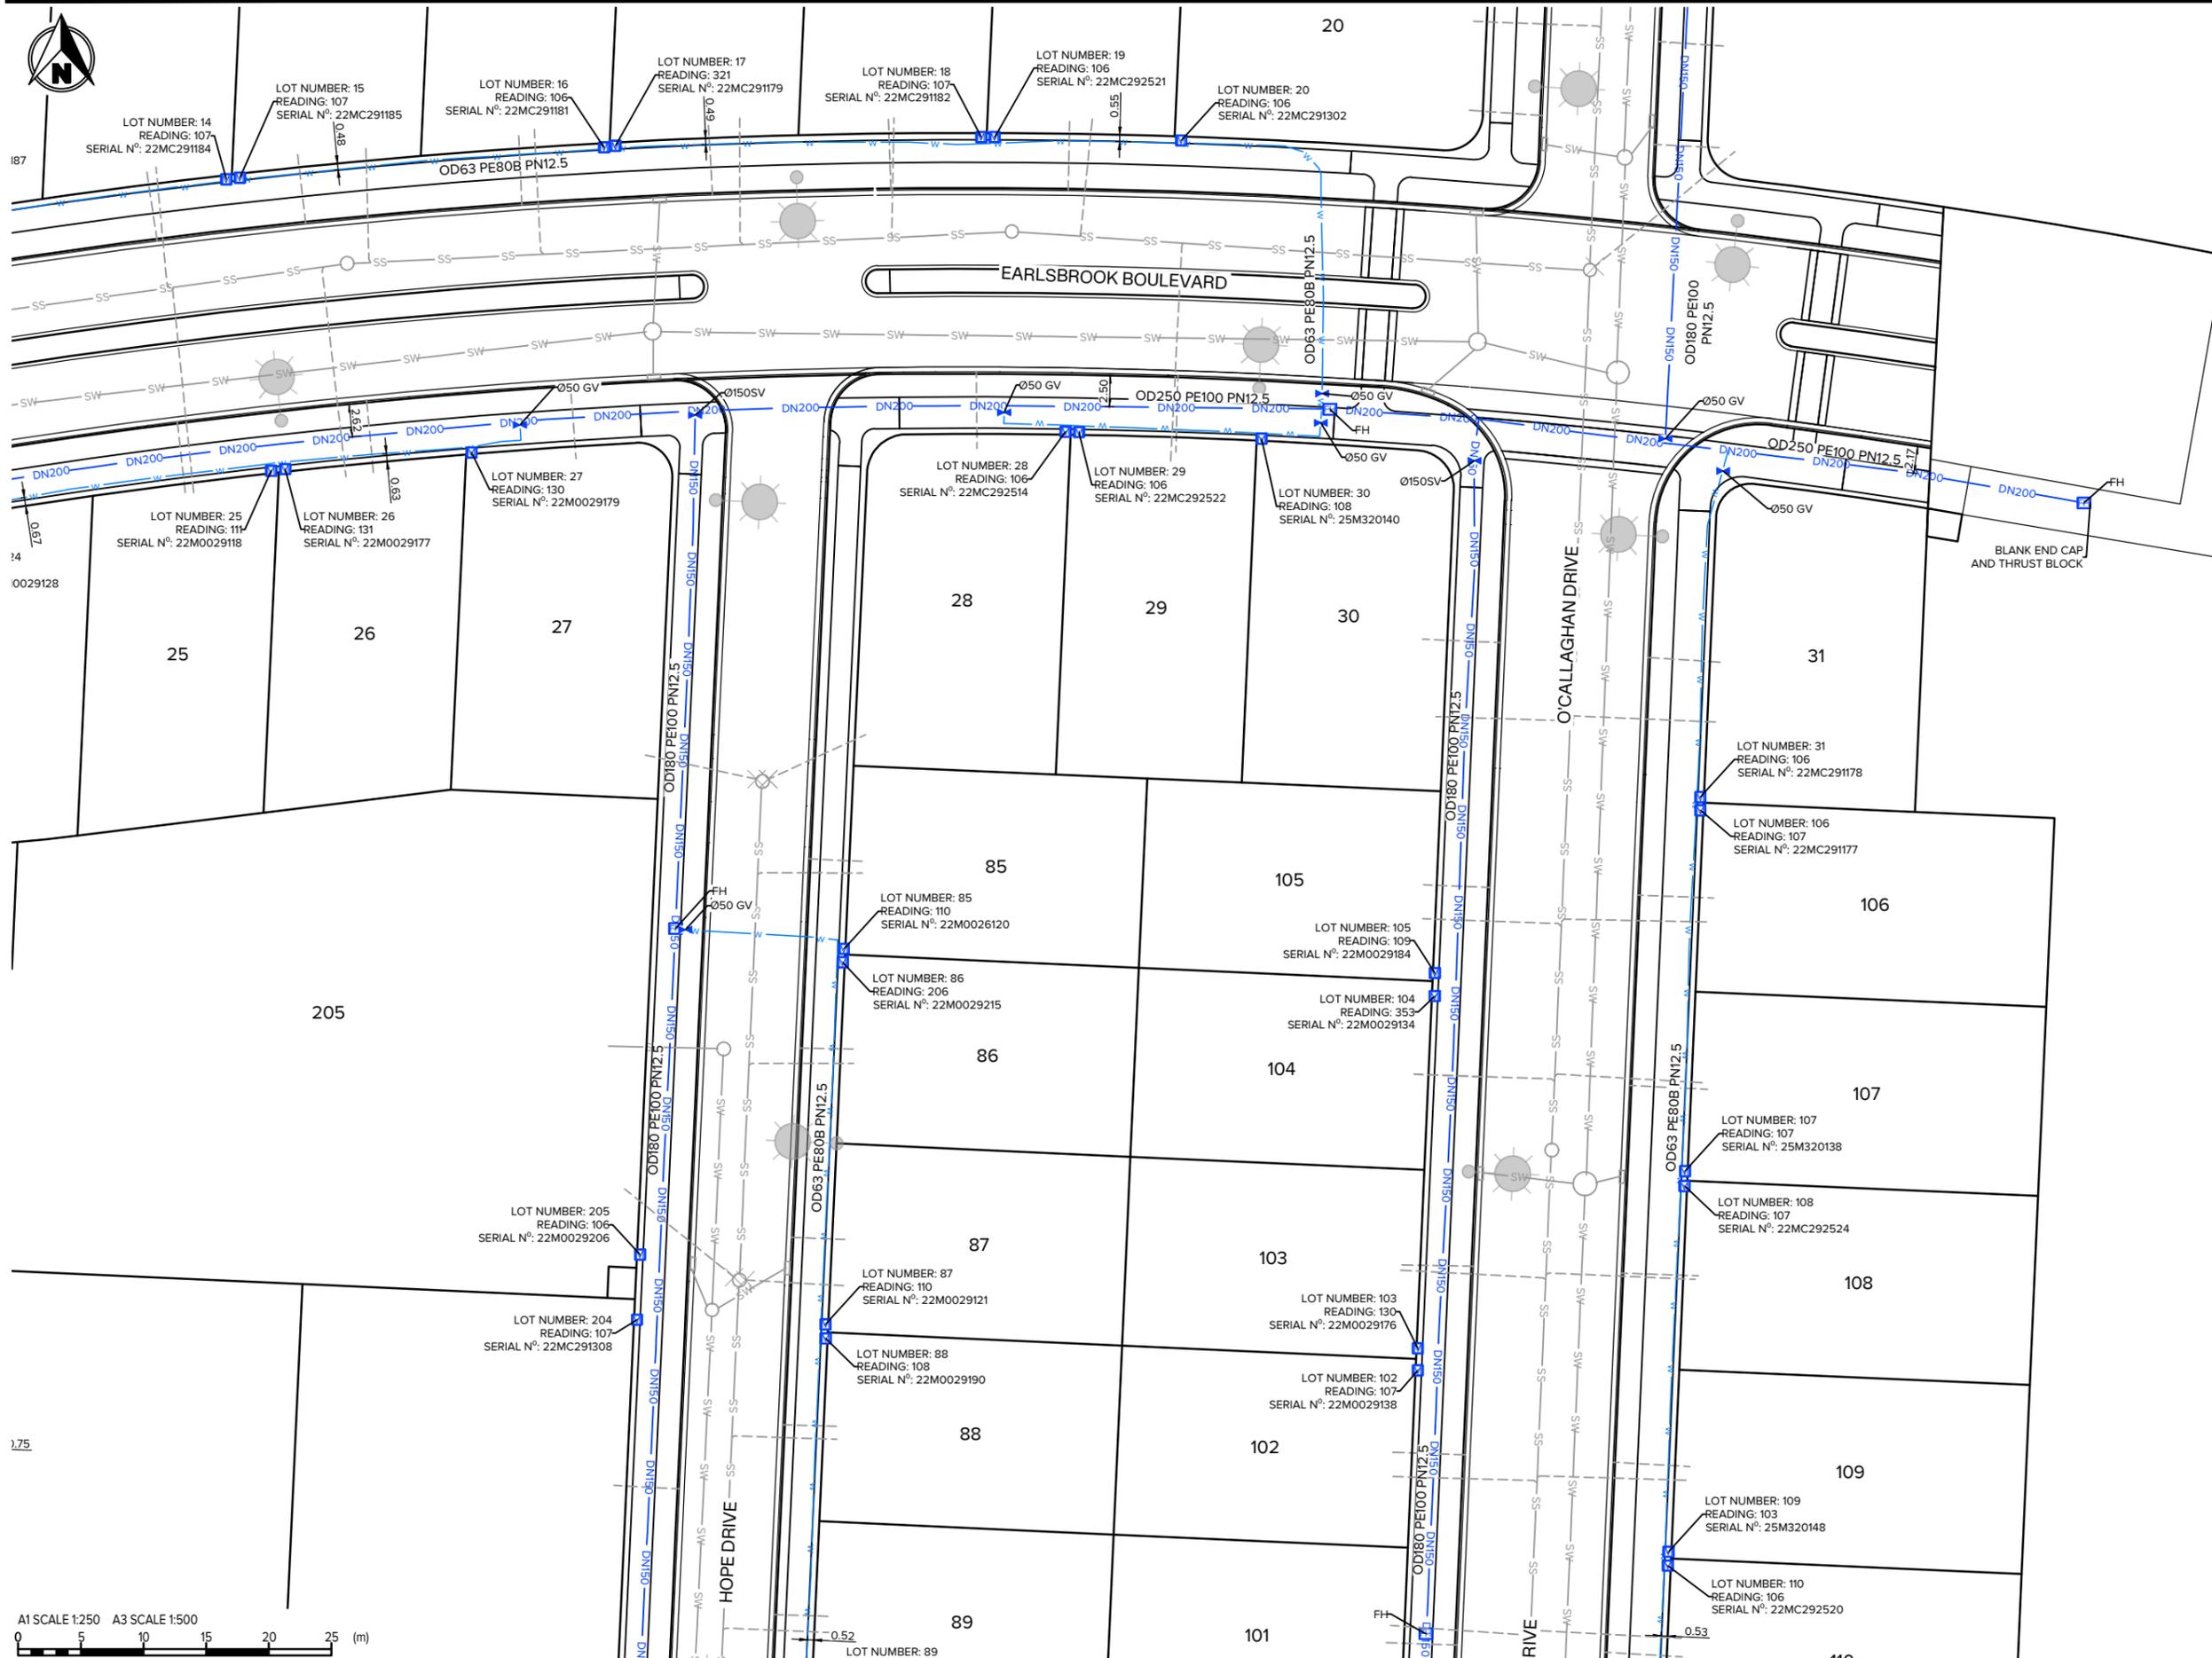

- ### NOTES
- AS-BUILT SERVICES DATA HAS BEEN CAPTURED BY GPS SURVEY PRIOR TO BACKFILLING & TRACING OF SERVICES FROM UAV IMAGERY CAPTURED DURING CONSTRUCTION BY MAUGERS CONTRACTING LTD.
 - ALL BURIED SERVICES MUST BE POSITIVELY IDENTIFIED USING CABLE LOCATORS, GROUND PENETRATING RADAR EQUIPMENT OR POT-HOLING BY HYDRO-EXCAVATION BEFORE ANY HAND OR MECHANICAL EXCAVATIONS ARE UNDERTAKEN. THESE PLANS SHOULD NOT BE RELIED ON FOR LOCATION OF SERVICES OR SERVICE TYPE.
 - NOT ALL BURIED SERVICES ARE SHOWN OR IDENTIFIED.
 - DN REFERS TO NOMINAL INTERNAL PIPE DIAMETER (e.g., DN150mm). OD REFERS TO OUTSIDE DIAMETER FOR HDPE PIPE.
 - PROPOSED LOT BOUNDARIES ARE SUBJECT TO FINAL SURVEY. EXISTING LOT BOUNDARIES ARE SOURCED FROM LINZ DATA SERVICE AND USED IN ACCORDANCE WITH THE INTERNATIONAL CREATIVE COMMONS LICENCE 4.0.
 - ALL DIMENSIONS ARE IN METRES UNLESS STATED OTHERWISE.

- ### LEGEND
- DN150 WATER MAIN DN150 (OD180)
 - DN200 WATER MAIN DN200 (OD250)
 - DN375 WATER MAIN DN375 (OD450)
 - w — WATER SUBMAIN (OD63)
 - - - WATER LATERAL
 - FIRE HYDRANT
 - VALVE
 - WATER METER
 - STREET LIGHT
 - SW — SW — STORMWATER MAIN
 - - - STORMWATER LATERAL
 - STORMWATER MANHOLE
 - STORMWATER SUMP
 - SS — SS — WASTE WATER MAIN
 - - - WASTE WATER LATERAL
 - WASTE WATER MANHOLE

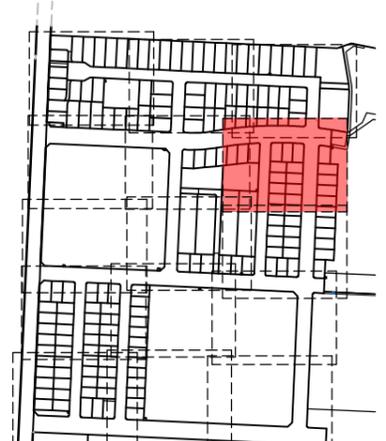

Rev#	Description	Drawn	Date
1	UPDATED INFORMATION ADDED	LB	24.09.25
0	FOR AS-BUILT	AMcC	04.09.25

INOVO
 Level 1, 93 Manchester St, Christchurch 8022
 Ph. 03 377 3290
 Level 1, Shed 19, Princess Wharf, Auckland 1010
 Ph. 09 600 1099
 www.inovo.nz

Scale A1
1:250
 Scale A3
1:500
 DO NOT SCALE FROM DRAWING

Client
EARLSBROOK
 LINCOLN

Project
EARLSBROOK
RESIDENTIAL SUBDIVISION
STAGE 1

Drawing Title
WATER SERVICE AS-BUILT
STAGE 1
SHEET 6

Status
AS-BUILT
SEPT 2025

Drawing No.
15721-S1-AB-6006

Rev
1





4000

NOTES

- AS-BUILT SERVICES DATA HAS BEEN CAPTURED BY GPS SURVEY PRIOR TO BACKFILLING & TRACING OF SERVICES FROM UAV IMAGERY CAPTURED DURING CONSTRUCTION BY MAUGERS CONTRACTING LTD.
- ALL BURIED SERVICES MUST BE POSITIVELY IDENTIFIED USING CABLE LOCATORS, GROUND PENETRATING RADAR EQUIPMENT OR POT-HOLING BY HYDRO-EXCAVATION BEFORE ANY HAND OR MECHANICAL EXCAVATIONS ARE UNDERTAKEN. THESE PLANS SHOULD NOT BE RELIED ON FOR LOCATION OF SERVICES OR SERVICE TYPE.
- NOT ALL BURIED SERVICES ARE SHOWN OR IDENTIFIED.
- DN REFERS TO NOMINAL INTERNAL PIPE DIAMETER (e.g., DN150mm). OD REFERS TO OUTSIDE DIAMETER FOR HDPE PIPE.
- PROPOSED LOT BOUNDARIES ARE SUBJECT TO FINAL SURVEY. EXISTING LOT BOUNDARIES ARE SOURCED FROM LINZ DATA SERVICE AND USED IN ACCORDANCE WITH THE INTERNATIONAL CREATIVE COMMONS LICENCE 4.0.
- ALL DIMENSIONS ARE IN METRES UNLESS STATED OTHERWISE.

LEGEND

- WATER MAIN DN150 (OD180)
- WATER MAIN DN200 (OD250)
- WATER MAIN DN375 (OD450)
- WATER SUBMAIN (OD63)
- WATER LATERAL
- FIRE HYDRANT
- VALVE
- WATER METER
- STREET LIGHT
- STORMWATER MAIN
- STORMWATER LATERAL
- STORMWATER MANHOLE
- STORMWATER SUMP
- WASTE WATER MAIN
- WASTE WATER LATERAL
- WASTE WATER MANHOLE

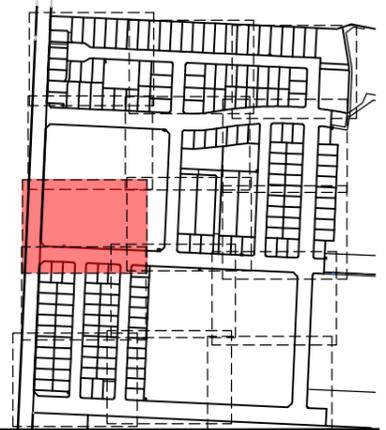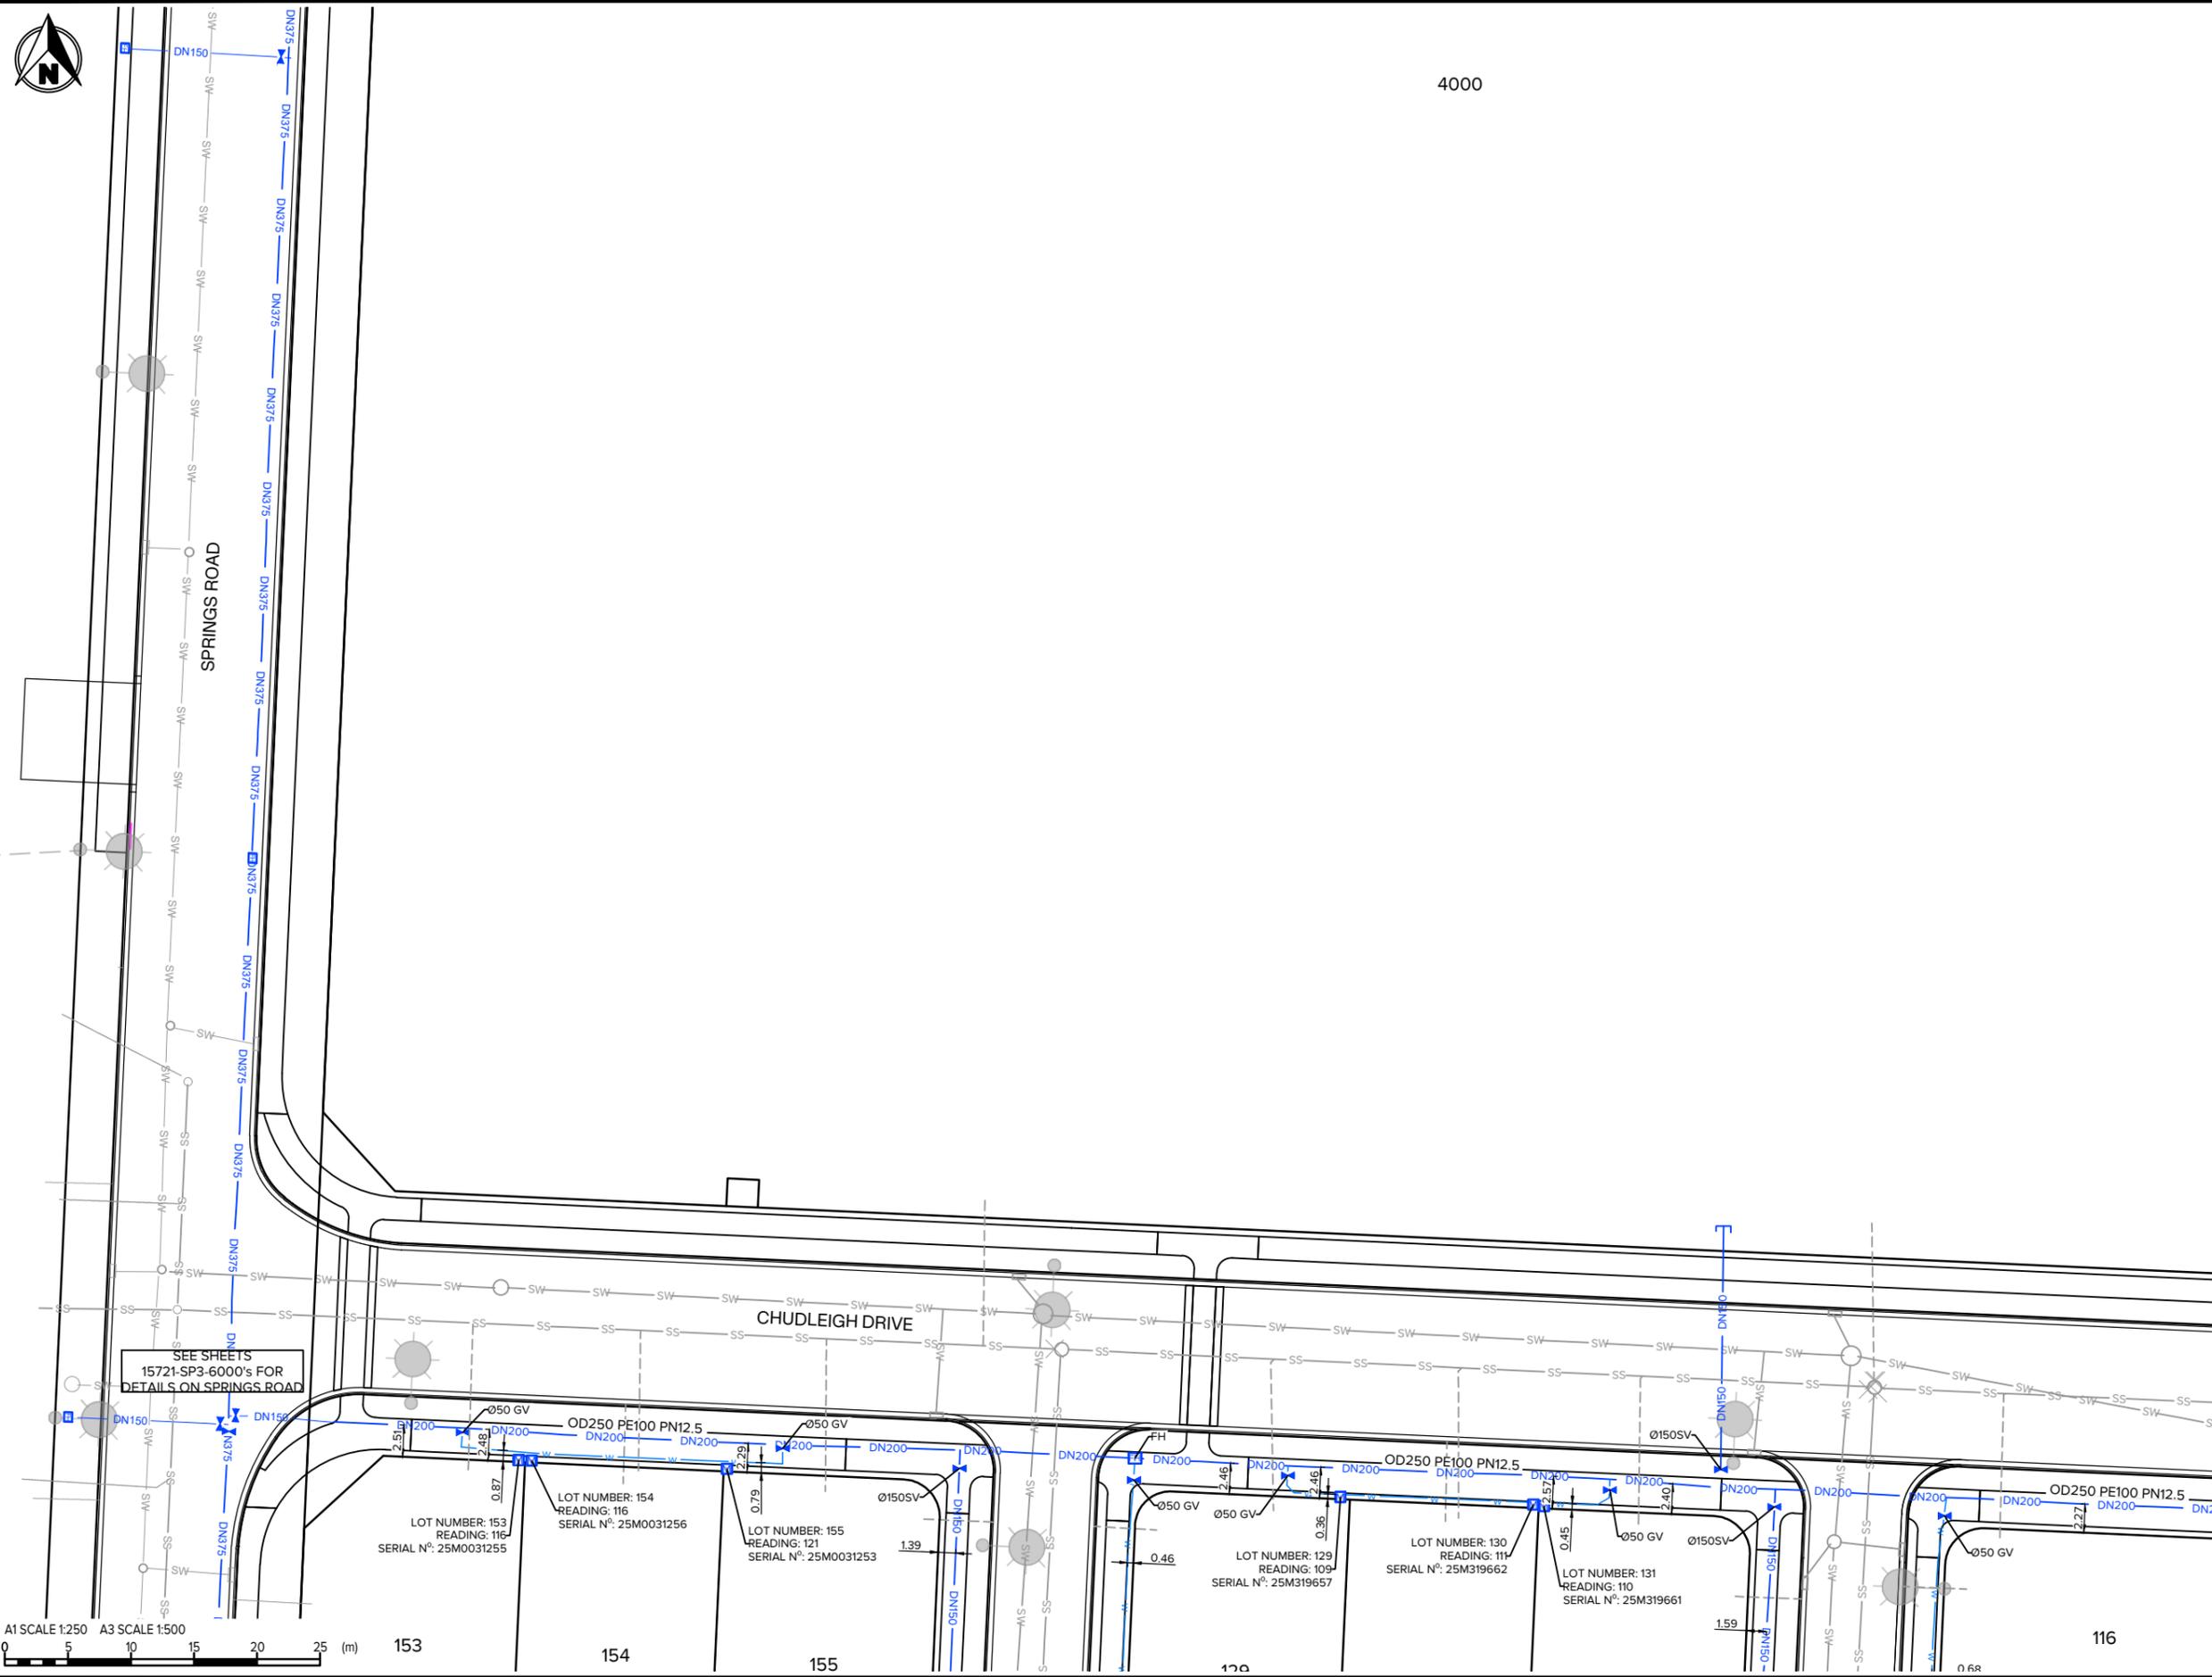

A1 SCALE 1:250 A3 SCALE 1:500
 0 5 10 15 20 25 (m)

Rev#	Description	Drawn	Date
1	UPDATED INFORMATION ADDED	LB	24.09.25
0	FOR AS-BUILT	AMcC	04.09.25

INOVO
 Level 1, 93 Manchester St, Christchurch 8022
 Ph. 03 377 3290
 Level 1, Shed 19, Princess Wharf, Auckland 1010
 Ph. 09 600 1099
 www.inovo.nz

Scale A1 1:250
 Scale A3 1:500
 DO NOT SCALE FROM DRAWING

Drawn AMcC
 Approved TMcL
 Date 04.09.25


Client **EARLSBROOK LINCOLN**

Project **EARLSBROOK RESIDENTIAL SUBDIVISION STAGE 1**

Drawing Title **WATER SERVICE AS-BUILT STAGE 1 SHEET 7**

Status **AS-BUILT SEPT 2025**

Drawing No. **15721-S1-AB-6007** Rev 1

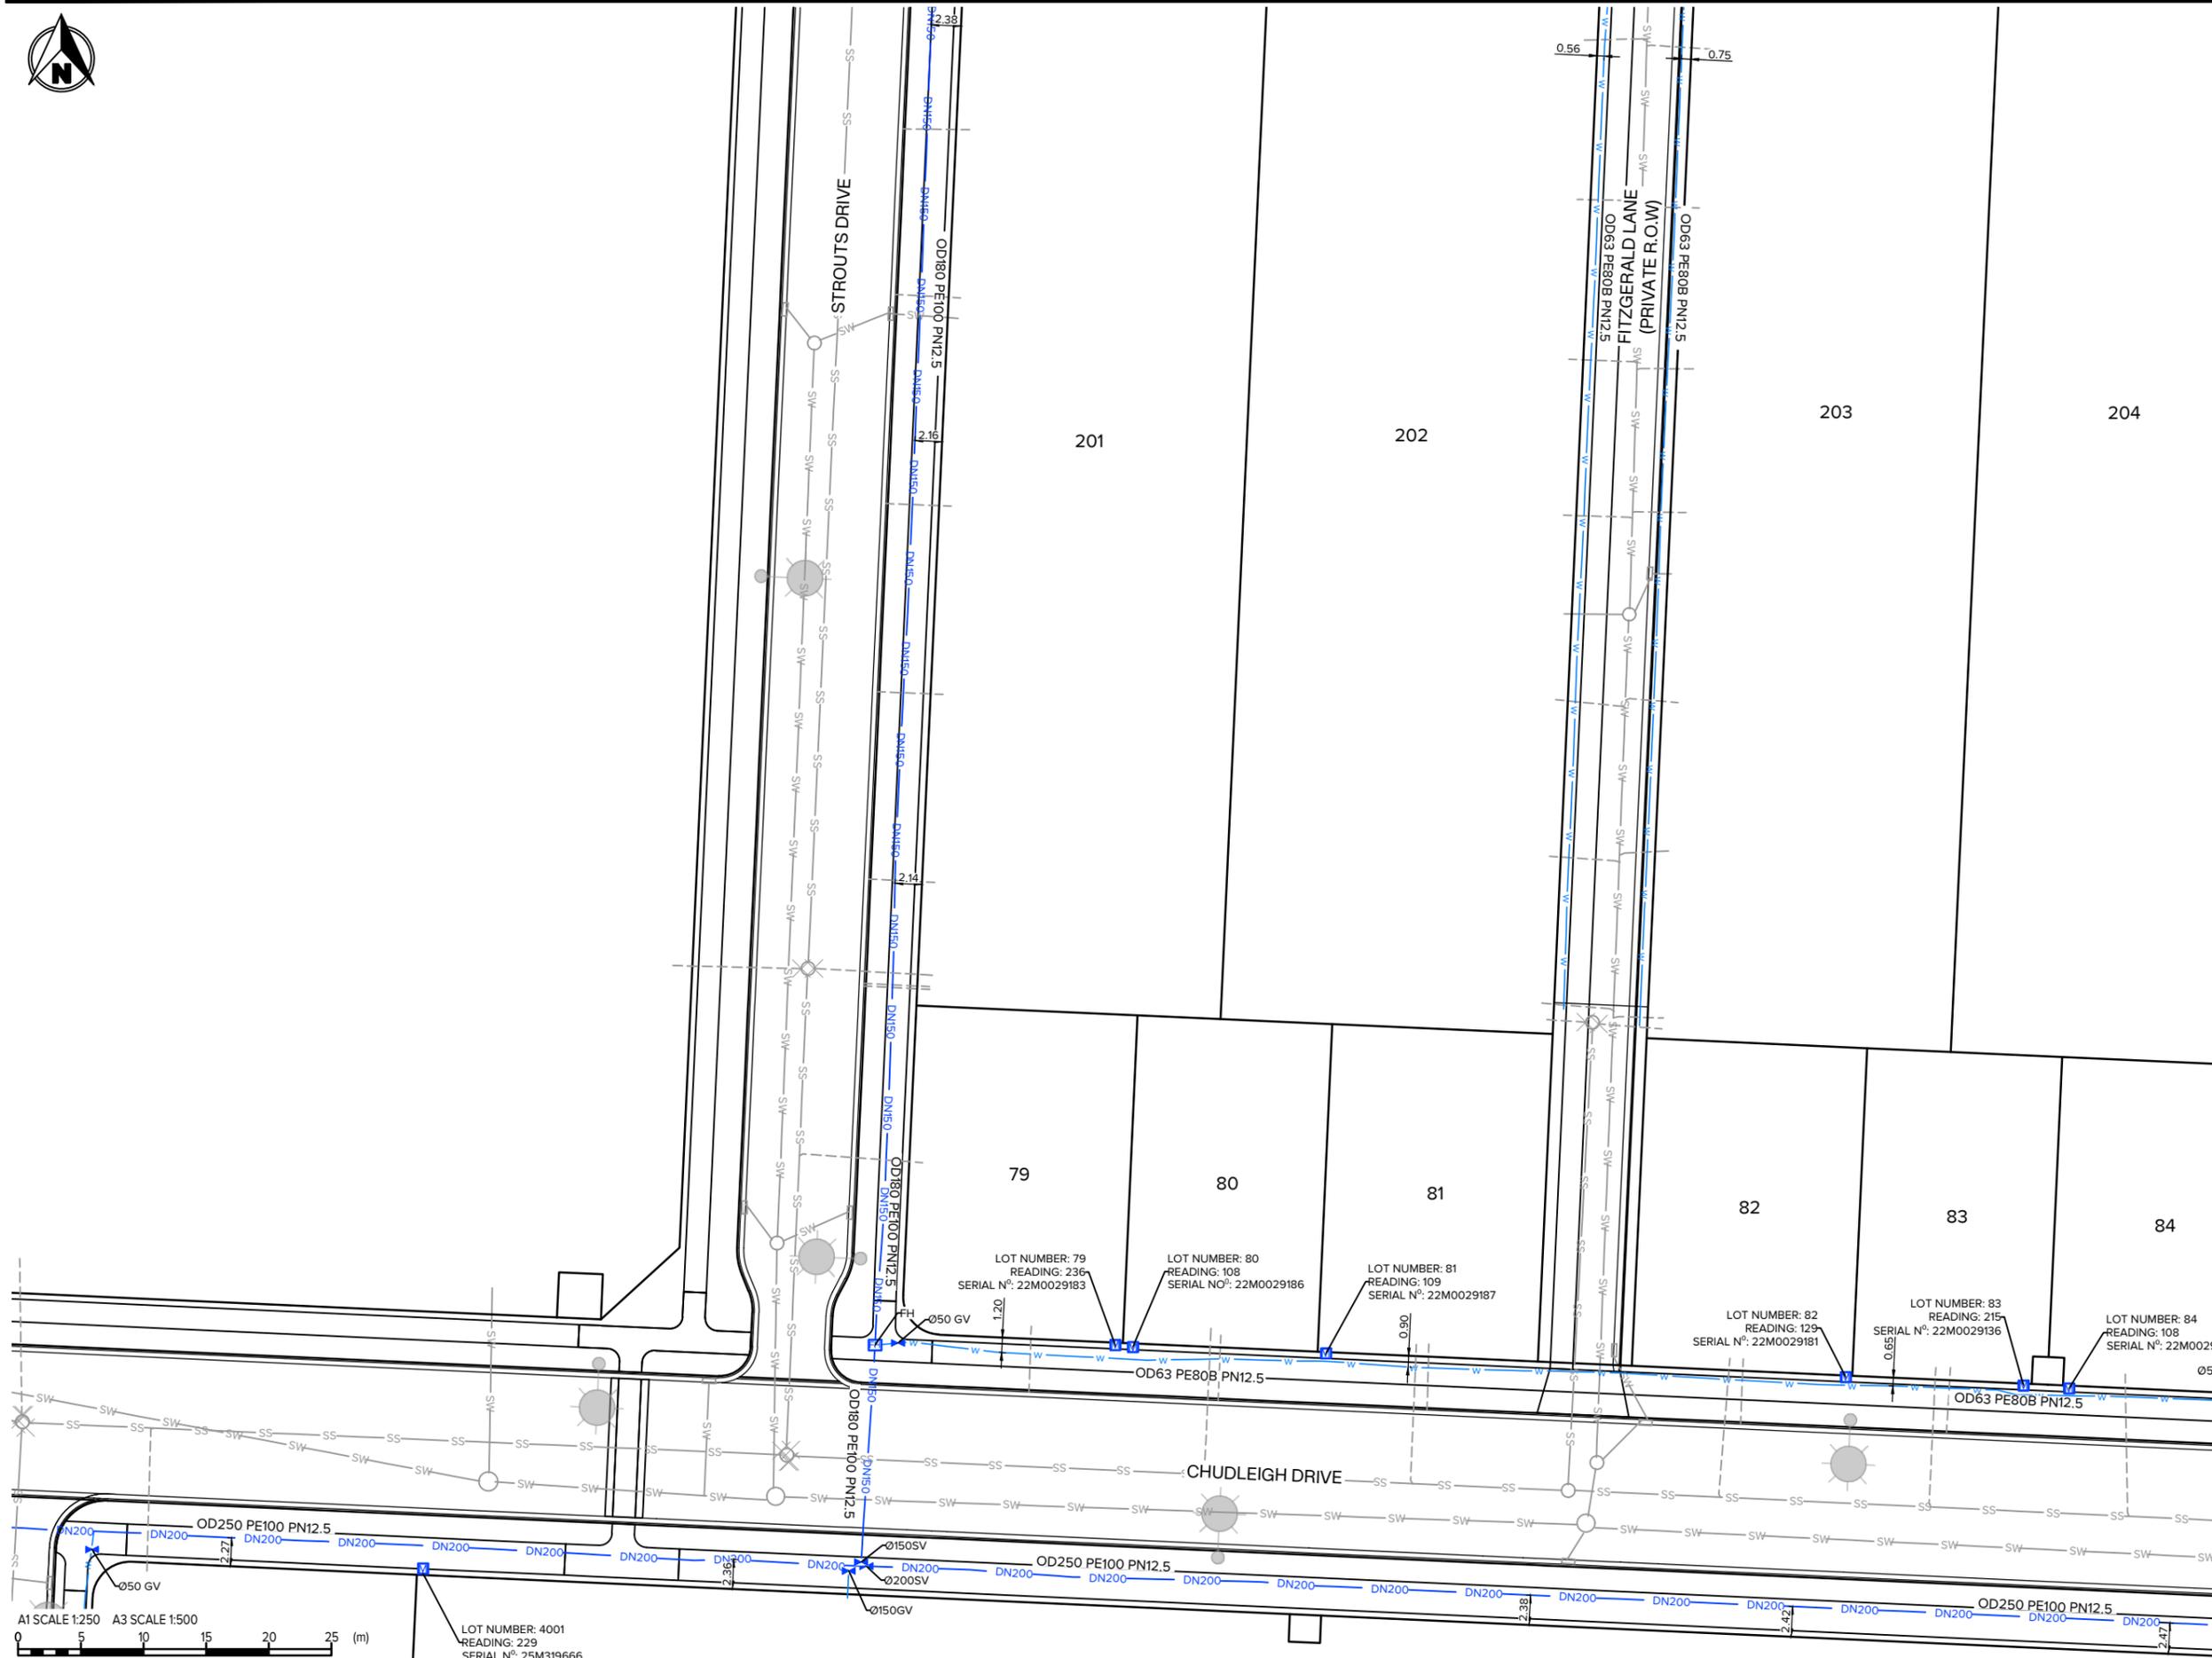

- ### NOTES
- AS-BUILT SERVICES DATA HAS BEEN CAPTURED BY GPS SURVEY PRIOR TO BACKFILLING & TRACING OF SERVICES FROM UAV IMAGERY CAPTURED DURING CONSTRUCTION BY MAUGERS CONTRACTING LTD.
 - ALL BURIED SERVICES MUST BE POSITIVELY IDENTIFIED USING CABLE LOCATORS, GROUND PENETRATING RADAR EQUIPMENT OR POT-HOLING BY HYDRO-EXCAVATION BEFORE ANY HAND OR MECHANICAL EXCAVATIONS ARE UNDERTAKEN. THESE PLANS SHOULD NOT BE RELIED ON FOR LOCATION OF SERVICES OR SERVICE TYPE.
 - NOT ALL BURIED SERVICES ARE SHOWN OR IDENTIFIED.
 - DN REFERS TO NOMINAL INTERNAL PIPE DIAMETER (e.g., DN150mm). OD REFERS TO OUTSIDE DIAMETER FOR HDPE PIPE.
 - PROPOSED LOT BOUNDARIES ARE SUBJECT TO FINAL SURVEY. EXISTING LOT BOUNDARIES ARE SOURCED FROM LINZ DATA SERVICE AND USED IN ACCORDANCE WITH THE INTERNATIONAL CREATIVE COMMONS LICENCE 4.0.
 - ALL DIMENSIONS ARE IN METRES UNLESS STATED OTHERWISE.

- ### LEGEND
- DN150 WATER MAIN DN150 (OD180)
 - DN200 WATER MAIN DN200 (OD250)
 - DN375 WATER MAIN DN375 (OD450)
 - w- WATER SUBMAIN (OD63)
 - l- WATER LATERAL
 - FIRE HYDRANT
 - VALVE
 - WATER METER
 - STREET LIGHT
 - SW— STORMWATER MAIN
 - l- STORMWATER LATERAL
 - STORMWATER MANHOLE
 - STORMWATER SUMP
 - SS- WASTE WATER MAIN
 - l- WASTE WATER LATERAL
 - WASTE WATER MANHOLE



LOT NUMBER: 4001
READING: 229
SERIAL N°: 25M319666



Rev#	Description	Drawn	Date
1	UPDATED INFORMATION ADDED	LB	24.09.25
0	FOR AS-BUILT	AMcC	04.09.25

INOVO
Level 1, 93 Manchester St, Christchurch 8022
Ph. 03 377 3290
Level 1, Shed 19, Princess Wharf, Auckland 1010
Ph. 09 600 1099
www.inovo.nz

Scale A1
1:250
Scale A3
1:500
DO NOT SCALE FROM DRAWING

Drawn
AMcC
Approved
TMcL
Date
04.09.25

Client
EARLSBROOK
LINCOLN

Project
EARLSBROOK
RESIDENTIAL SUBDIVISION
STAGE 1


Drawing Title
WATER SERVICE AS-BUILT
STAGE 1
SHEET 8

Status
AS-BUILT
SEPT 2025




203

204

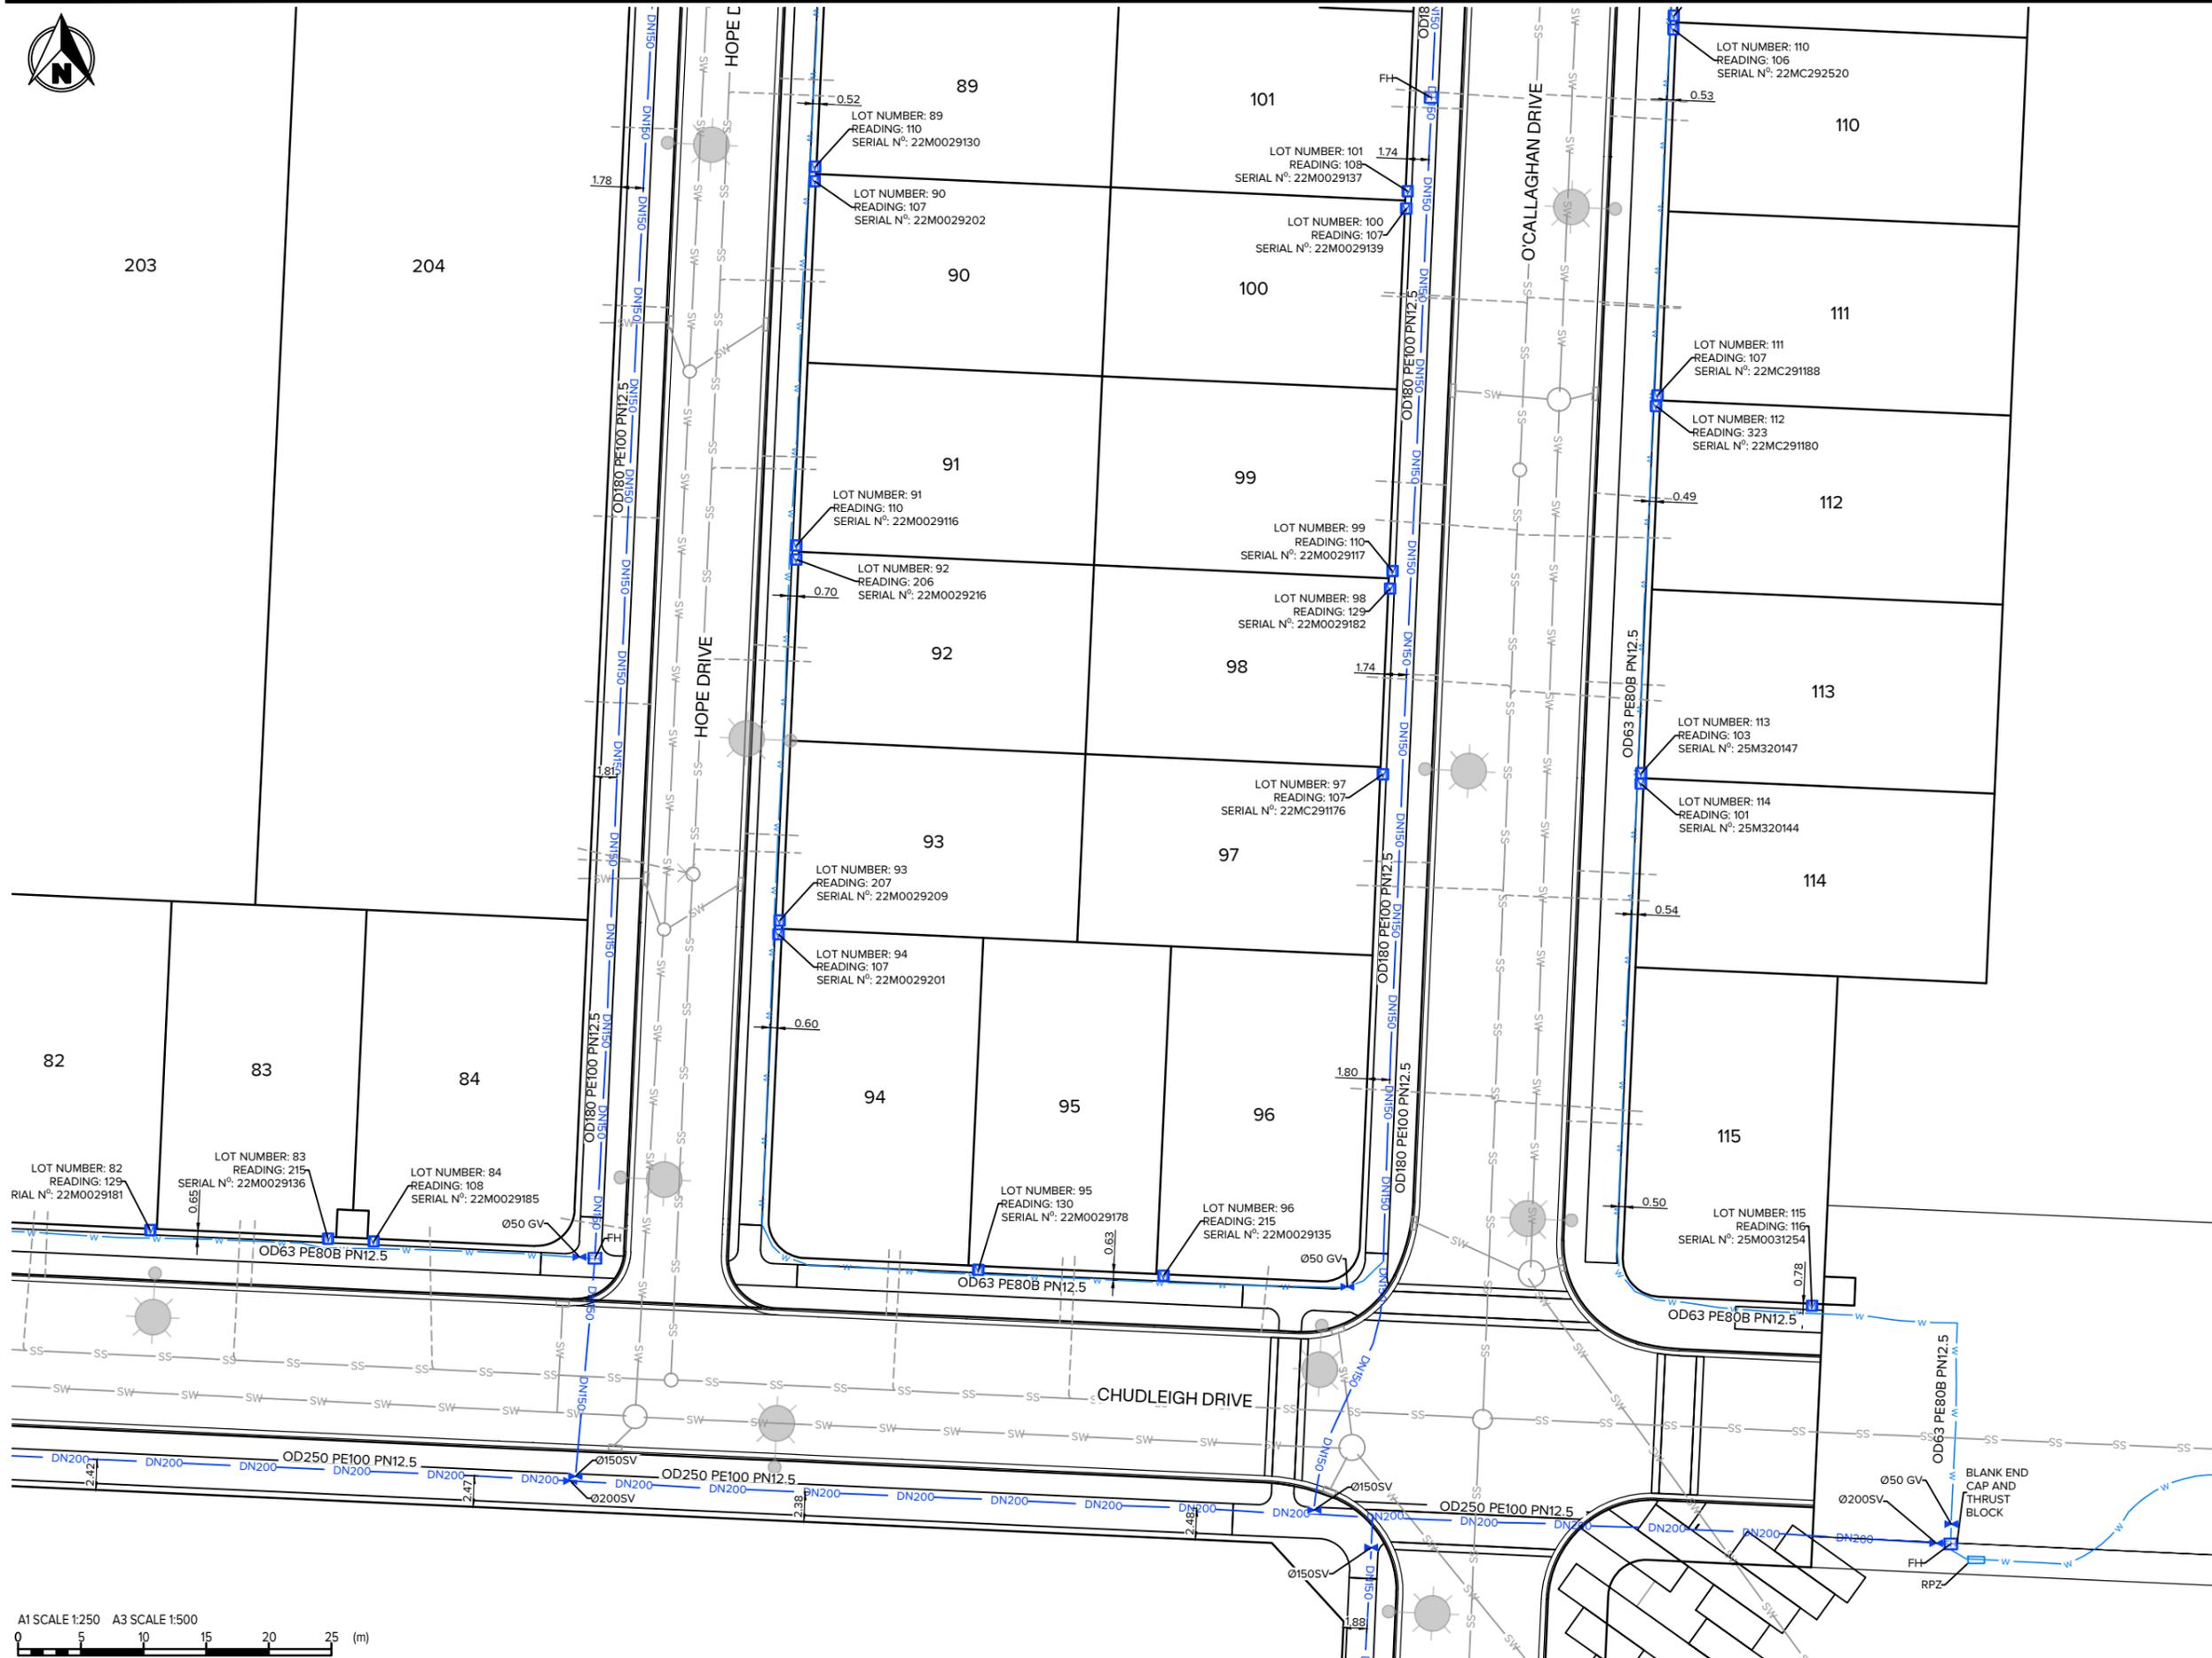

- ### NOTES
- AS-BUILT SERVICES DATA HAS BEEN CAPTURED BY GPS SURVEY PRIOR TO BACKFILLING & TRACING OF SERVICES FROM UAV IMAGERY CAPTURED DURING CONSTRUCTION BY MAUGERS CONTRACTING LTD.
 - ALL BURIED SERVICES MUST BE POSITIVELY IDENTIFIED USING CABLE LOCATORS, GROUND PENETRATING RADAR EQUIPMENT OR POT-HOLING BY HYDRO-EXCAVATION BEFORE ANY HAND OR MECHANICAL EXCAVATIONS ARE UNDERTAKEN. THESE PLANS SHOULD NOT BE RELIED ON FOR LOCATION OF SERVICES OR SERVICE TYPE.
 - NOT ALL BURIED SERVICES ARE SHOWN OR IDENTIFIED.
 - DN REFERS TO NOMINAL INTERNAL PIPE DIAMETER (e.g., DN150mm). OD REFERS TO OUTSIDE DIAMETER FOR HDPE PIPE.
 - PROPOSED LOT BOUNDARIES ARE SUBJECT TO FINAL SURVEY. EXISTING LOT BOUNDARIES ARE SOURCED FROM LINZ DATA SERVICE AND USED IN ACCORDANCE WITH THE INTERNATIONAL CREATIVE COMMONS LICENCE 4.0.
 - ALL DIMENSIONS ARE IN METRES UNLESS STATED OTHERWISE.

- ### LEGEND
- DN150 WATER MAIN DN150 (OD180)
 - DN200 WATER MAIN DN200 (OD250)
 - DN375 WATER MAIN DN357 (OD450)
 - w-w WATER SUBMAIN (OD63)
 - WATER LATERAL
 - FH FIRE HYDRANT
 - ∩ VALVE
 - M WATER METER
 - ★ STREET LIGHT
 - SW— SW STORMWATER MAIN
 - STORMWATER LATERAL
 - STORMWATER MANHOLE
 - ◇ STORMWATER SUMP
 - SS— SS WASTE WATER MAIN
 - WASTE WATER LATERAL
 - WASTE WATER MANHOLE

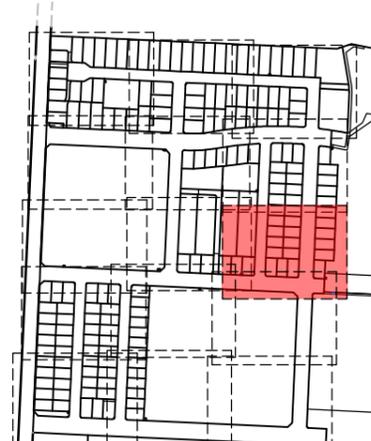

Rev#	Description	Drawn	Date
1	UPDATED INFORMATION ADDED	LB	24.09.25
0	FOR AS-BUILT	AMcC	04.09.25



Level 1, 93 Manchester St, Christchurch 8022
 Ph. 03 377 3290
 Level 1, Shed 19, Princess Wharf, Auckland 1010
 Ph. 09 600 1099
 www.inovo.nz

Scale A1
1:250
Scale A3
1:500
DO NOT SCALE FROM DRAWING

Drawn
AMcC
Approved
TMcL
Date
04.09.25




Project
**EARLSBROOK
RESIDENTIAL SUBDIVISION
STAGE 1**

Drawing Title
**WATER SERVICE AS-BUILT
STAGE 1
SHEET 9**

Status
**AS-BUILT
SEPT 2025**

Drawing No.
15721-S1-AB-6009

Rev
1

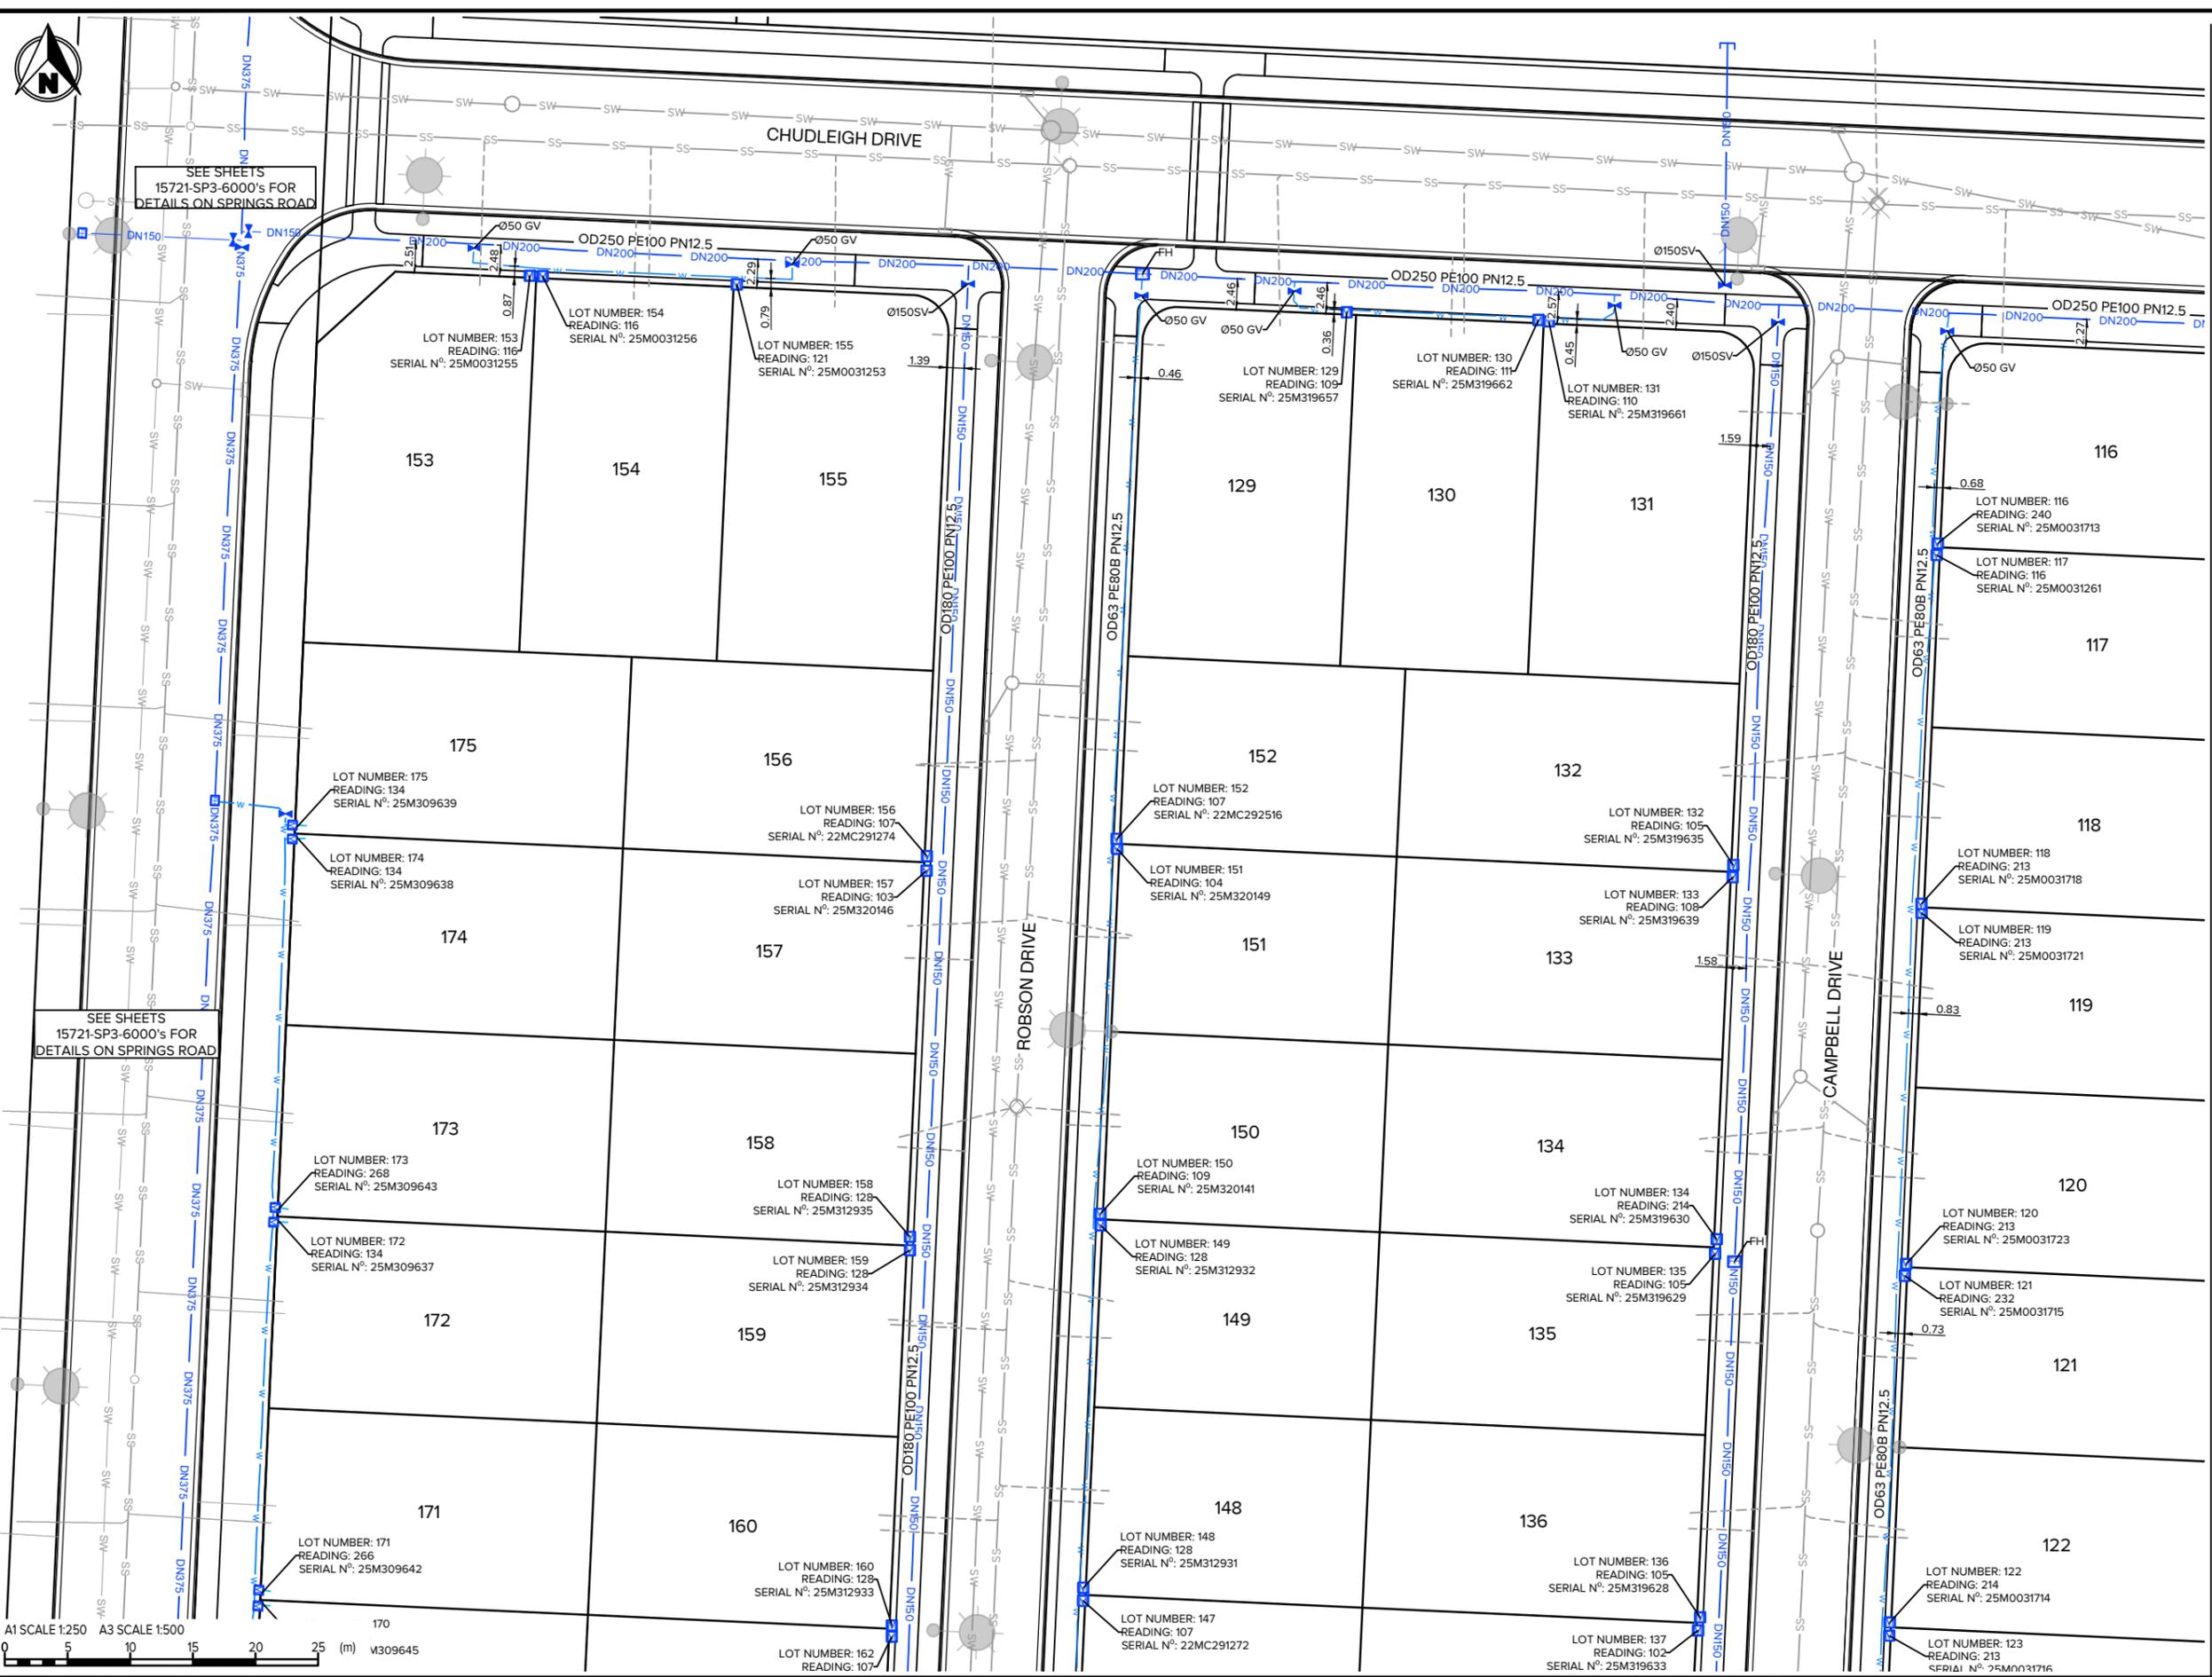

- ### NOTES
- AS-BUILT SERVICES DATA HAS BEEN CAPTURED BY GPS SURVEY PRIOR TO BACKFILLING & TRACING OF SERVICES FROM UAV IMAGERY CAPTURED DURING CONSTRUCTION BY MAUGERS CONTRACTING LTD.
 - ALL BURIED SERVICES MUST BE POSITIVELY IDENTIFIED USING CABLE LOCATORS, GROUND PENETRATING RADAR EQUIPMENT OR POT-HOLING BY HYDRO-EXCAVATION BEFORE ANY HAND OR MECHANICAL EXCAVATIONS ARE UNDERTAKEN. THESE PLANS SHOULD NOT BE RELIED ON FOR LOCATION OF SERVICES OR SERVICE TYPE.
 - NOT ALL BURIED SERVICES ARE SHOWN OR IDENTIFIED.
 - DN REFERS TO NOMINAL INTERNAL PIPE DIAMETER (e.g., DN150mm). OD REFERS TO OUTSIDE DIAMETER FOR HDPE PIPE.
 - PROPOSED LOT BOUNDARIES ARE SUBJECT TO FINAL SURVEY. EXISTING LOT BOUNDARIES ARE SOURCED FROM LINZ DATA SERVICE AND USED IN ACCORDANCE WITH THE INTERNATIONAL CREATIVE COMMONS LICENCE 4.0.
 - ALL DIMENSIONS ARE IN METRES UNLESS STATED OTHERWISE.

- ### LEGEND
- DN150 WATER MAIN DN150 (OD180)
 - DN200 WATER MAIN DN200 (OD250)
 - DN375 WATER MAIN DN375 (OD450)
 - w w WATER SUBMAIN (OD63)
 - WATER LATERAL
 - FH FIRE HYDRANT
 - ∇ VALVE
 - M WATER METER
 - ★ STREET LIGHT
 - SW SW STORMWATER MAIN
 - STORMWATER LATERAL
 - STORMWATER MANHOLE
 - ◇ STORMWATER SUMP
 - SS SS WASTE WATER MAIN
 - WASTE WATER LATERAL
 - WASTE WATER MANHOLE



A1 SCALE 1:250 A3 SCALE 1:500
 0 5 10 15 20 25 (m) M309645

Rev#	Description	Drawn	Date
1	UPDATED INFORMATION ADDED	LB	24.09.25
0	FOR AS-BUILT	AMcC	04.09.25

INOVO
 Level 1, 93 Manchester St, Christchurch 8022
 Ph. 03 377 3290
 Level 1, Shed 19, Princess Wharf, Auckland 1010
 Ph. 09 600 1099
 www.inovo.nz

Scale A1 1:250
 Scale A3 1:500
 DO NOT SCALE FROM DRAWING

Drawn AMcC
 Approved TMCL
 Date 04.09.25


Client **EARLSBROOK LINCOLN**

Project **EARLSBROOK RESIDENTIAL SUBDIVISION STAGE 1**

Drawing Title **WATER SERVICE AS-BUILT STAGE 1 SHEET 10**

Status **AS-BUILT SEPT 2025**

Drawing No. **15721-S1-AB-6010** Rev 1

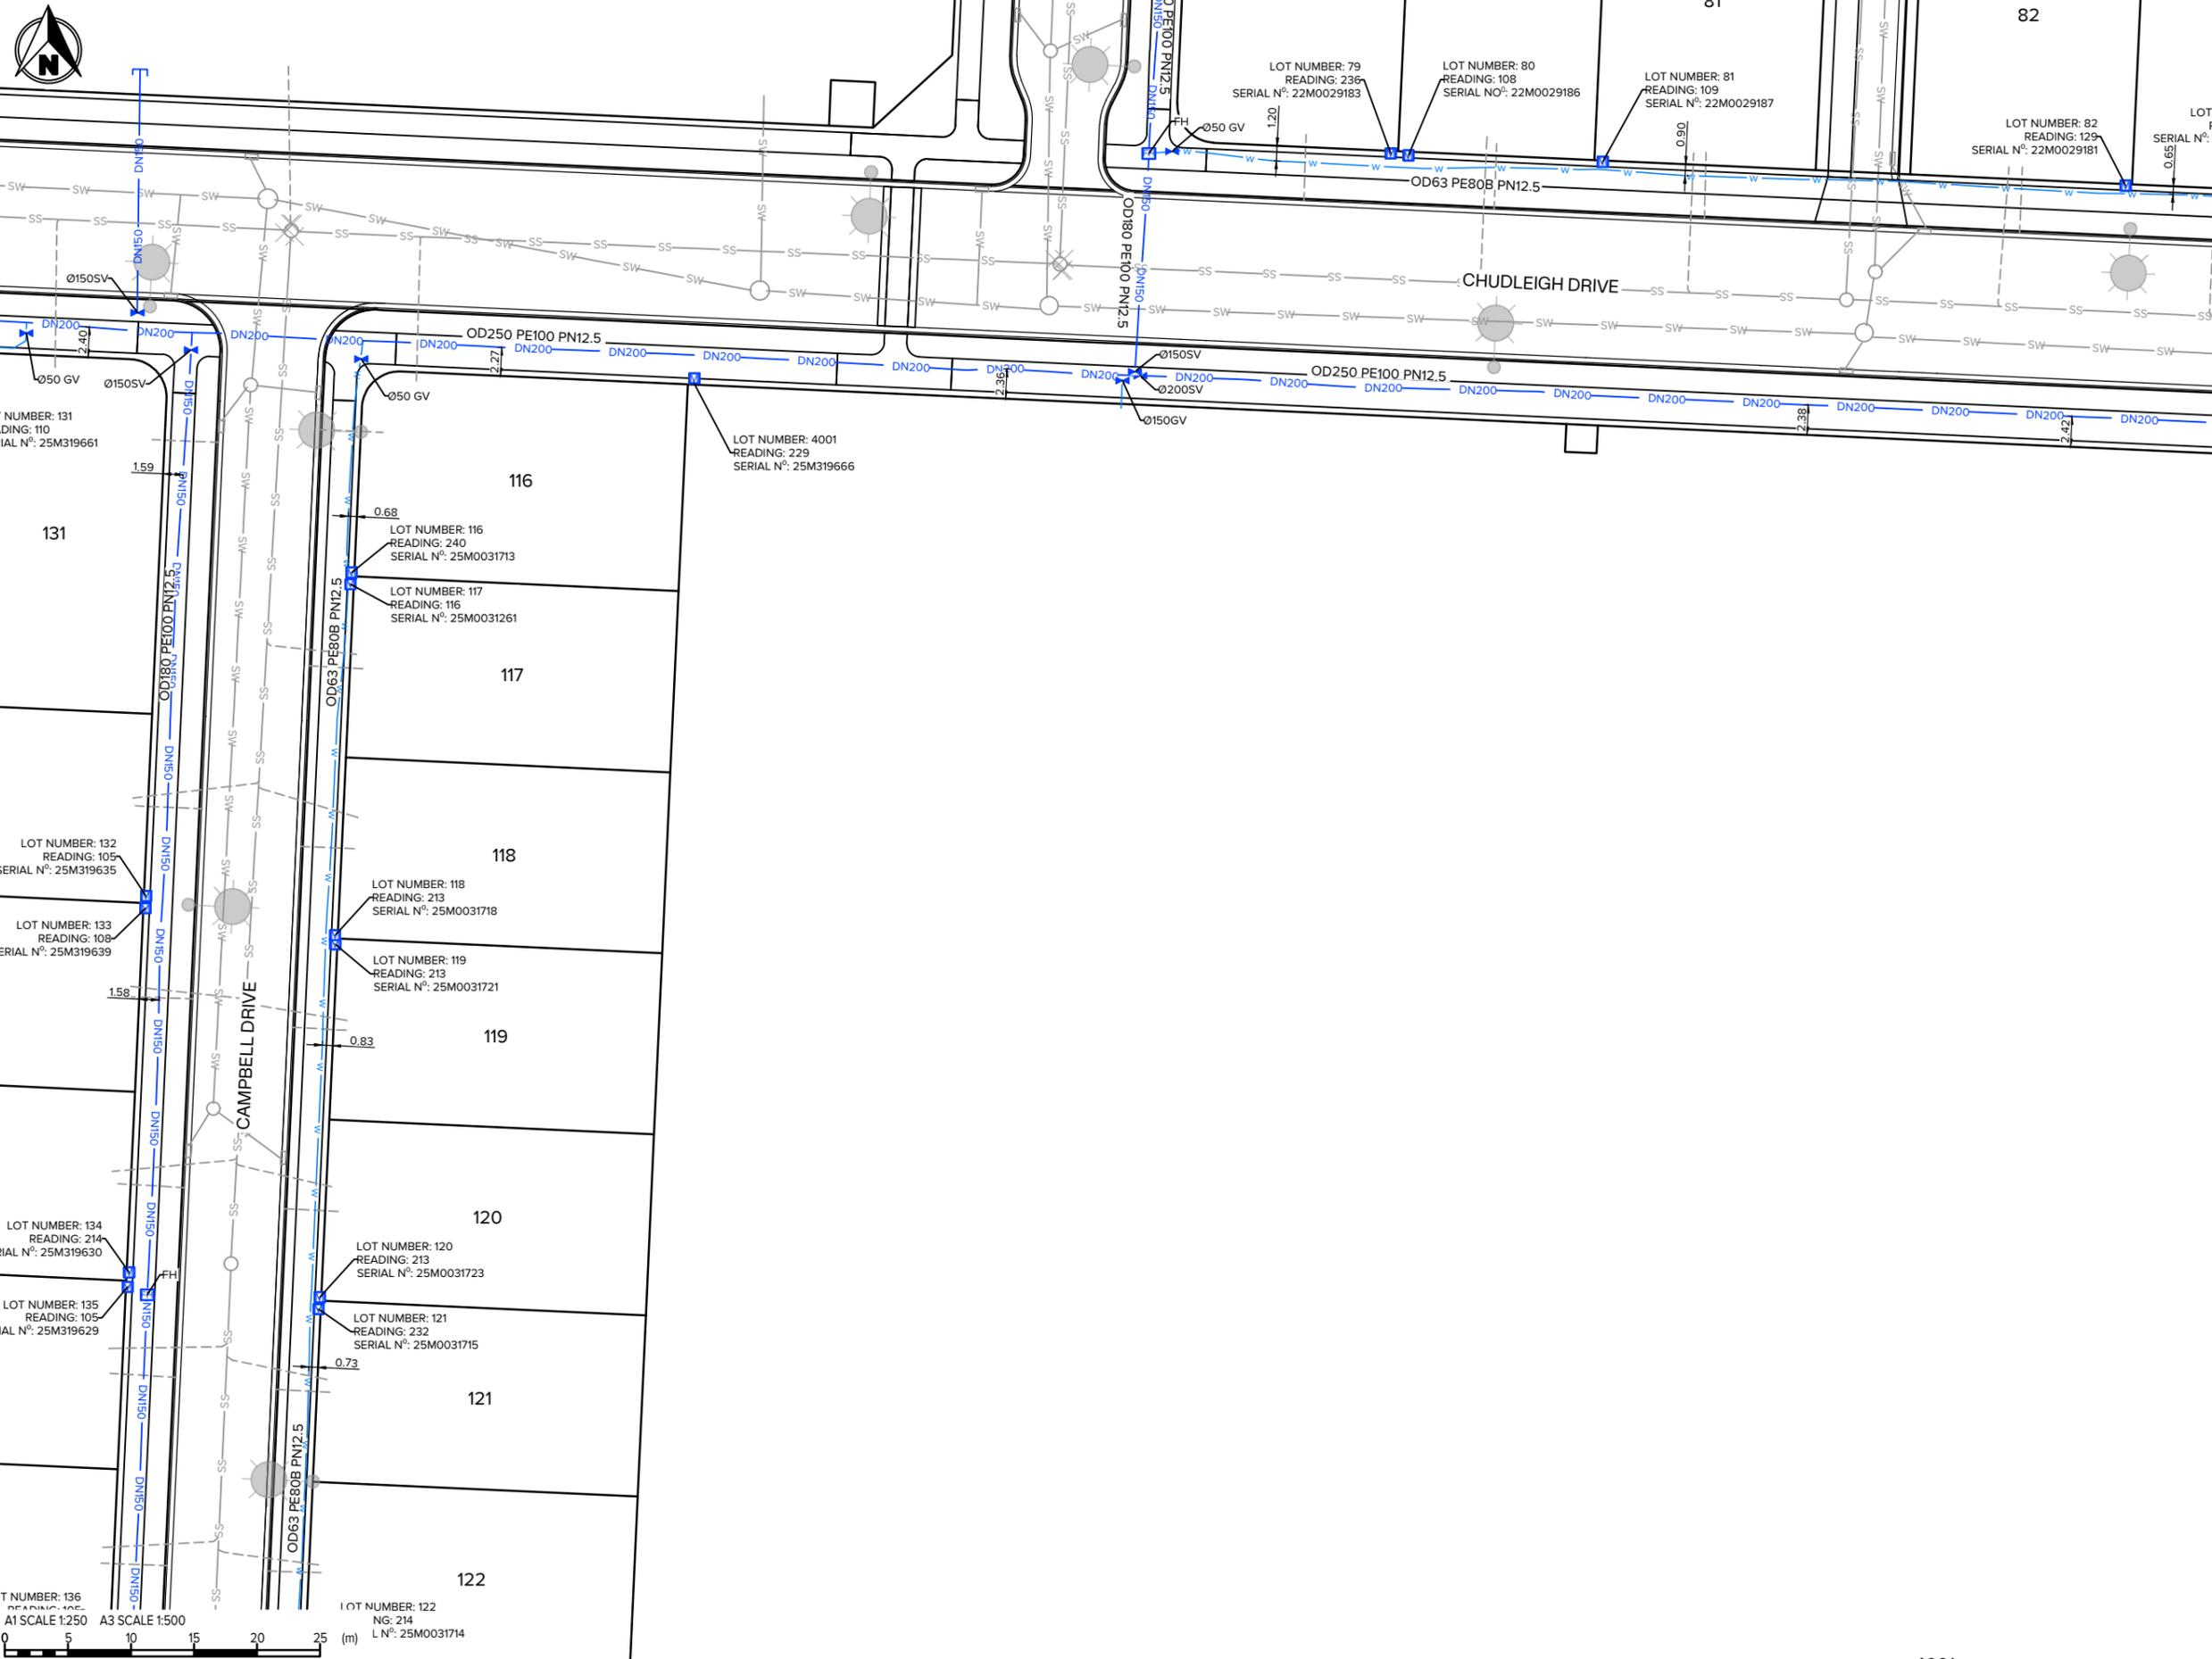

- ### NOTES
- AS-BUILT SERVICES DATA HAS BEEN CAPTURED BY GPS SURVEY PRIOR TO BACKFILLING & TRACING OF SERVICES FROM UAV IMAGERY CAPTURED DURING CONSTRUCTION BY MAUGERS CONTRACTING LTD.
 - ALL BURIED SERVICES MUST BE POSITIVELY IDENTIFIED USING CABLE LOCATORS, GROUND PENETRATING RADAR EQUIPMENT OR POT-HOLING BY HYDRO-EXCAVATION BEFORE ANY HAND OR MECHANICAL EXCAVATIONS ARE UNDERTAKEN. THESE PLANS SHOULD NOT BE RELIED ON FOR LOCATION OF SERVICES OR SERVICE TYPE.
 - NOT ALL BURIED SERVICES ARE SHOWN OR IDENTIFIED.
 - DN REFERS TO NOMINAL INTERNAL PIPE DIAMETER (e.g., DN150mm). OD REFERS TO OUTSIDE DIAMETER FOR HDPE PIPE.
 - PROPOSED LOT BOUNDARIES ARE SUBJECT TO FINAL SURVEY. EXISTING LOT BOUNDARIES ARE SOURCED FROM LINZ DATA SERVICE AND USED IN ACCORDANCE WITH THE INTERNATIONAL CREATIVE COMMONS LICENCE 4.0.
 - ALL DIMENSIONS ARE IN METRES UNLESS STATED OTHERWISE.

- ### LEGEND
- DN150 WATER MAIN DN150 (OD180)
 - DN200 WATER MAIN DN200 (OD250)
 - DN375 WATER MAIN DN357 (OD450)
 - w- WATER SUBMAIN (OD63)
 - L- WATER LATERAL
 - FIRE HYDRANT
 - VALVE
 - WATER METER
 - STREET LIGHT
 - SW- STORMWATER MAIN
 - L- STORMWATER LATERAL
 - STORMWATER MANHOLE
 - STORMWATER SUMP
 - SS- WASTE WATER MAIN
 - L- WASTE WATER LATERAL
 - WASTE WATER MANHOLE



LOT NUMBER: 136
READING: 105
SERIAL N°: 25M319629
A1 SCALE 1:250
A3 SCALE 1:500

LOT NUMBER: 122
READING: 214
SERIAL N°: 25M0031714

Rev#	Description	Drawn	Date
1	UPDATED INFORMATION ADDED	LB	24.09.25
0	FOR AS-BUILT	AMC	04.09.25



Level 1, 93 Manchester St, Christchurch 8022
Ph. 03 377 3290
Level 1, Shed 19, Princess Wharf, Auckland 1010
Ph. 09 600 1099
www.inovo.nz

Scale A1
1:250
Scale A3
1:500
DO NOT SCALE FROM DRAWING

Drawn
AMC
Approved
TMCL
Date
04.09.25




Project
**EARLSBROOK
RESIDENTIAL SUBDIVISION
STAGE 1**

Drawing Title
**WATER SERVICE AS-BUILT
STAGE 1
SHEET 11**

Status
**AS-BUILT
SEPT 2025**


Drawing No.
15721-S1-AB-6011

Rev
1

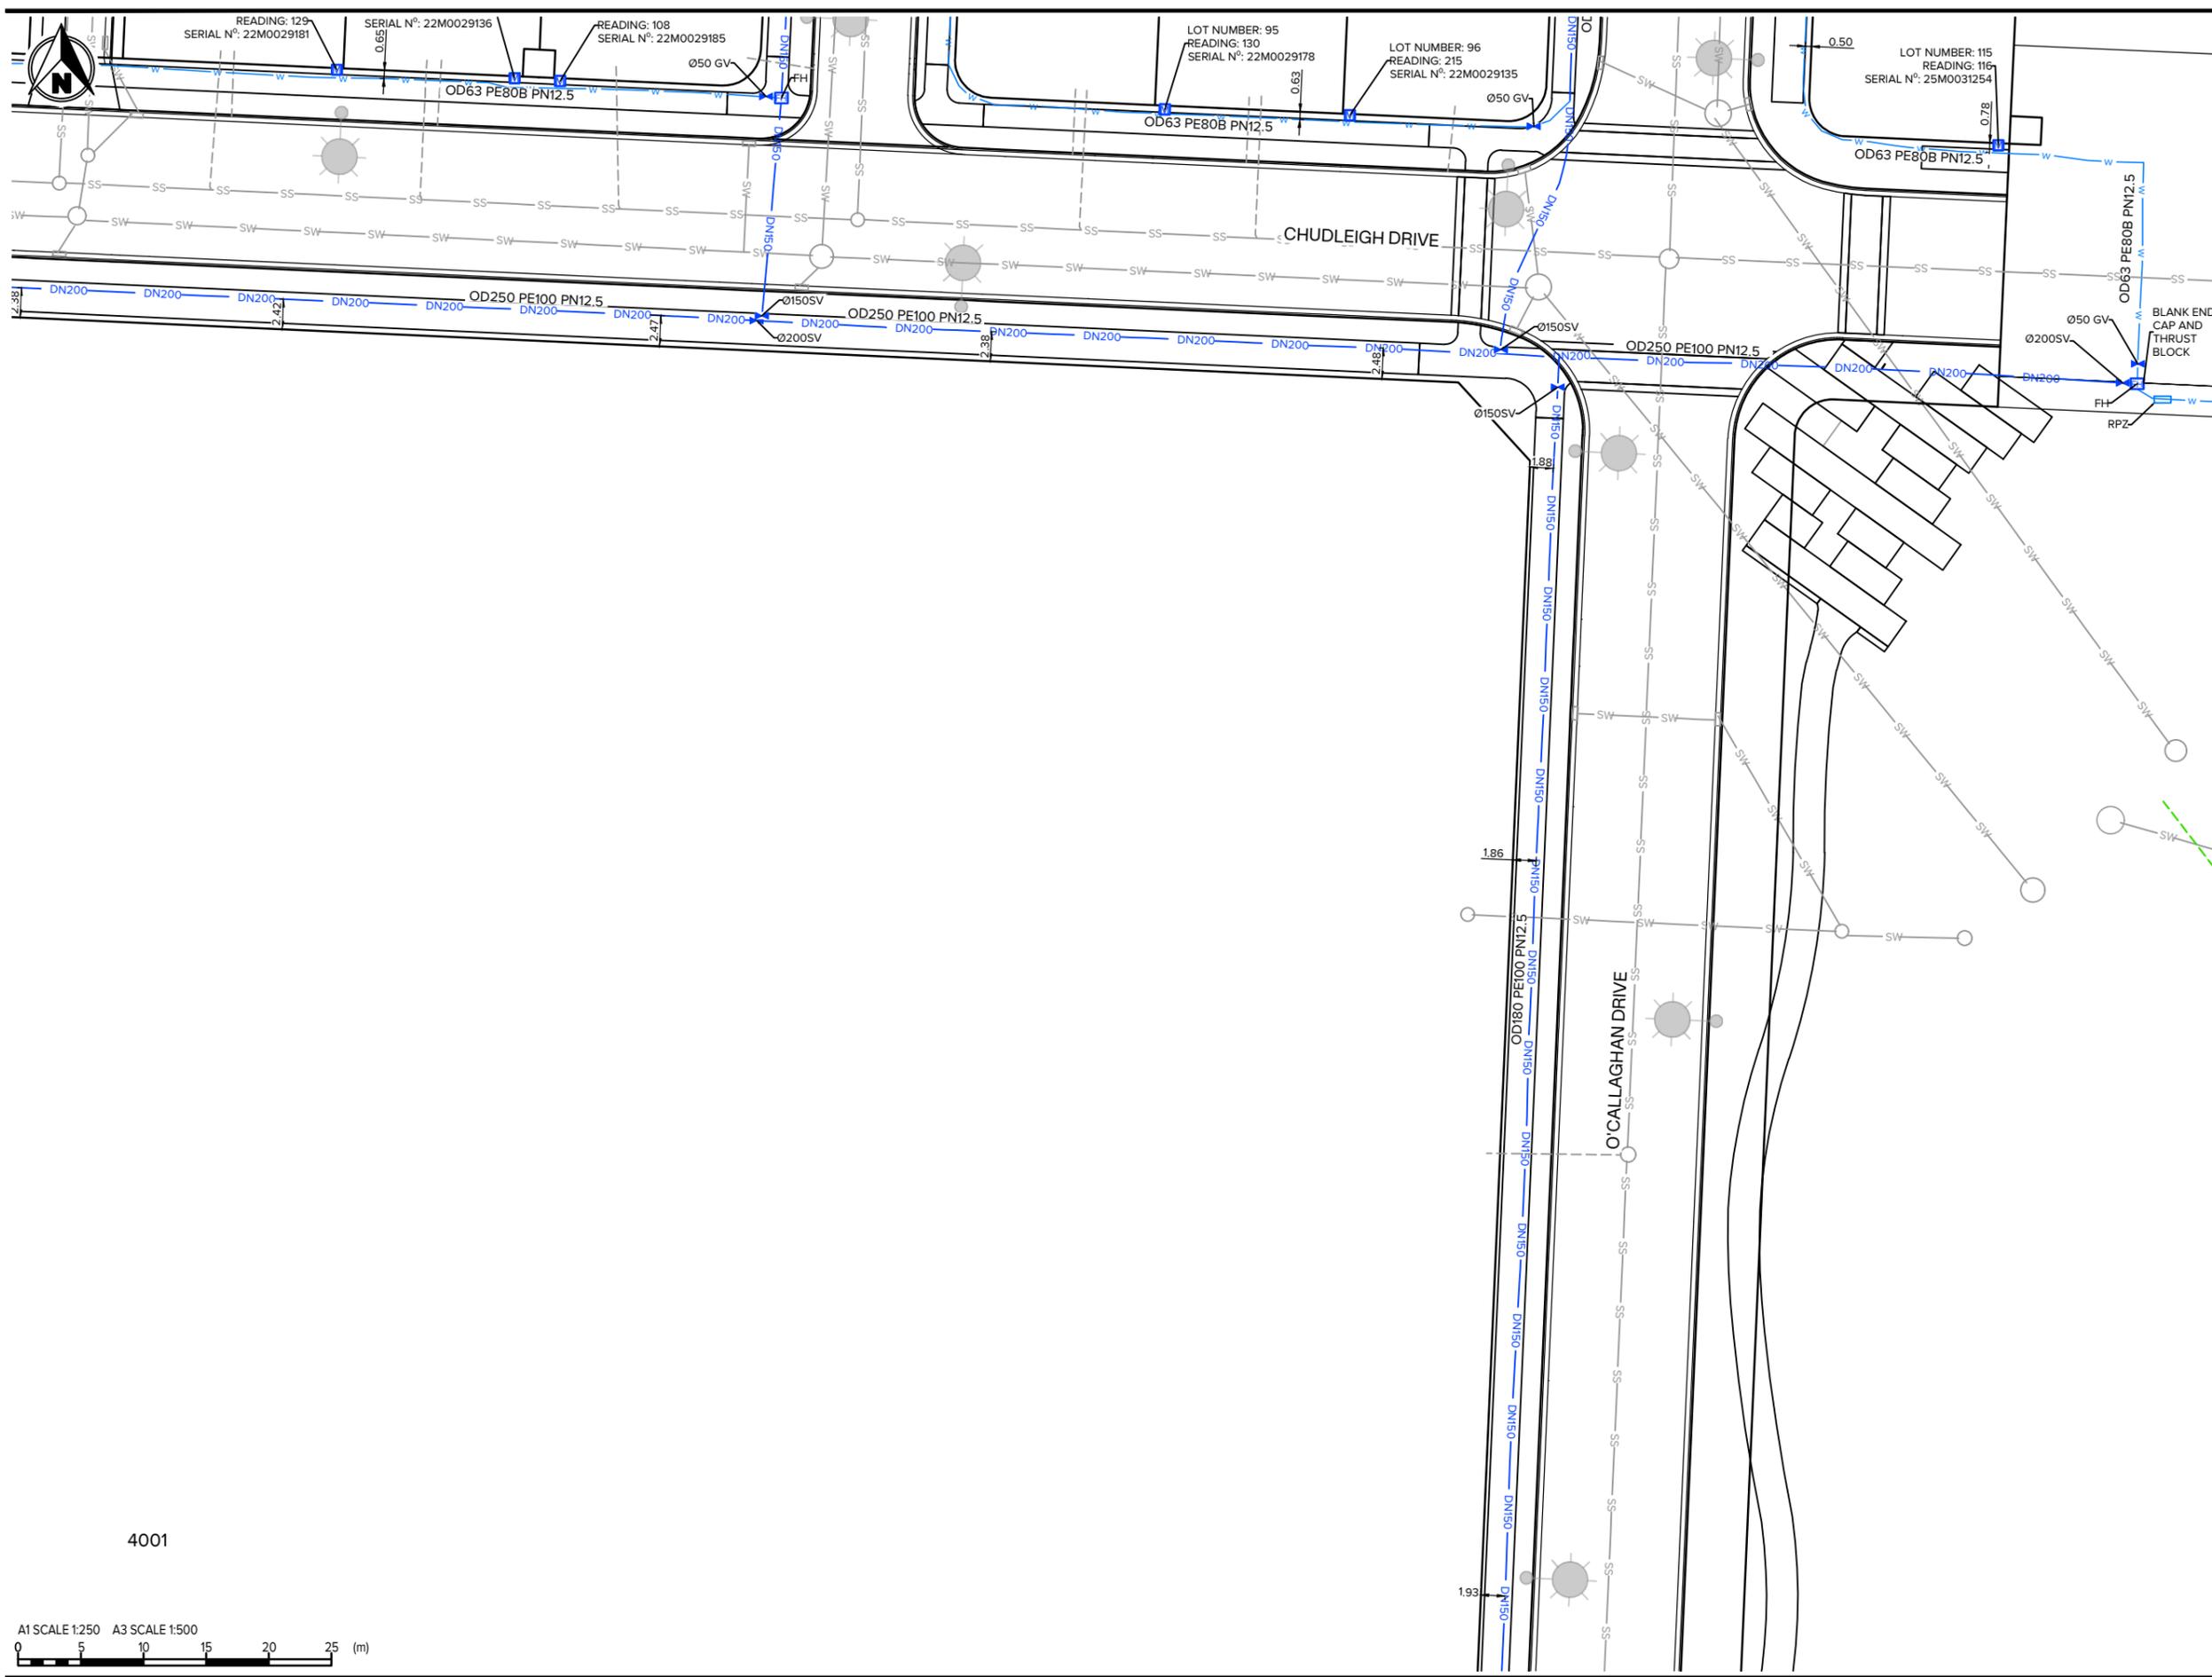

- NOTES**
- AS-BUILT SERVICES DATA HAS BEEN CAPTURED BY GPS SURVEY PRIOR TO BACKFILLING & TRACING OF SERVICES FROM UAV IMAGERY CAPTURED DURING CONSTRUCTION BY MAUGERS CONTRACTING LTD.
 - ALL BURIED SERVICES MUST BE POSITIVELY IDENTIFIED USING CABLE LOCATORS, GROUND PENETRATING RADAR EQUIPMENT OR POT-HOLING BY HYDRO-EXCAVATION BEFORE ANY HAND OR MECHANICAL EXCAVATIONS ARE UNDERTAKEN. THESE PLANS SHOULD NOT BE RELIED ON FOR LOCATION OF SERVICES OR SERVICE TYPE.
 - NOT ALL BURIED SERVICES ARE SHOWN OR IDENTIFIED.
 - DN REFERS TO NOMINAL INTERNAL PIPE DIAMETER (e.g., DN150mm). OD REFERS TO OUTSIDE DIAMETER FOR HDPE PIPE.
 - PROPOSED LOT BOUNDARIES ARE SUBJECT TO FINAL SURVEY. EXISTING LOT BOUNDARIES ARE SOURCED FROM LINZ DATA SERVICE AND USED IN ACCORDANCE WITH THE INTERNATIONAL CREATIVE COMMONS LICENCE 4.0.
 - ALL DIMENSIONS ARE IN METRES UNLESS STATED OTHERWISE.

- LEGEND**
- DN150 WATER MAIN DN150 (OD180)
 - DN200 WATER MAIN DN200 (OD250)
 - DN375 WATER MAIN DN375 (OD450)
 - w — WATER SUBMAIN (OD63)
 - - - WATER LATERAL
 - FH FIRE HYDRANT
 - ⋈ VALVE
 - M WATER METER
 - ⊙ STREET LIGHT
 - SW — STORMWATER MAIN
 - - - STORMWATER LATERAL
 - STORMWATER MANHOLE
 - STORMWATER SUMP
 - SS — WASTE WATER MAIN
 - - - WASTE WATER LATERAL
 - WASTE WATER MANHOLE

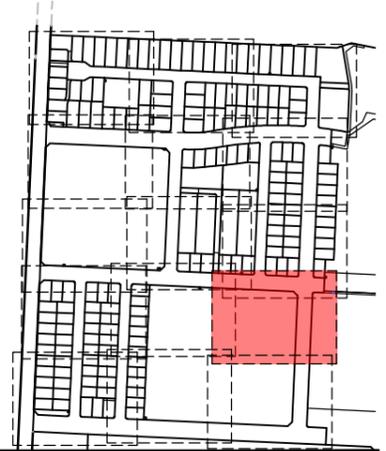

4001



Rev#	Description	Drawn	Date
1	UPDATED INFORMATION ADDED	LB	24.09.25
0	FOR AS-BUILT	AMcC	04.09.25

INOVO
 Level 1, 93 Manchester St, Christchurch 8022
 Ph. 03 377 3290
 Level 1, Shed 19, Princess Wharf, Auckland 1010
 Ph. 09 600 1099
 www.inovo.nz

Scale A1
1:250
Scale A3
1:500
DO NOT SCALE FROM DRAWING


Drawn
AMcC
Approved
TMcL
Date
04.09.25

Client
EARLSBROOK
 LINCOLN

Project
EARLSBROOK
RESIDENTIAL SUBDIVISION
STAGE 1

Drawing Title
WATER SERVICE AS-BUILT
STAGE 1
SHEET 12

Status
AS-BUILT
SEPT 2025
 Drawing No.
15721-S1-AB-6012 Rev
 1

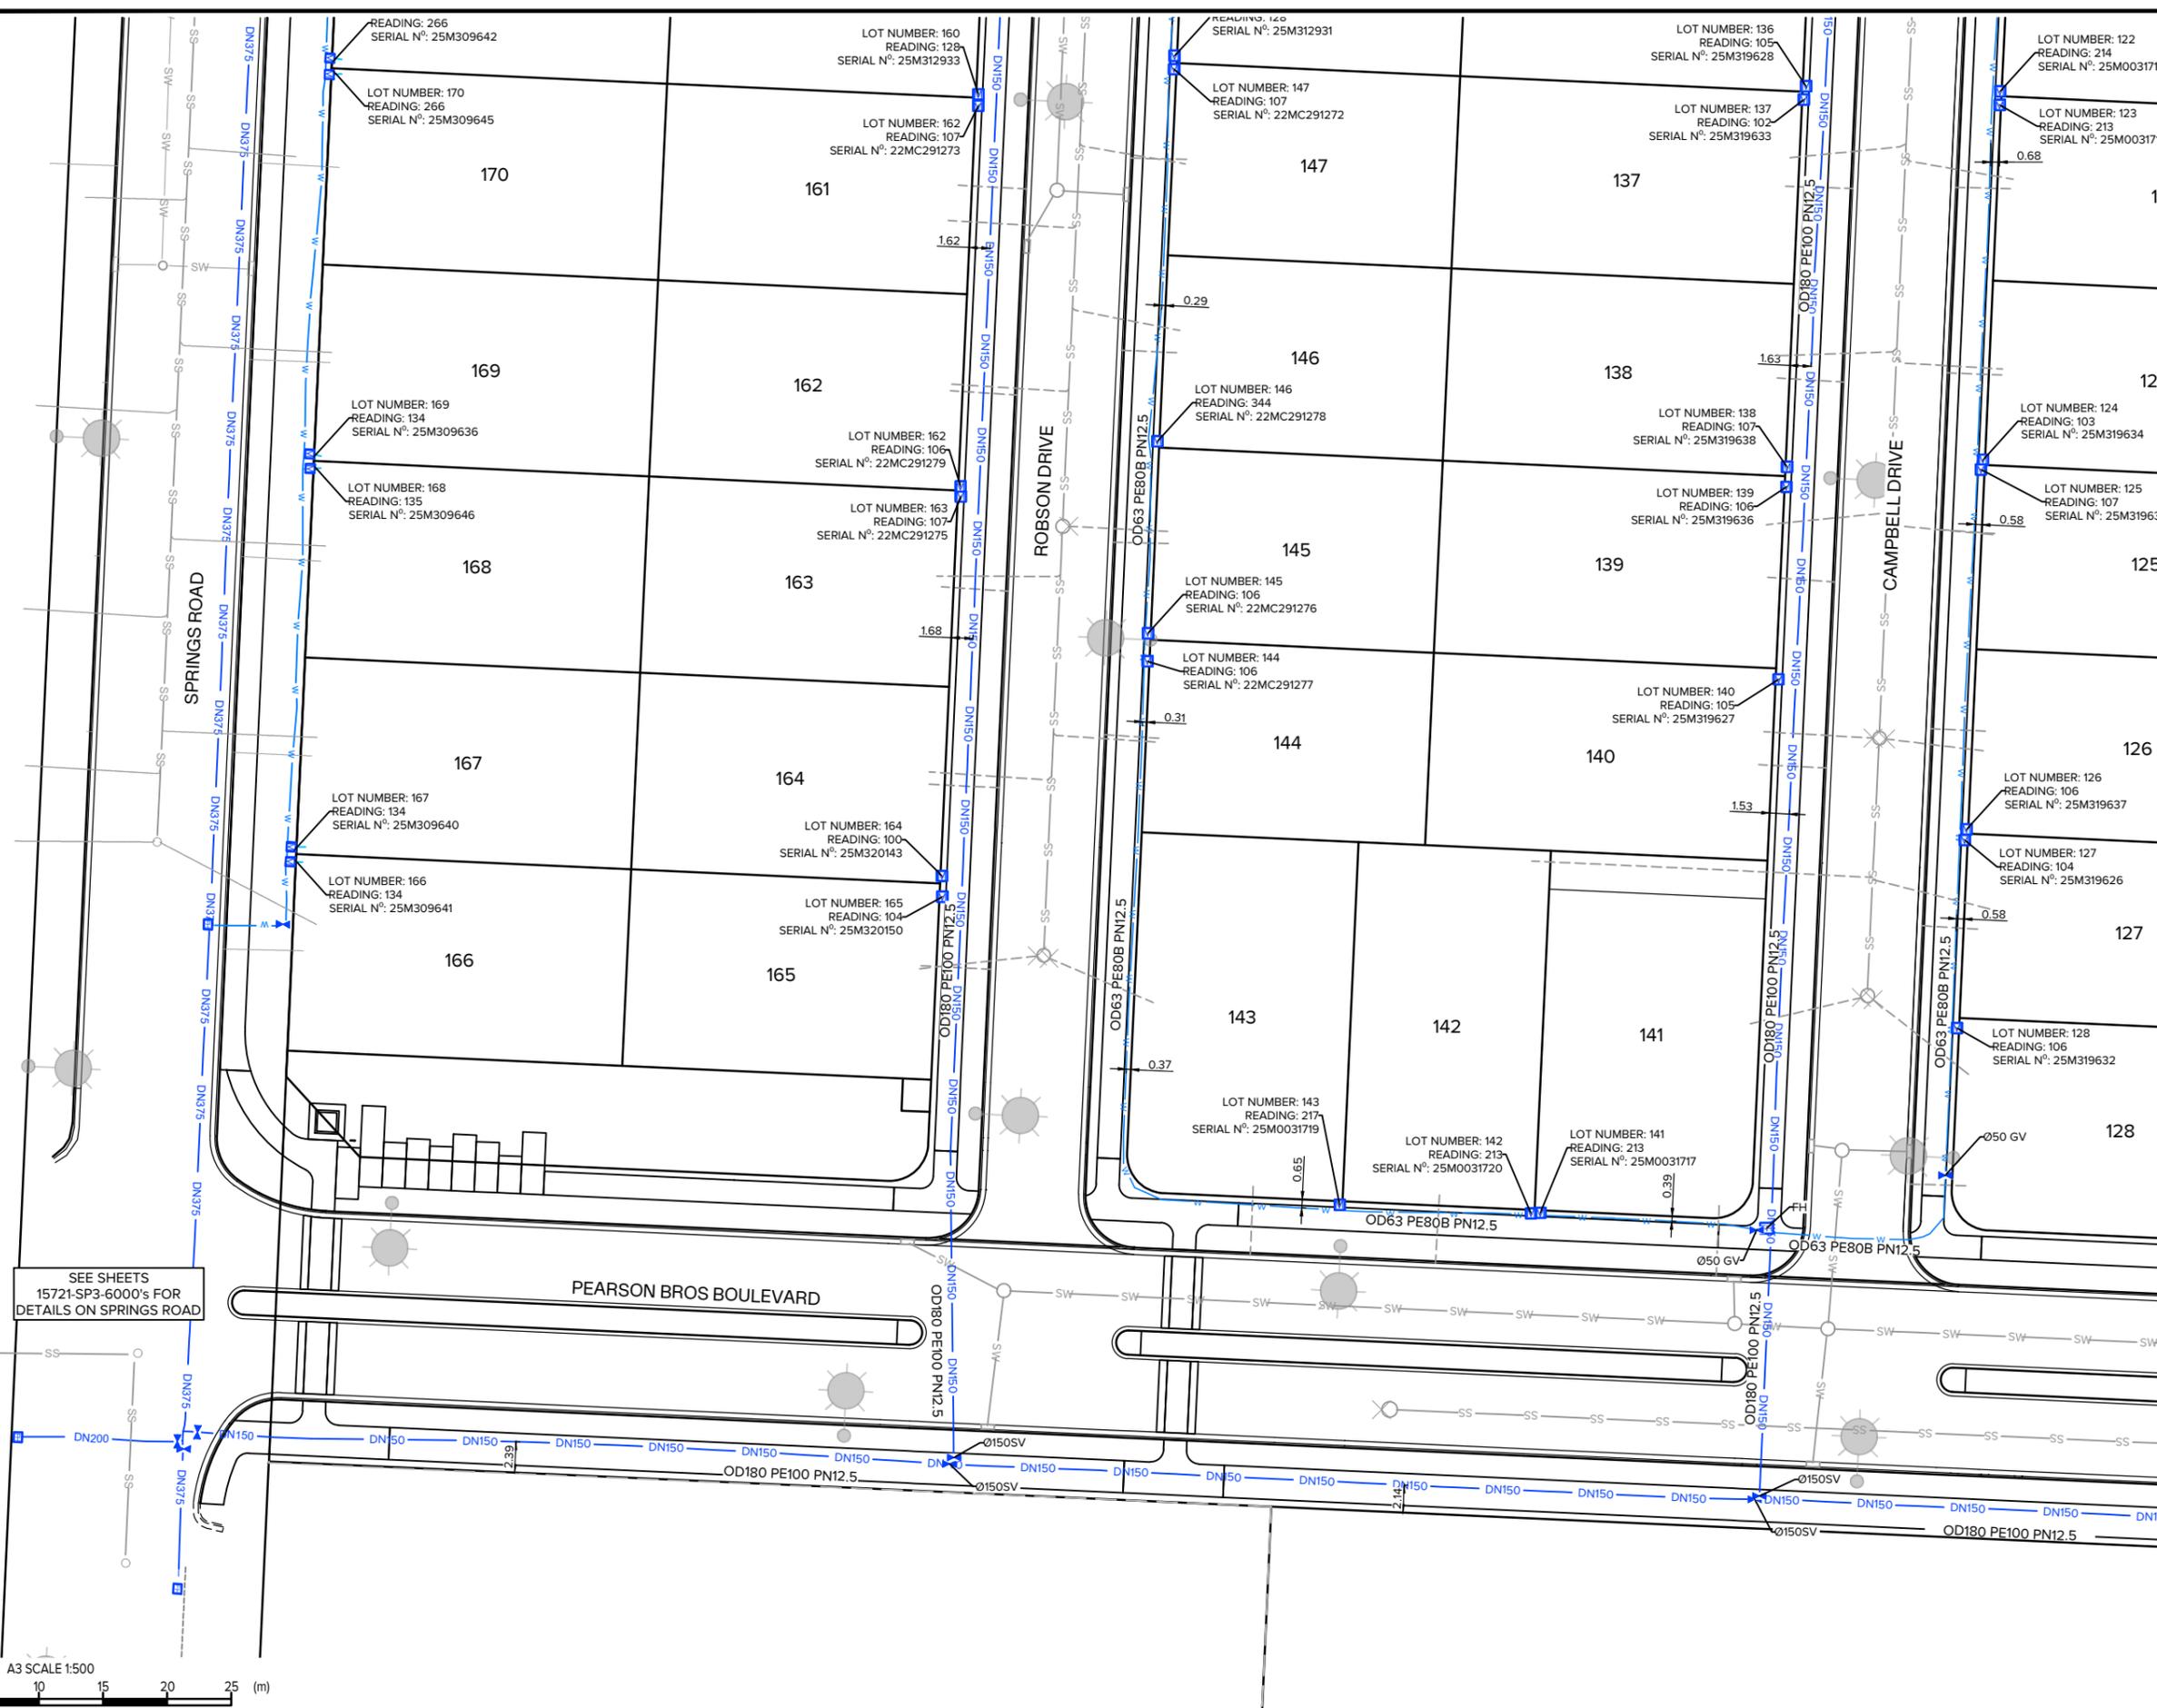

- NOTES**
- AS-BUILT SERVICES DATA HAS BEEN CAPTURED BY GPS SURVEY PRIOR TO BACKFILLING & TRACING OF SERVICES FROM UAV IMAGERY CAPTURED DURING CONSTRUCTION BY MAUGERS CONTRACTING LTD.
 - ALL BURIED SERVICES MUST BE POSITIVELY IDENTIFIED USING CABLE LOCATORS, GROUND PENETRATING RADAR EQUIPMENT OR POT-HOLING BY HYDRO-EXCAVATION BEFORE ANY HAND OR MECHANICAL EXCAVATIONS ARE UNDERTAKEN. THESE PLANS SHOULD NOT BE RELIED ON FOR LOCATION OF SERVICES OR SERVICE TYPE.
 - NOT ALL BURIED SERVICES ARE SHOWN OR IDENTIFIED.
 - DN REFERS TO NOMINAL INTERNAL PIPE DIAMETER (e.g., DN150mm). OD REFERS TO OUTSIDE DIAMETER FOR HDPE PIPE.
 - PROPOSED LOT BOUNDARIES ARE SUBJECT TO FINAL SURVEY. EXISTING LOT BOUNDARIES ARE SOURCED FROM LINZ DATA SERVICE AND USED IN ACCORDANCE WITH THE INTERNATIONAL CREATIVE COMMONS LICENCE 4.0.
 - ALL DIMENSIONS ARE IN METRES UNLESS STATED OTHERWISE.

- LEGEND**
- DN150 WATER MAIN DN150 (OD180)
 - DN200 WATER MAIN DN200 (OD250)
 - DN375 WATER MAIN DN375 (OD450)
 - w w WATER SUBMAIN (OD63)
 - WATER LATERAL
 - FH FIRE HYDRANT
 - V VALVE
 - M WATER METER
 - SL STREET LIGHT
 - SW SW STORMWATER MAIN
 - STORMWATER LATERAL
 - STORMWATER MANHOLE
 - ◇ STORMWATER SUMP
 - SS SS WASTE WATER MAIN
 - WASTE WATER LATERAL
 - WASTE WATER MANHOLE

SEE SHEETS 15721-SP3-6000's FOR DETAILS ON SPRINGS ROAD



Rev#	Description	Drawn	Date
1	UPDATED INFORMATION ADDED	LB	24.09.25
0	FOR AS-BUILT	AMcC	04.09.25



Level 1, 93 Manchester St, Christchurch 8022
 Ph. 03 377 3290
 Level 1, Shed 19, Princess Wharf, Auckland 1010
 Ph. 09 600 1099
 www.inovo.nz

Scale A1 1:250
 Scale A3 1:500
 DO NOT SCALE FROM DRAWING


Drawn AMcC
 Approved TMCL
 Date 04.09.25



Project **EARLSBROOK RESIDENTIAL SUBDIVISION STAGE 1**

Drawing Title **WATER SERVICE AS-BUILT STAGE 1 SHEET 13**

Status **AS-BUILT SEPT 2025**
 Drawing No. **15721-S1-AB-6013** Rev 1

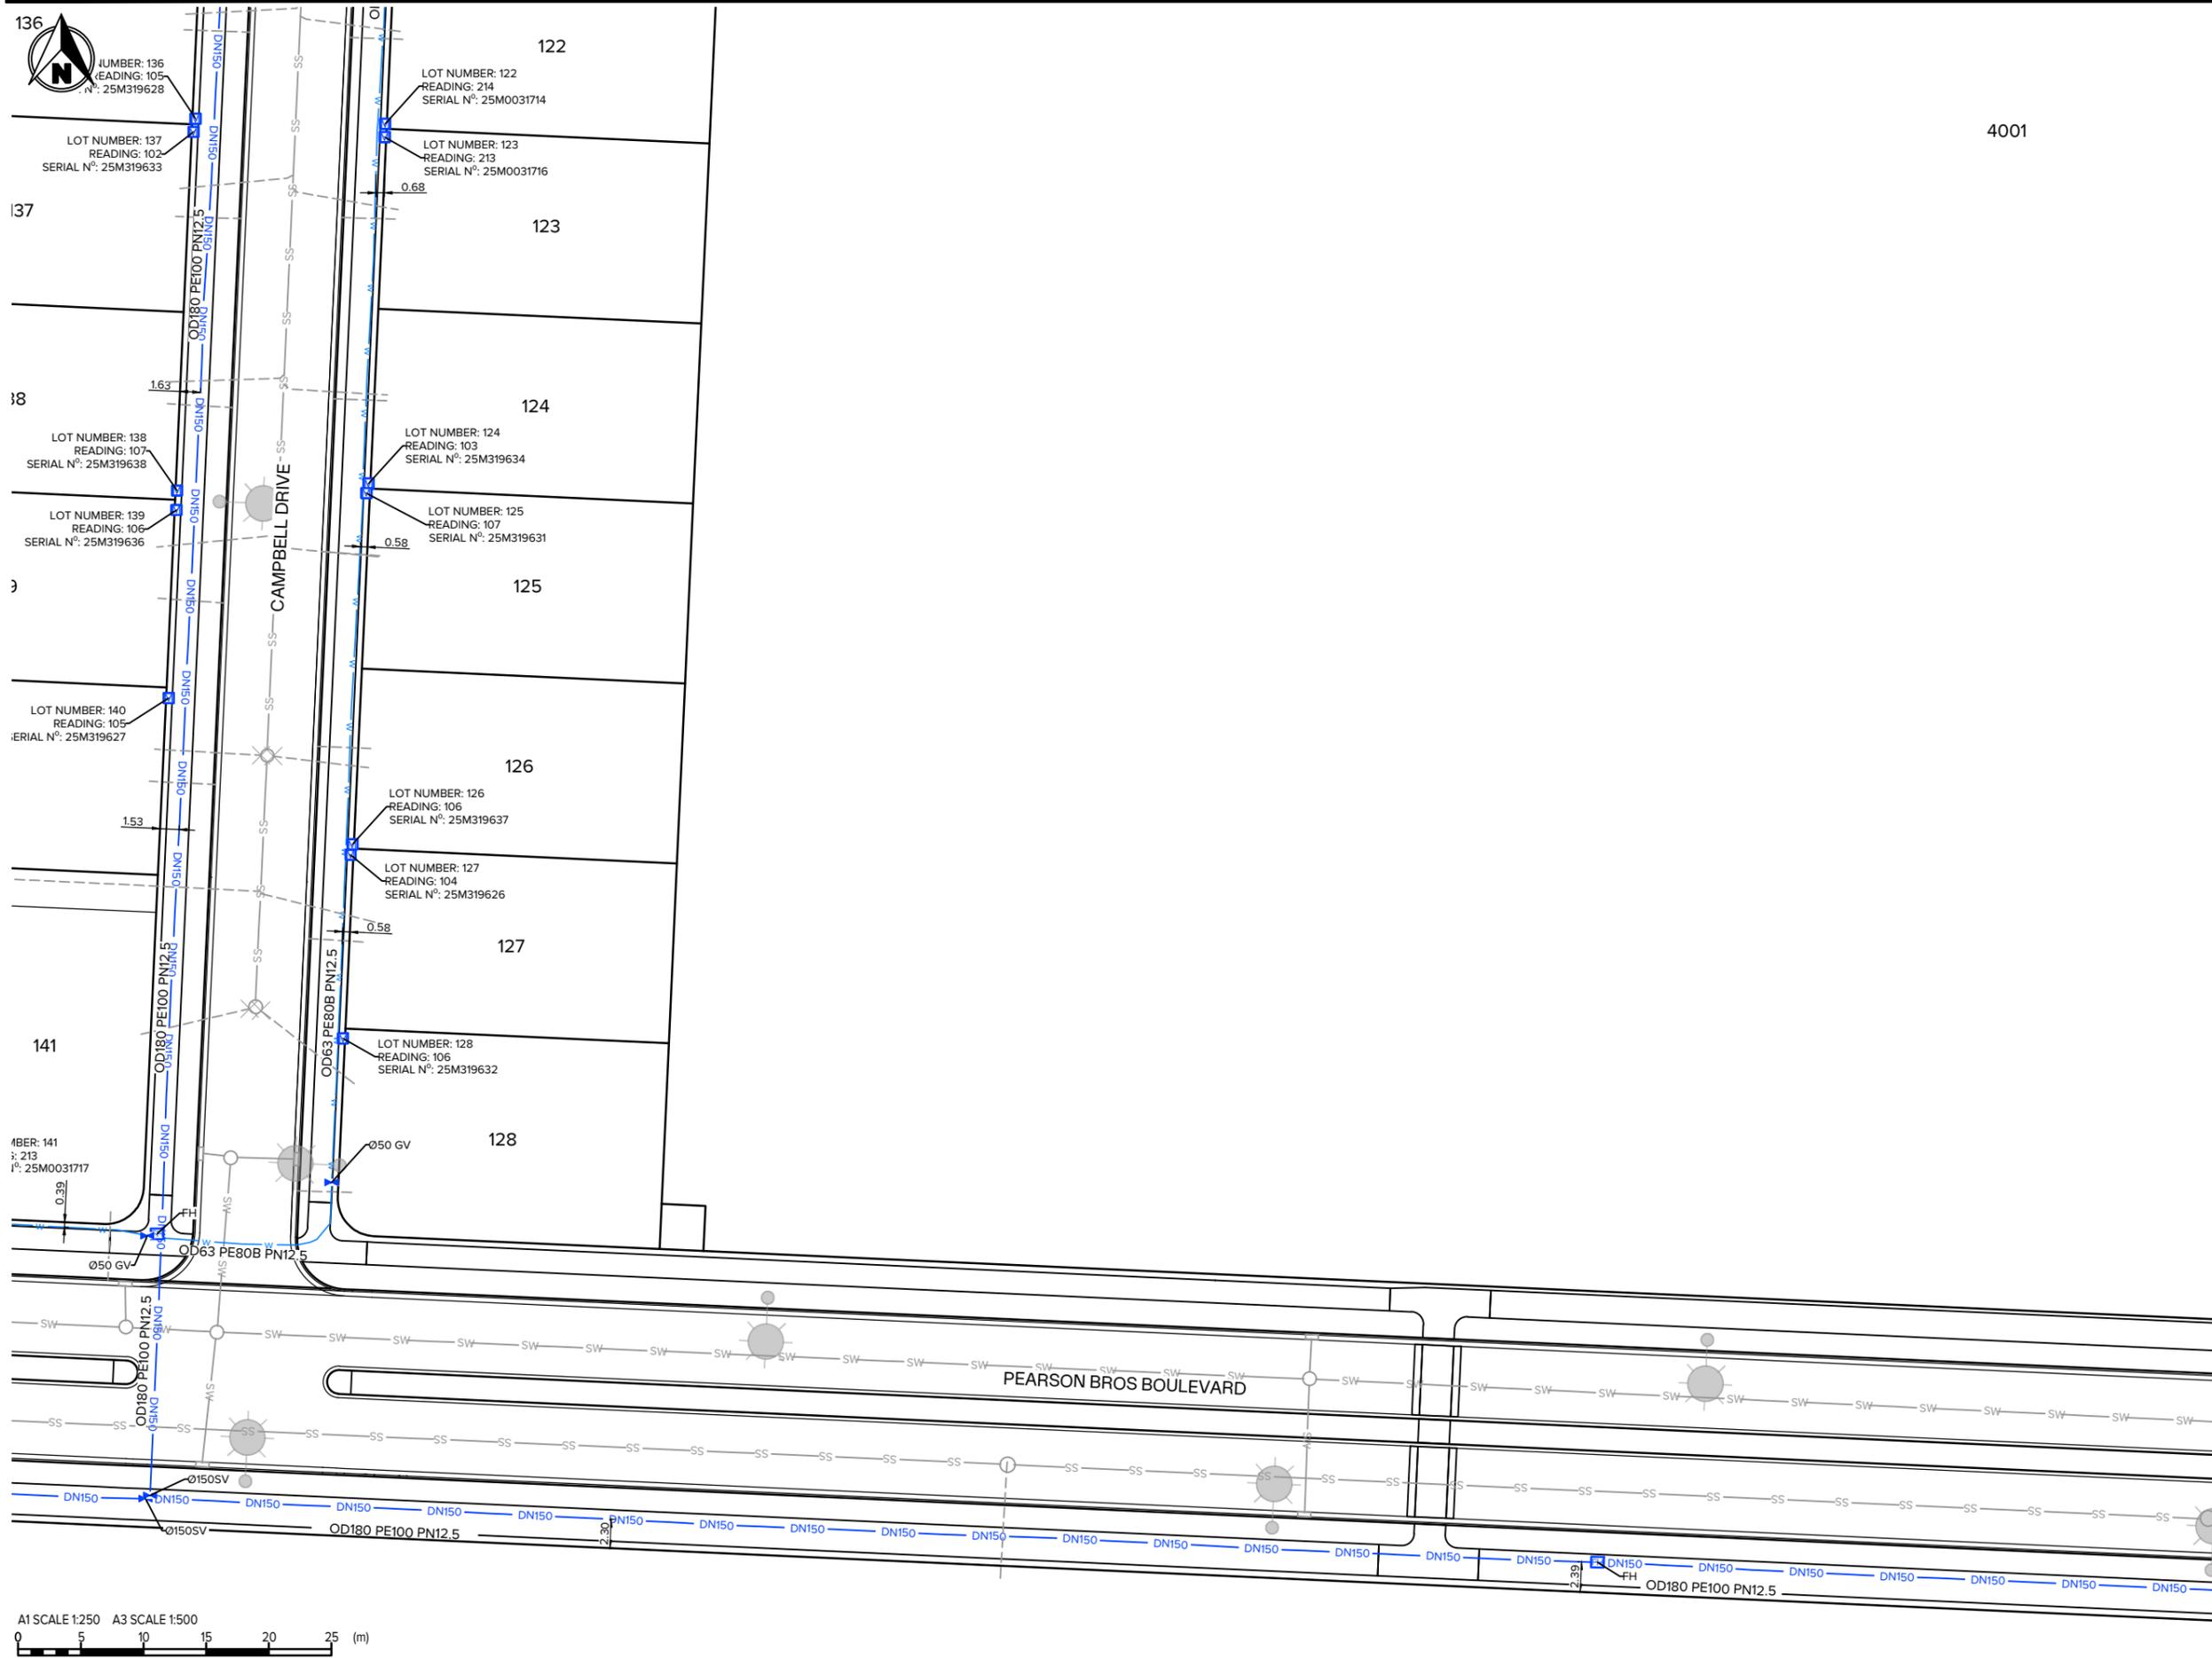

4001

- ### NOTES
- AS-BUILT SERVICES DATA HAS BEEN CAPTURED BY GPS SURVEY PRIOR TO BACKFILLING & TRACING OF SERVICES FROM UAV IMAGERY CAPTURED DURING CONSTRUCTION BY MAUGERS CONTRACTING LTD.
 - ALL BURIED SERVICES MUST BE POSITIVELY IDENTIFIED USING CABLE LOCATORS, GROUND PENETRATING RADAR EQUIPMENT OR POT-HOLING BY HYDRO-EXCAVATION BEFORE ANY HAND OR MECHANICAL EXCAVATIONS ARE UNDERTAKEN. THESE PLANS SHOULD NOT BE RELIED ON FOR LOCATION OF SERVICES OR SERVICE TYPE.
 - NOT ALL BURIED SERVICES ARE SHOWN OR IDENTIFIED.
 - DN REFERS TO NOMINAL INTERNAL PIPE DIAMETER (e.g., DN150mm). OD REFERS TO OUTSIDE DIAMETER FOR HDPE PIPE.
 - PROPOSED LOT BOUNDARIES ARE SUBJECT TO FINAL SURVEY. EXISTING LOT BOUNDARIES ARE SOURCED FROM LINZ DATA SERVICE AND USED IN ACCORDANCE WITH THE INTERNATIONAL CREATIVE COMMONS LICENCE 4.0.
 - ALL DIMENSIONS ARE IN METRES UNLESS STATED OTHERWISE.

- ### LEGEND
- DN150 WATER MAIN DN150 (OD180)
 - DN200 WATER MAIN DN200 (OD250)
 - DN375 WATER MAIN DN375 (OD450)
 - w WATER SUBMAIN (OD63)
 - WATER LATERAL
 - FH FIRE HYDRANT
 - V VALVE
 - M WATER METER
 - SL STREET LIGHT
 - SW SW STORMWATER MAIN
 - SW STORMWATER LATERAL
 - SW STORMWATER MANHOLE
 - ◇ SW STORMWATER SUMP
 - SS SS WASTE WATER MAIN
 - SS WASTE WATER LATERAL
 - SS WASTE WATER MANHOLE



Rev#	Description	Drawn	Date
1	UPDATED INFORMATION ADDED	LB	24.09.25
0	FOR AS-BUILT	AMcC	04.09.25

INOVO
 Level 1, 93 Manchester St, Christchurch 8022
 Ph. 03 377 3290
 Level 1, Shed 19, Princess Wharf, Auckland 1010
 Ph. 09 600 1099
 www.inovo.nz

Scale A1
1:250
Scale A3
1:500
DO NOT SCALE FROM DRAWING

Drawn
AMcC
Approved
TMcL
Date
04.09.25

Client
EARLSBROOK
LINCOLN

Project
EARLSBROOK RESIDENTIAL SUBDIVISION STAGE 1

Drawing Title
WATER SERVICE AS-BUILT STAGE 1 SHEET 14

Status
AS-BUILT SEPT 2025

Drawing No.
15721-S1-AB-6014

Rev
1




NOTES

- AS-BUILT SERVICES DATA HAS BEEN CAPTURED BY GPS SURVEY PRIOR TO BACKFILLING & TRACING OF SERVICES FROM UAV IMAGERY CAPTURED DURING CONSTRUCTION BY MAUGERS CONTRACTING LTD.
- ALL BURIED SERVICES MUST BE POSITIVELY IDENTIFIED USING CABLE LOCATORS, GROUND PENETRATING RADAR EQUIPMENT OR POT-HOLING BY HYDRO-EXCAVATION BEFORE ANY HAND OR MECHANICAL EXCAVATIONS ARE UNDERTAKEN. THESE PLANS SHOULD NOT BE RELIED ON FOR LOCATION OF SERVICES OR SERVICE TYPE.
- NOT ALL BURIED SERVICES ARE SHOWN OR IDENTIFIED.
- DN REFERS TO NOMINAL INTERNAL PIPE DIAMETER (e.g., DN150mm). OD REFERS TO OUTSIDE DIAMETER FOR HDPE PIPE.
- PROPOSED LOT BOUNDARIES ARE SUBJECT TO FINAL SURVEY. EXISTING LOT BOUNDARIES ARE SOURCED FROM LINZ DATA SERVICE AND USED IN ACCORDANCE WITH THE INTERNATIONAL CREATIVE COMMONS LICENCE 4.0.
- ALL DIMENSIONS ARE IN METRES UNLESS STATED OTHERWISE.

LEGEND

- DN150 WATER MAIN DN150 (OD180)
- DN200 WATER MAIN DN200 (OD250)
- DN375 WATER MAIN DN375 (OD450)
- w w WATER SUBMAIN (OD63)
- WATER LATERAL
- FIRE HYDRANT
- VALVE
- WATER METER
- STREET LIGHT
- STORMWATER MAIN
- STORMWATER LATERAL
- STORMWATER MANHOLE
- STORMWATER SUMP
- WASTE WATER MAIN
- WASTE WATER LATERAL
- WASTE WATER MANHOLE

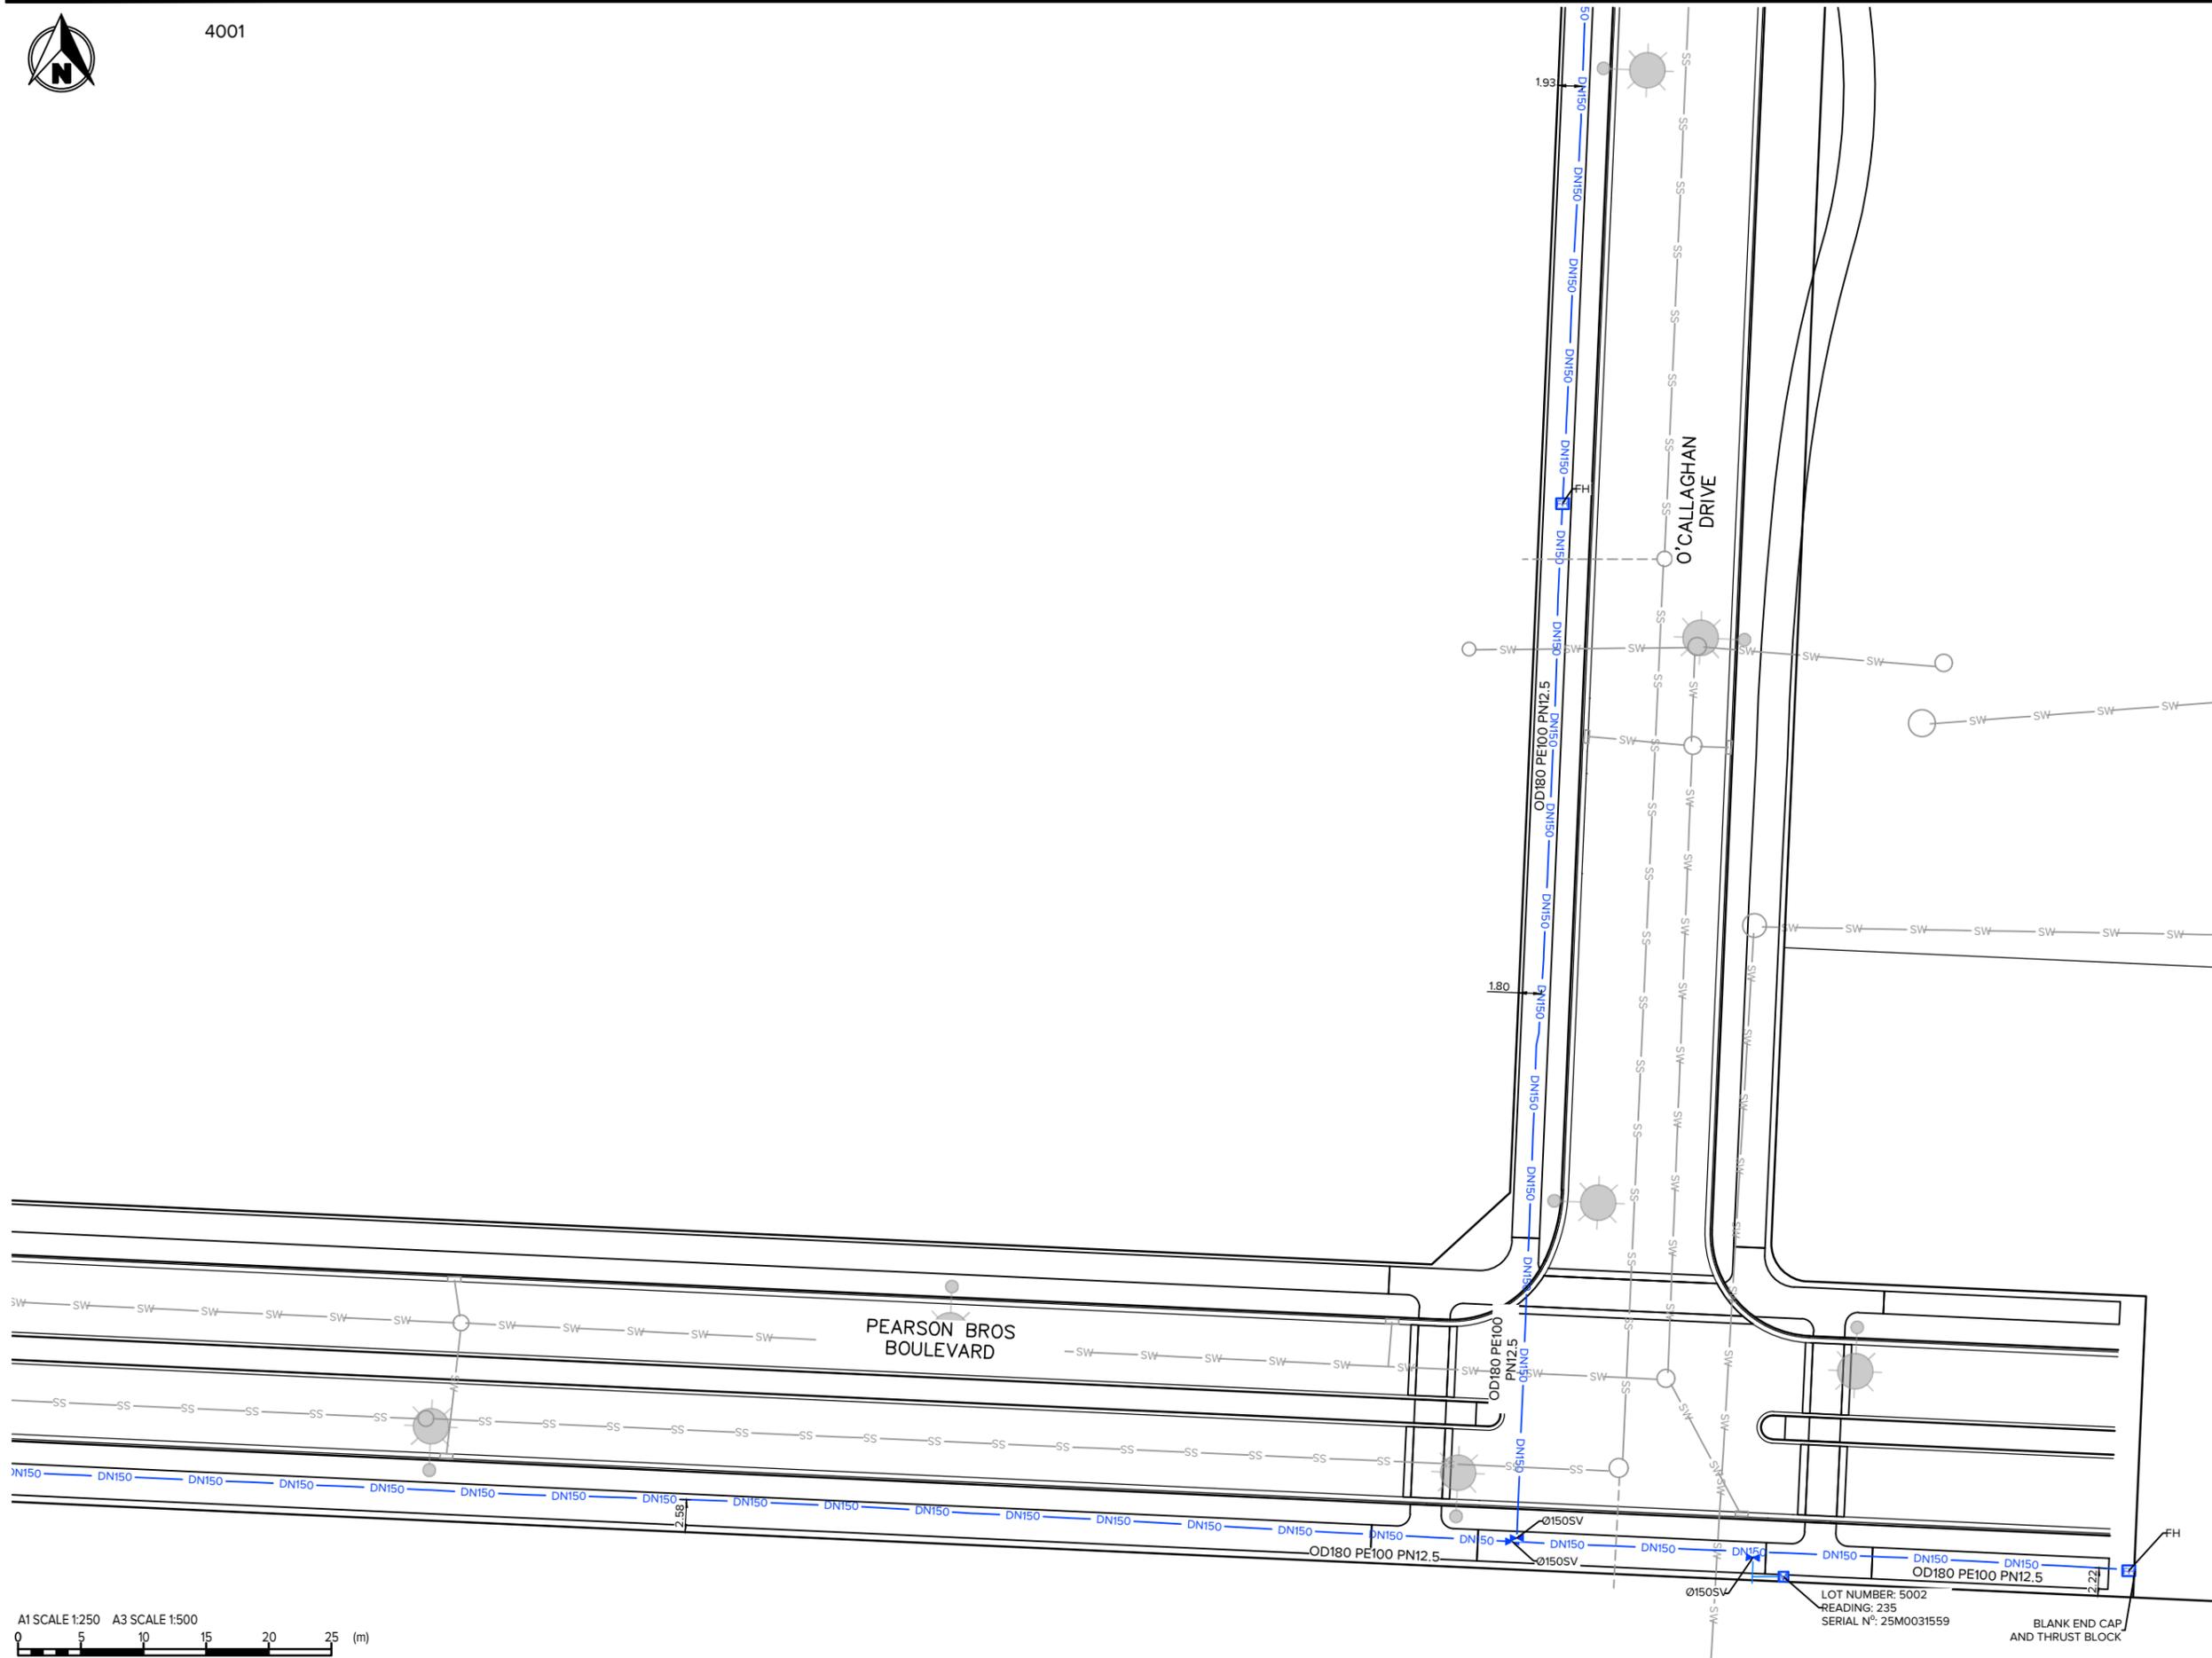

Rev#	Description	Drawn	Date
1	UPDATED INFORMATION ADDED	LB	24.09.25
0	FOR AS-BUILT	AMcC	04.09.25

INNO
 Level 1, 93 Manchester St, Christchurch 8022
 Ph. 03 377 3290
 Level 1, Shed 19, Princess Wharf, Auckland 1010
 Ph. 09 600 1099
 www.inovo.nz

Scale A1
1:250
 Scale A3
1:500
 DO NOT SCALE FROM DRAWING

Drawn
AMcC
 Approved
TMcL
 Date
04.09.25


Client

EARLSBROOK
 LINCOLN

Project
EARLSBROOK RESIDENTIAL SUBDIVISION
STAGE 1

Drawing Title
WATER SERVICE AS-BUILT
STAGE 1
SHEET 15

Status
AS-BUILT
SEPT 2025
 Drawing No.
15721-S1-AB-6015 Rev
 1

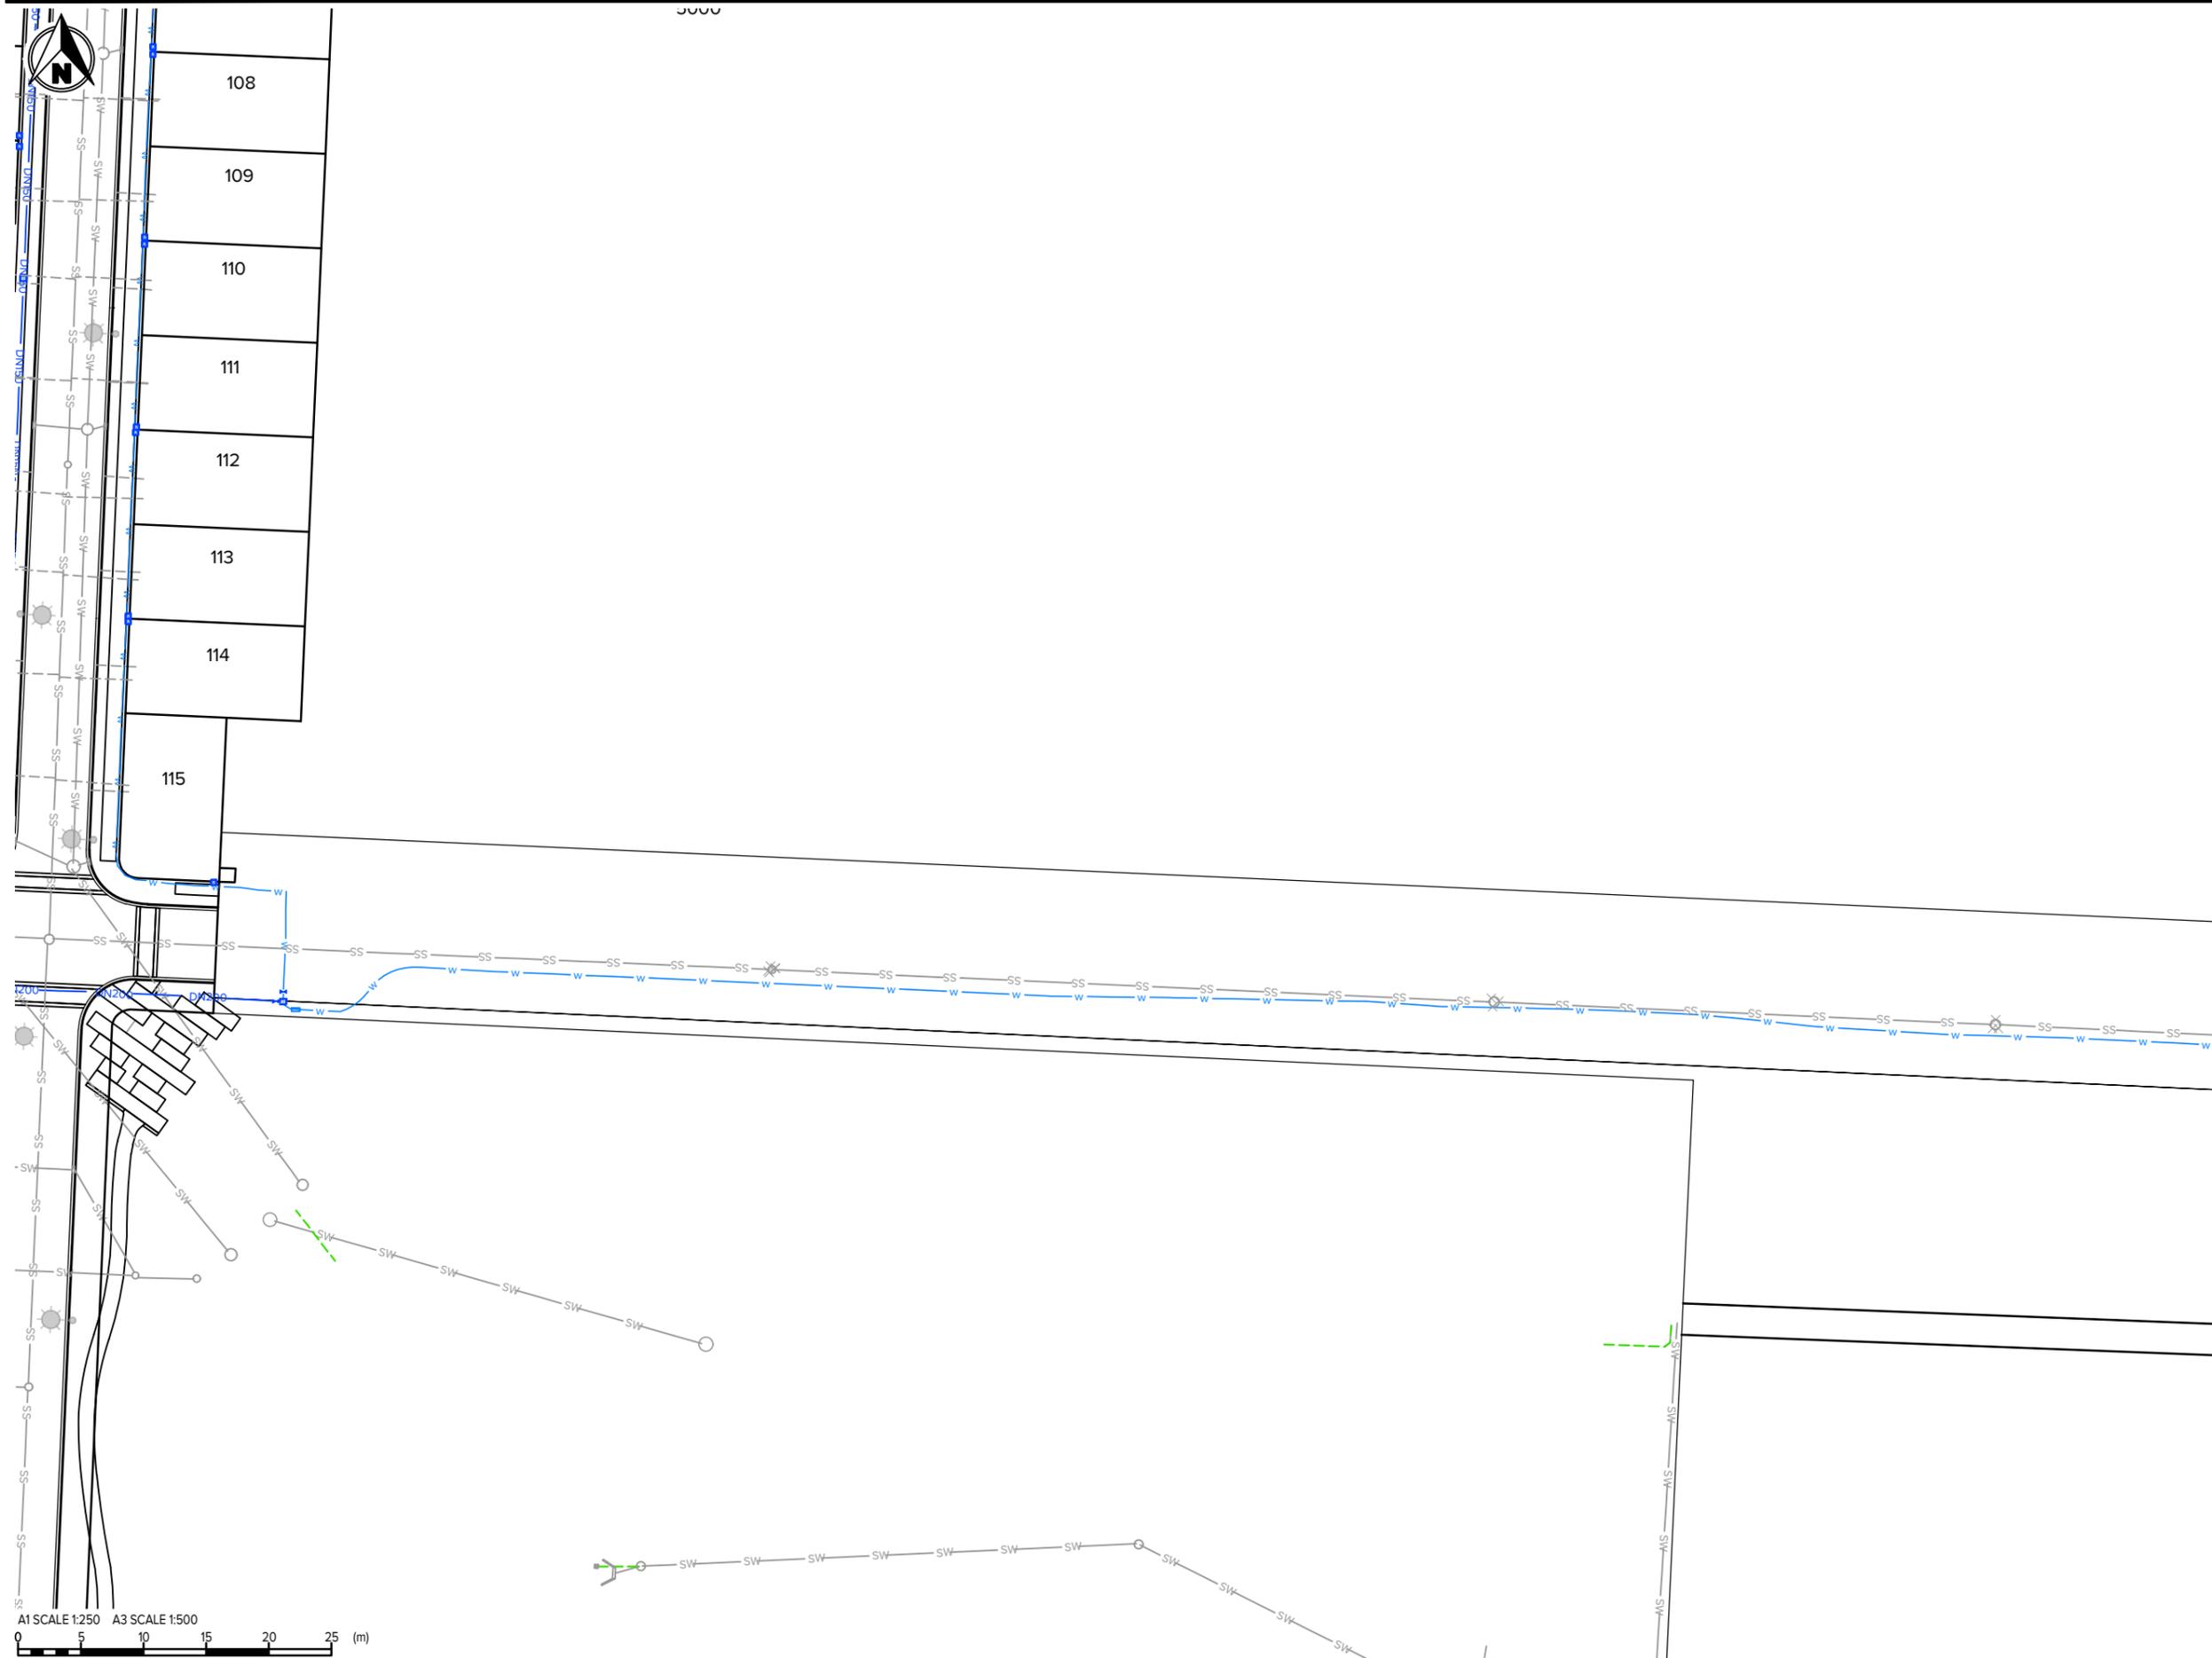

- ### NOTES
- AS-BUILT SERVICES DATA HAS BEEN CAPTURED BY GPS SURVEY PRIOR TO BACKFILLING & TRACING OF SERVICES FROM UAV IMAGERY CAPTURED DURING CONSTRUCTION BY MAUGERS CONTRACTING LTD.
 - ALL BURIED SERVICES MUST BE POSITIVELY IDENTIFIED USING CABLE LOCATORS, GROUND PENETRATING RADAR EQUIPMENT OR POT-HOLING BY HYDRO-EXCAVATION BEFORE ANY HAND OR MECHANICAL EXCAVATIONS ARE UNDERTAKEN. THESE PLANS SHOULD NOT BE RELIED ON FOR LOCATION OF SERVICES OR SERVICE TYPE.
 - NOT ALL BURIED SERVICES ARE SHOWN OR IDENTIFIED.
 - DN REFERS TO NOMINAL INTERNAL PIPE DIAMETER (e.g., DN150mm). OD REFERS TO OUTSIDE DIAMETER FOR HDPE PIPE.
 - PROPOSED LOT BOUNDARIES ARE SUBJECT TO FINAL SURVEY. EXISTING LOT BOUNDARIES ARE SOURCED FROM LINZ DATA SERVICE AND USED IN ACCORDANCE WITH THE INTERNATIONAL CREATIVE COMMONS LICENCE 4.0.
 - ALL DIMENSIONS ARE IN METRES UNLESS STATED OTHERWISE.

- ### LEGEND
- DN150 WATER MAIN DN150 (OD180)
 - DN200 WATER MAIN DN200 (OD250)
 - DN375 WATER MAIN DN375 (OD450)
 - w- WATER SUBMAIN (OD63)
 - - - WATER LATERAL
 - FIRE HYDRANT
 - VALVE
 - WATER METER
 - STREET LIGHT
 - SW- STORMWATER MAIN
 - - - STORMWATER LATERAL
 - STORMWATER MANHOLE
 - STORMWATER SUMP
 - SS- WASTE WATER MAIN
 - - - WASTE WATER LATERAL
 - WASTE WATER MANHOLE

A1 SCALE 1:250 A3 SCALE 1:500
 0 5 10 15 20 25 (m)

Rev#	Description	Drawn	Date
1	UPDATED INFORMATION ADDED	LB	24.09.25
0	FOR AS-BUILT	AMcC	01.09.25

INNO
 Level 1, 93 Manchester St, Christchurch 8022
 Ph. 03 377 3290
 Level 1, Shed 19, Princess Wharf, Auckland 1010
 Ph. 09 600 1099
 www.inovo.nz

Scale A1
1:500
 Scale A3
1:1,000
 DO NOT SCALE FROM DRAWING

Drawn
AMcC
 Approved
TMCL
 Date
01.09.25

Client
EARLSBROOK
LINCOLN

Project
EARLSBROOK
RESIDENTIAL SUBDIVISION
STAGE 1

Drawing Title
WATER SERVICE AS-BUILT
STAGE 1
SHEET 16

Status
AS-BUILT
SEPT 2025
 Drawing No.
15721-S1-AB-6016 Rev
1




NOTES

1. AS-BUILT SERVICES DATA HAS BEEN CAPTURED BY GPS SURVEY PRIOR TO BACKFILLING & TRACING OF SERVICES FROM UAV IMAGERY CAPTURED DURING CONSTRUCTION BY MAUGERS CONTRACTING LTD.
2. ALL BURIED SERVICES MUST BE POSITIVELY IDENTIFIED USING CABLE LOCATORS, GROUND PENETRATING RADAR EQUIPMENT OR POT-HOLING BY HYDRO-EXCAVATION OR MECHANICAL EXCAVATIONS ARE UNDERTAKEN. THESE PLANS SHOULD NOT BE RELIED ON FOR LOCATION OF SERVICES OR SERVICE TYPE.
3. NOT ALL BURIED SERVICES ARE SHOWN OR IDENTIFIED.
4. DN REFERS TO NOMINAL INTERNAL PIPE DIAMETER (e.g., DN150mm). OD REFERS TO OUTSIDE DIAMETER FOR HDPE PIPE.
5. PROPOSED LOT BOUNDARIES ARE SUBJECT TO FINAL SURVEY. EXISTING LOT BOUNDARIES ARE SOURCED FROM LINZ DATA SERVICE AND USED IN ACCORDANCE WITH THE INTERNATIONAL CREATIVE COMMONS LICENCE 4.0.
6. ALL DIMENSIONS ARE IN METRES UNLESS STATED OTHERWISE.

LEGEND

- DN150 — WATER MAIN DN150 (OD180)
- DN200 — WATER MAIN DN200 (OD250)
- DN375 — WATER MAIN DN375 (OD450)
- w — w — WATER SUBMAIN (OD63)
- - - - WATER LATERAL
- ⊕ FIRE HYDRANT
- ⋈ VALVE
- Ⓜ WATER METER
- ⊙ STREET LIGHT
- SW — SW — STORMWATER MAIN
- - - - STORMWATER LATERAL
- STORMWATER MANHOLE
- ◊ STORMWATER SUMP
- SS — SS — WASTE WATER MAIN
- - - - WASTE WATER LATERAL
- WASTE WATER MANHOLE

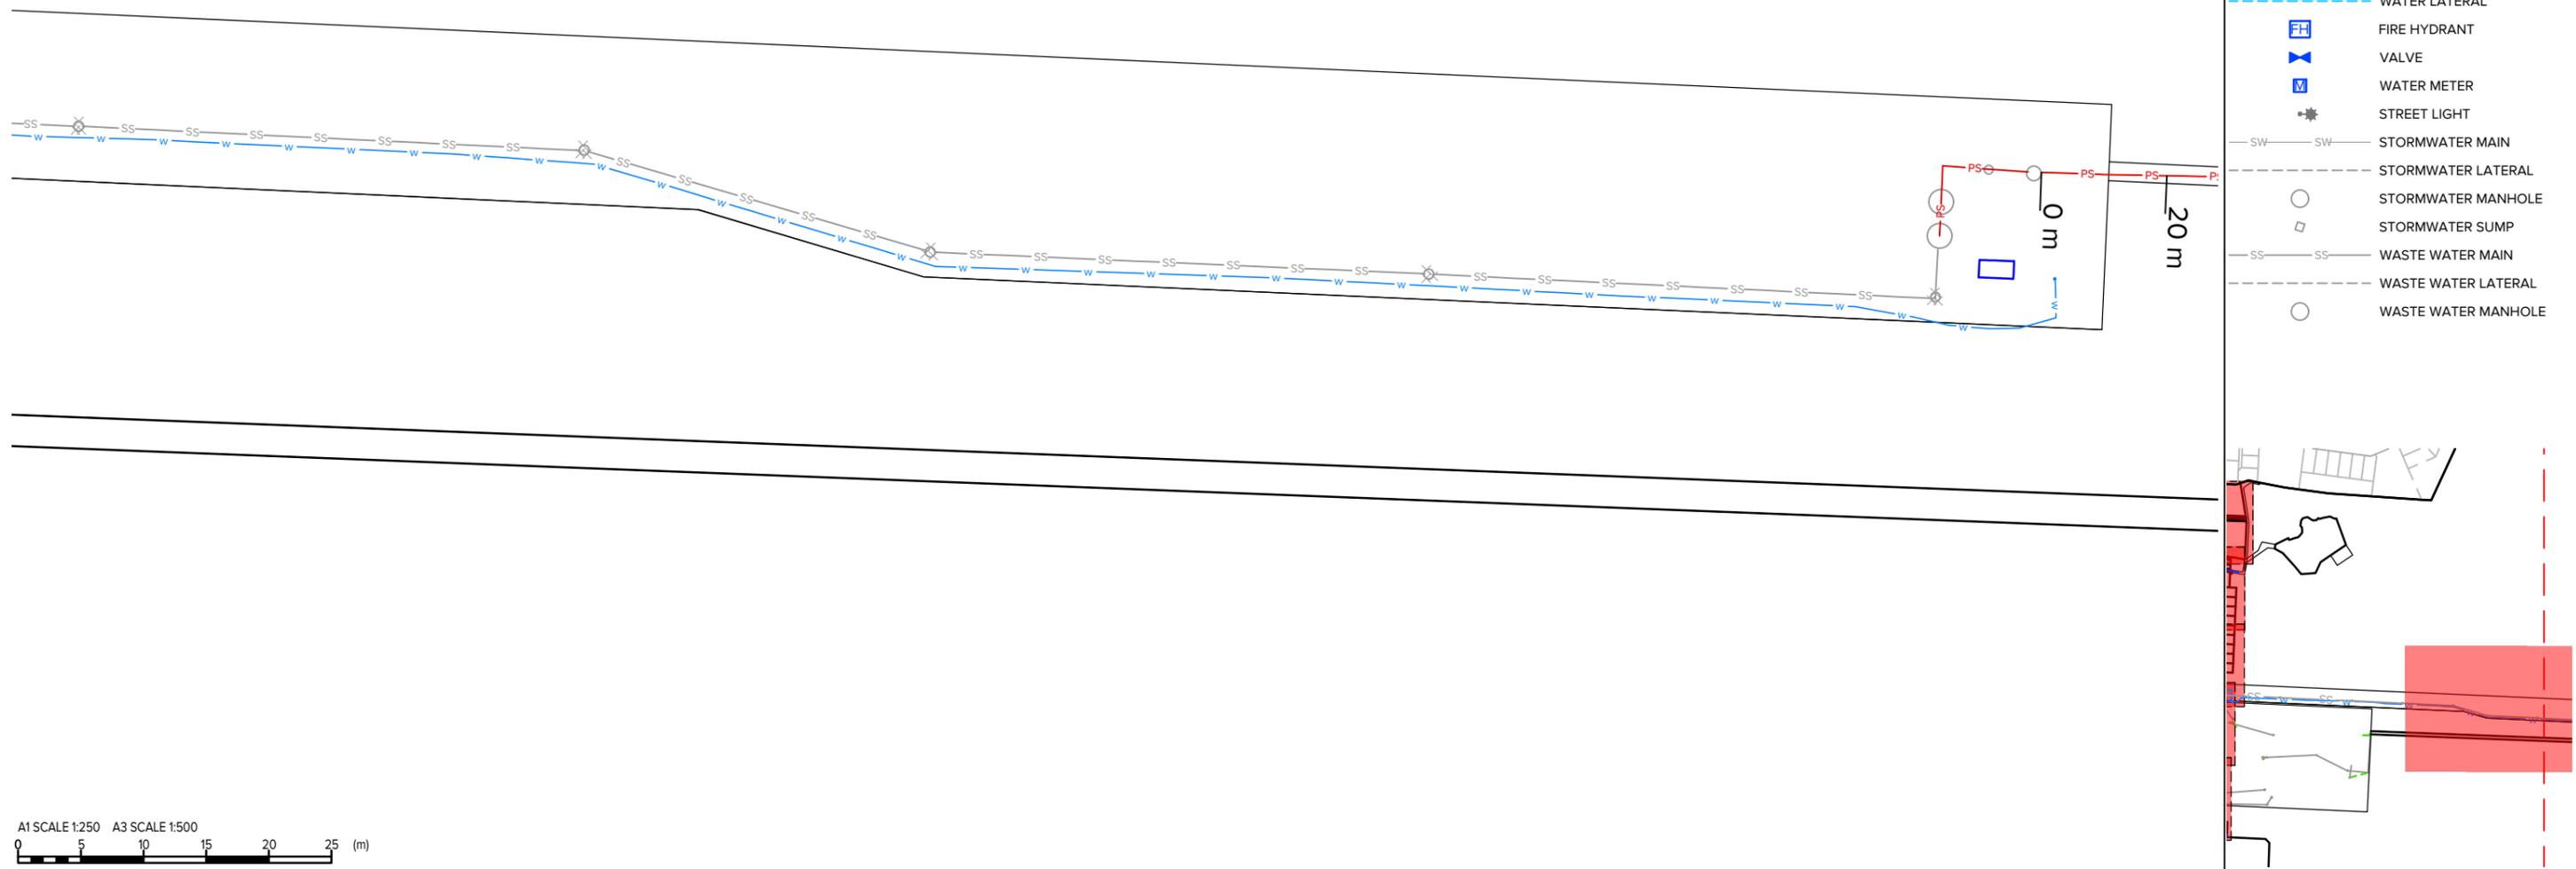

Rev#	Description	Drawn	Date
1	UPDATED INFORMATION ADDED	LB	24.09.25
0	FOR AS-BUILT	AMcC	01.09.25

INOVO
 Level 1, 93 Manchester St, Christchurch 8022
 Ph. 03 377 3290
 Level 1, Shed 19, Princess Wharf, Auckland 1010
 Ph. 09 600 1099
 www.inovo.nz

Scale A1
1:500
 Scale A3
1:1,000
 DO NOT SCALE FROM DRAWING

Drawn
AMcC
 Approved
TMcL
 Date
01.09.25

Client
EARLSBROOK
 LINCOLN

Project
EARLSBROOK
RESIDENTIAL SUBDIVISION
STAGE 1

Drawing Title
WATER SERVICE AS-BUILT
STAGE 1
SHEET 17

Status
AS-BUILT
SEPT 2025
 Drawing No.
15721-S1-AB-6017 Rev
 1